

GUARD RAIL REQUIRED ON RIGHT

Sta 0+52	To 1+08	56 ft
- 4+63	- 4+87	24 -
- 9+95	- 10+19	24 -
Total This Sheet		104 ft



NEW CULVERTS REQUIRED

Sta 4+02	18" Concrete pipe 1130 ft
	1-2%+5 Concrete 13 cu yds
Sta 10+10	24" Concrete pipe 28 ft
	1-2%+5 Concrete 0.6 cu yds

CURBING REQUIRED ON RIGHT

Sta 0+00 to Sta 0+35	1-2% Concrete	0.9 cu yds
----------------------	---------------	------------

REVISED	DATE	BY	REASON
0	11/22	RE	3 41

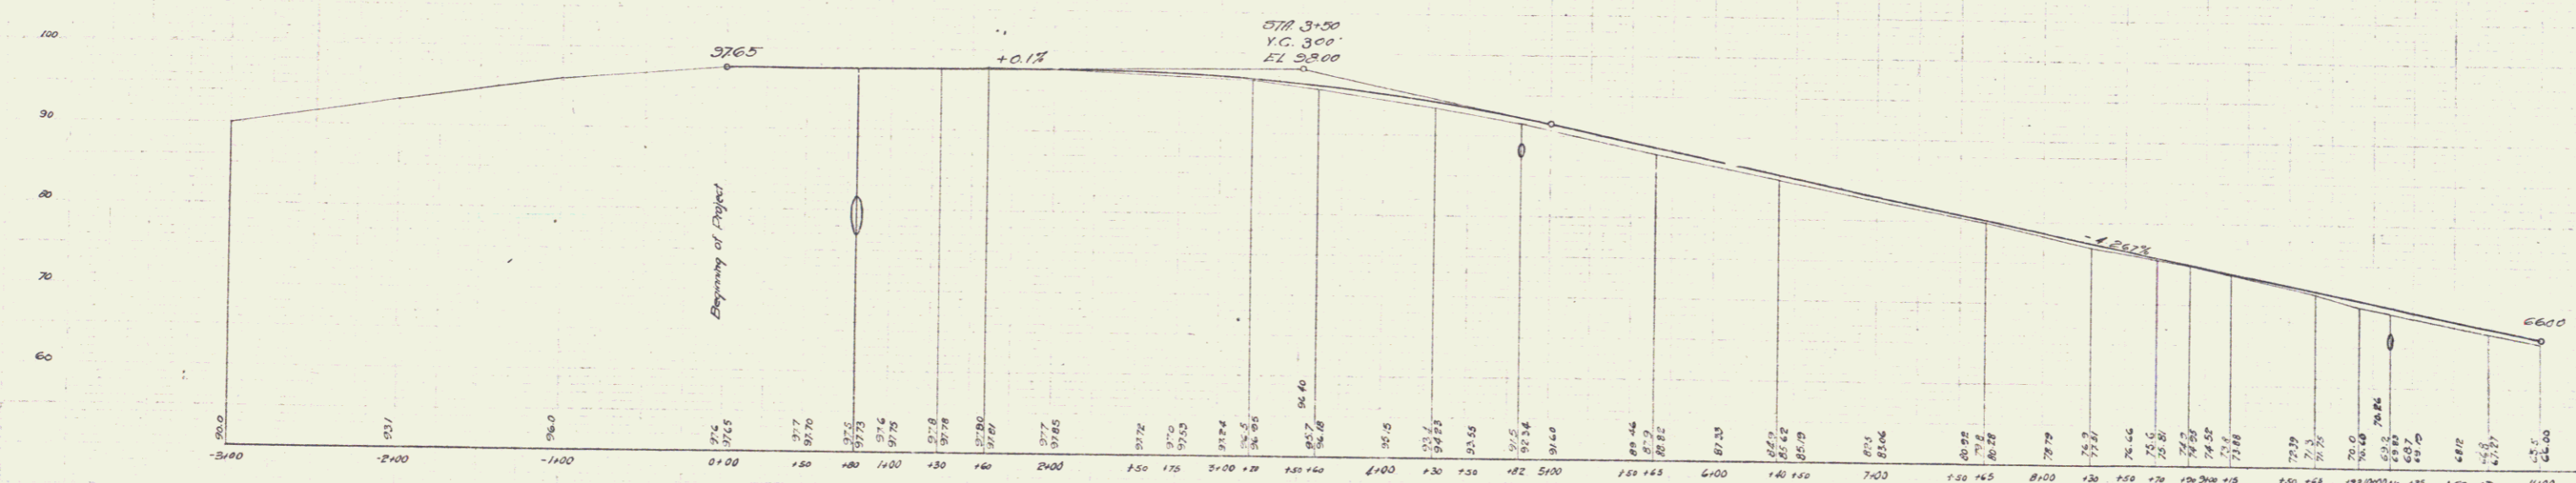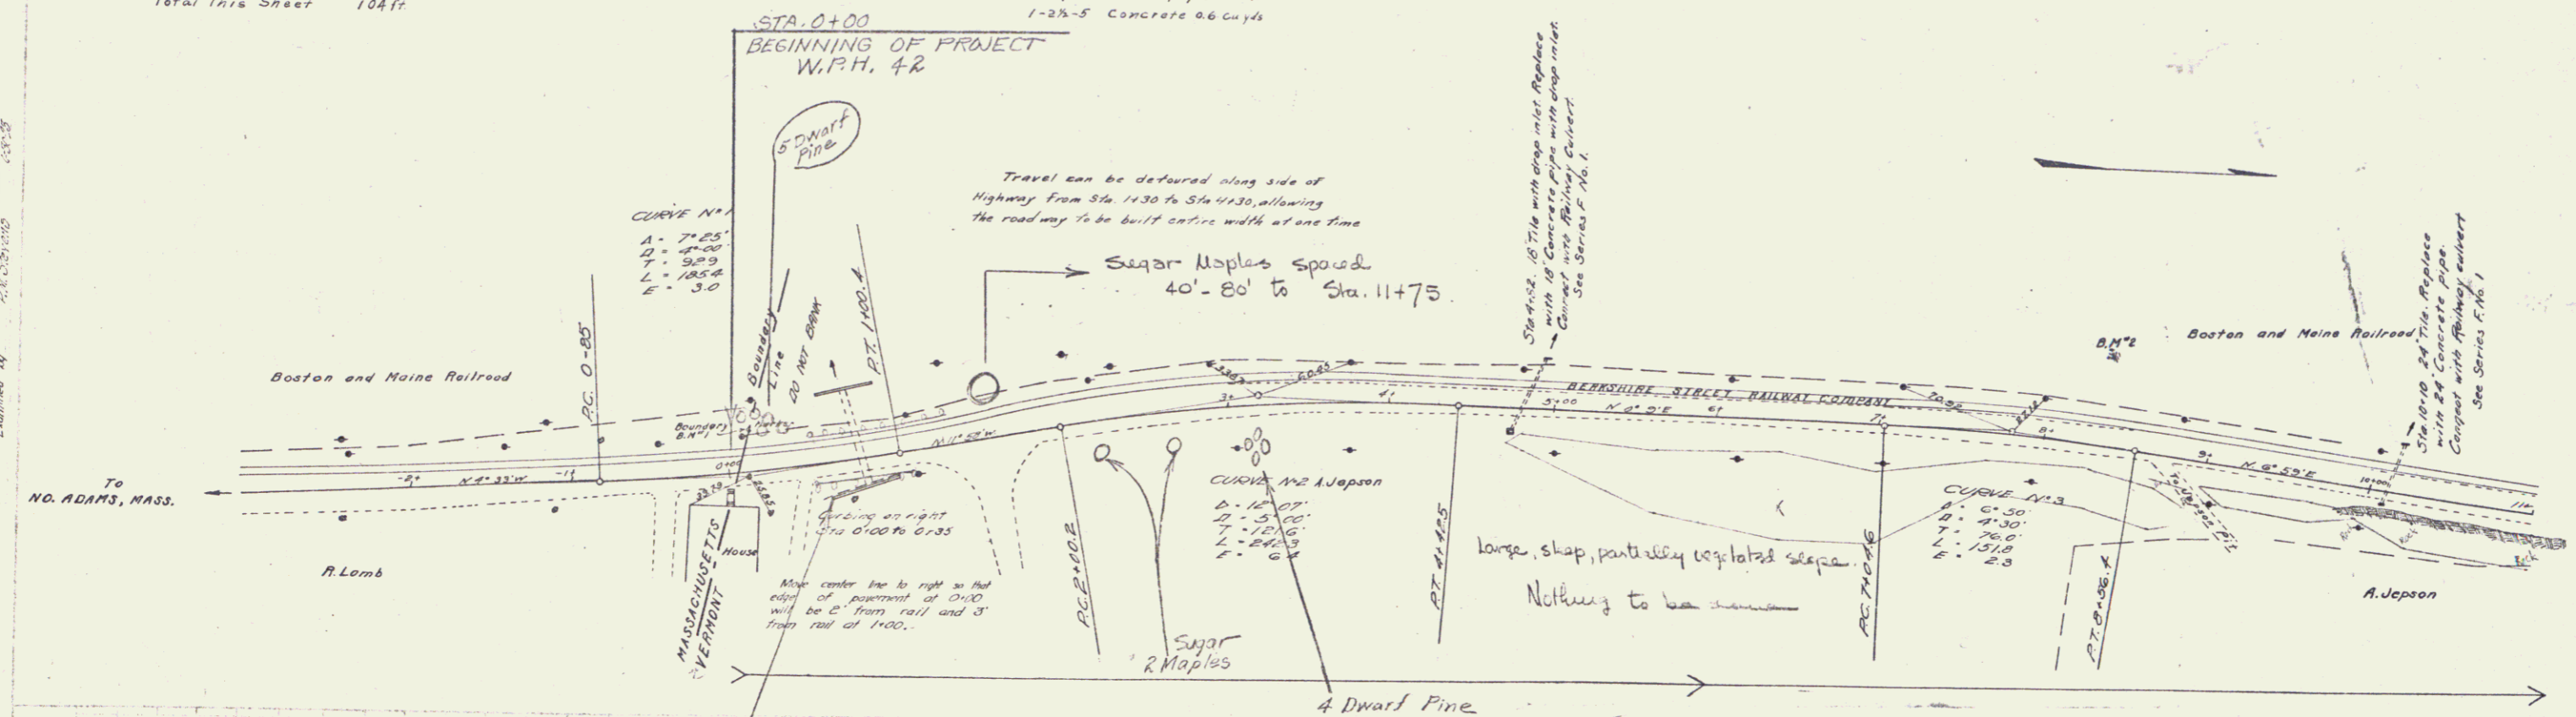

BM #1 Granite Boundary marker 29 feet on left Sta 0+00 El 100.0
 BM #2 Drill hole in boulder 56 feet on left Sta 8+34 El 67.90