
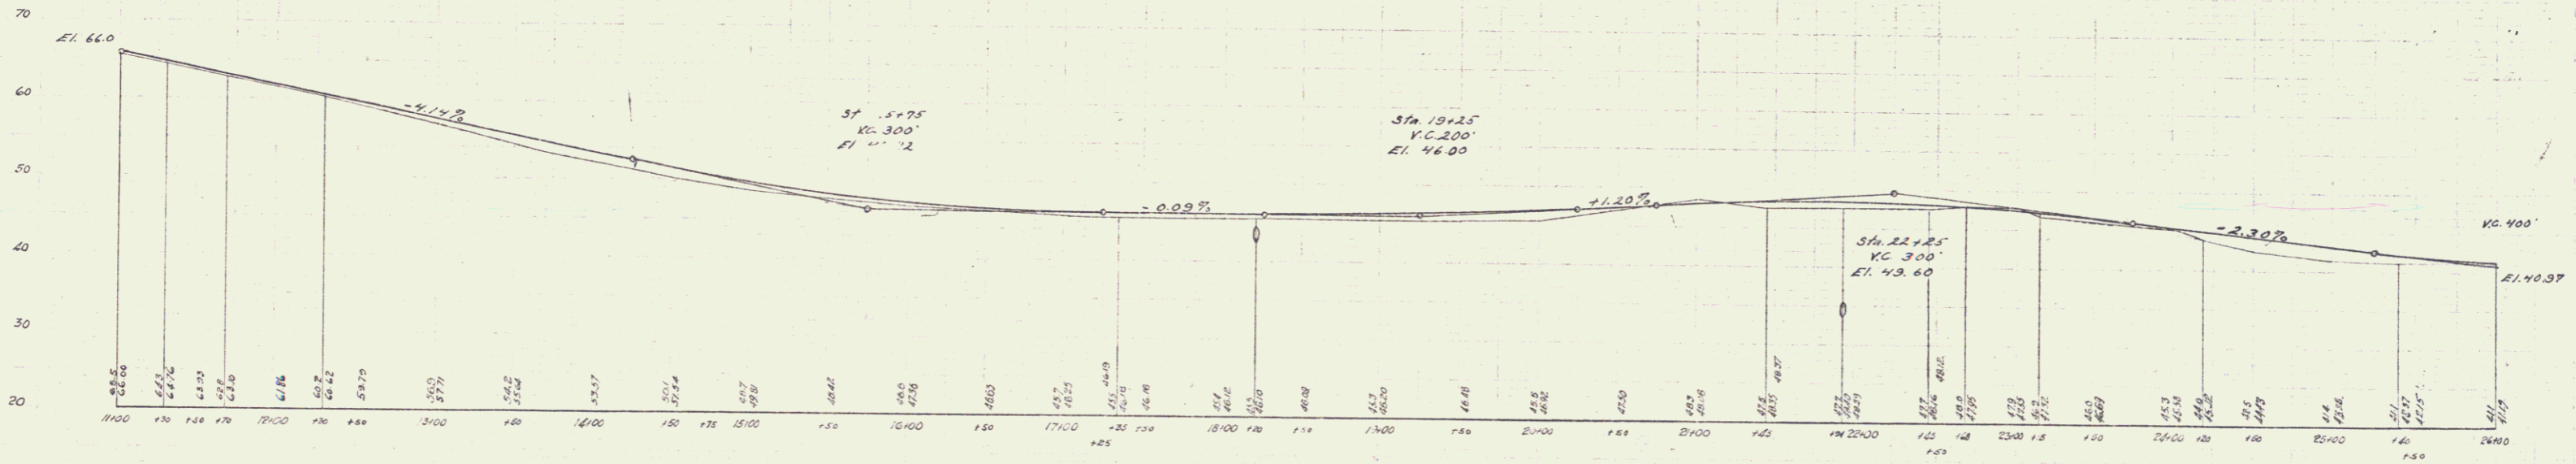


GUARD RAIL REQUIRED
ON RIGHT
Sta. 17+23 to Sta. 17+47 24 ft
ON LEFT
Sta. 17+23 to Sta. 25+23 800'
TOTAL THIS SHEET 824 ft

NEW CULVERTS REQUIRED
Sta. 17+35 18" Concrete pipe 30 ft
1-24-5 Concrete 15 cu yds

PER. NO.	DATE	BY	CHKD.	SCALE	SHEET NO.	TOTAL SHEETS
9	FT	1-25	MEY	1"	1	1

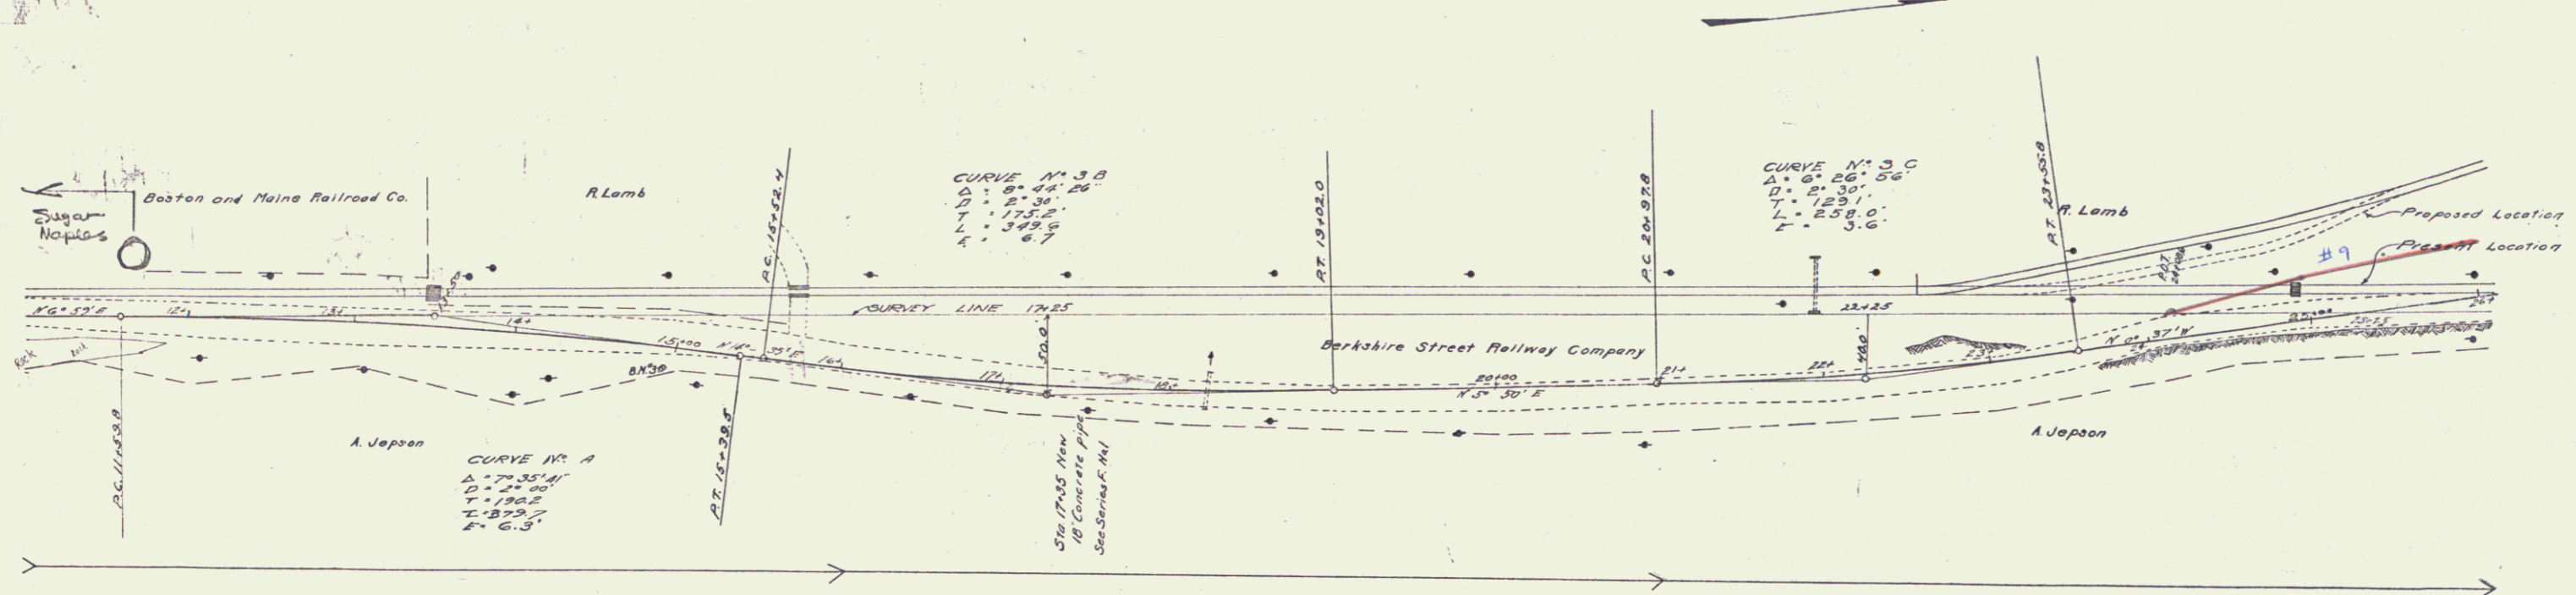

Series F No. 12
Sheet 4 of 4