
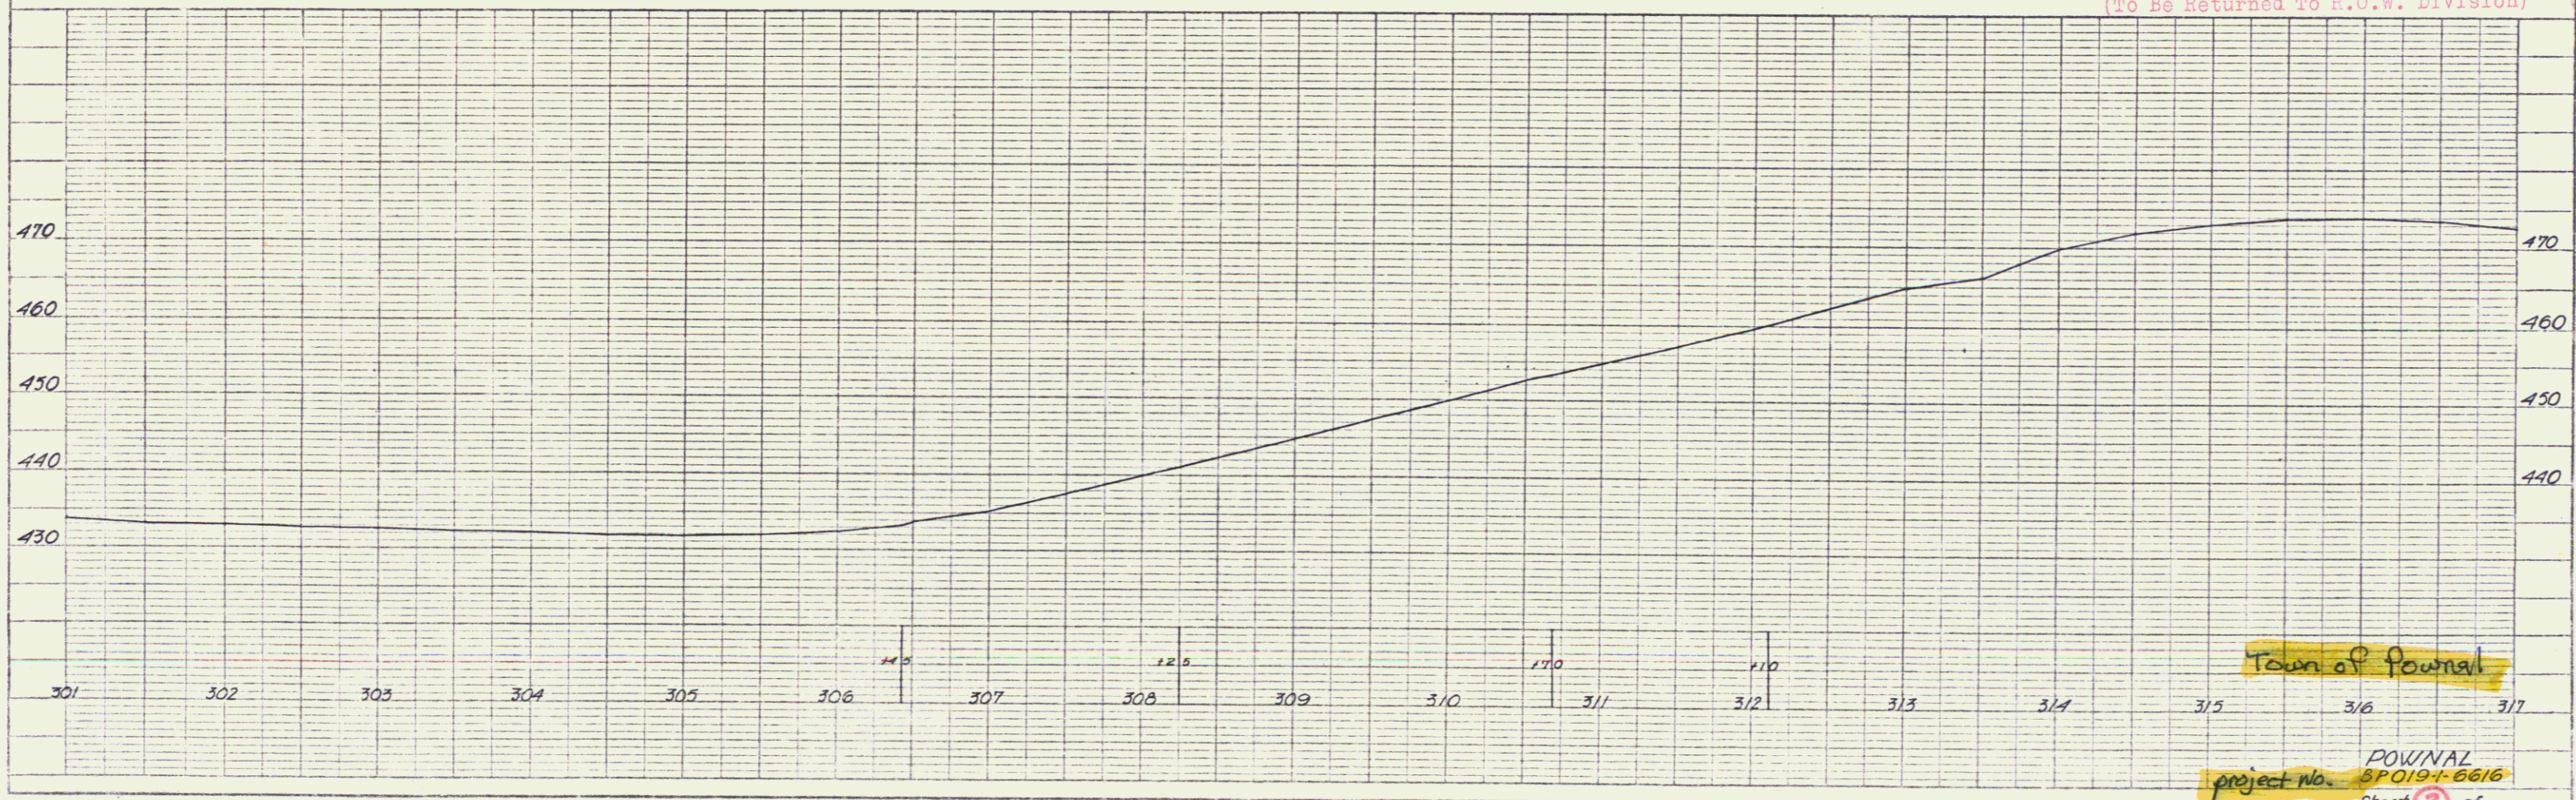


PLAN
 DATE: 5-24
 DRAWN BY: [illegible]
 CHECKED BY: [illegible]

PROFILE
 DATE: 5-24
 DRAWN BY: [illegible]
 CHECKED BY: [illegible]

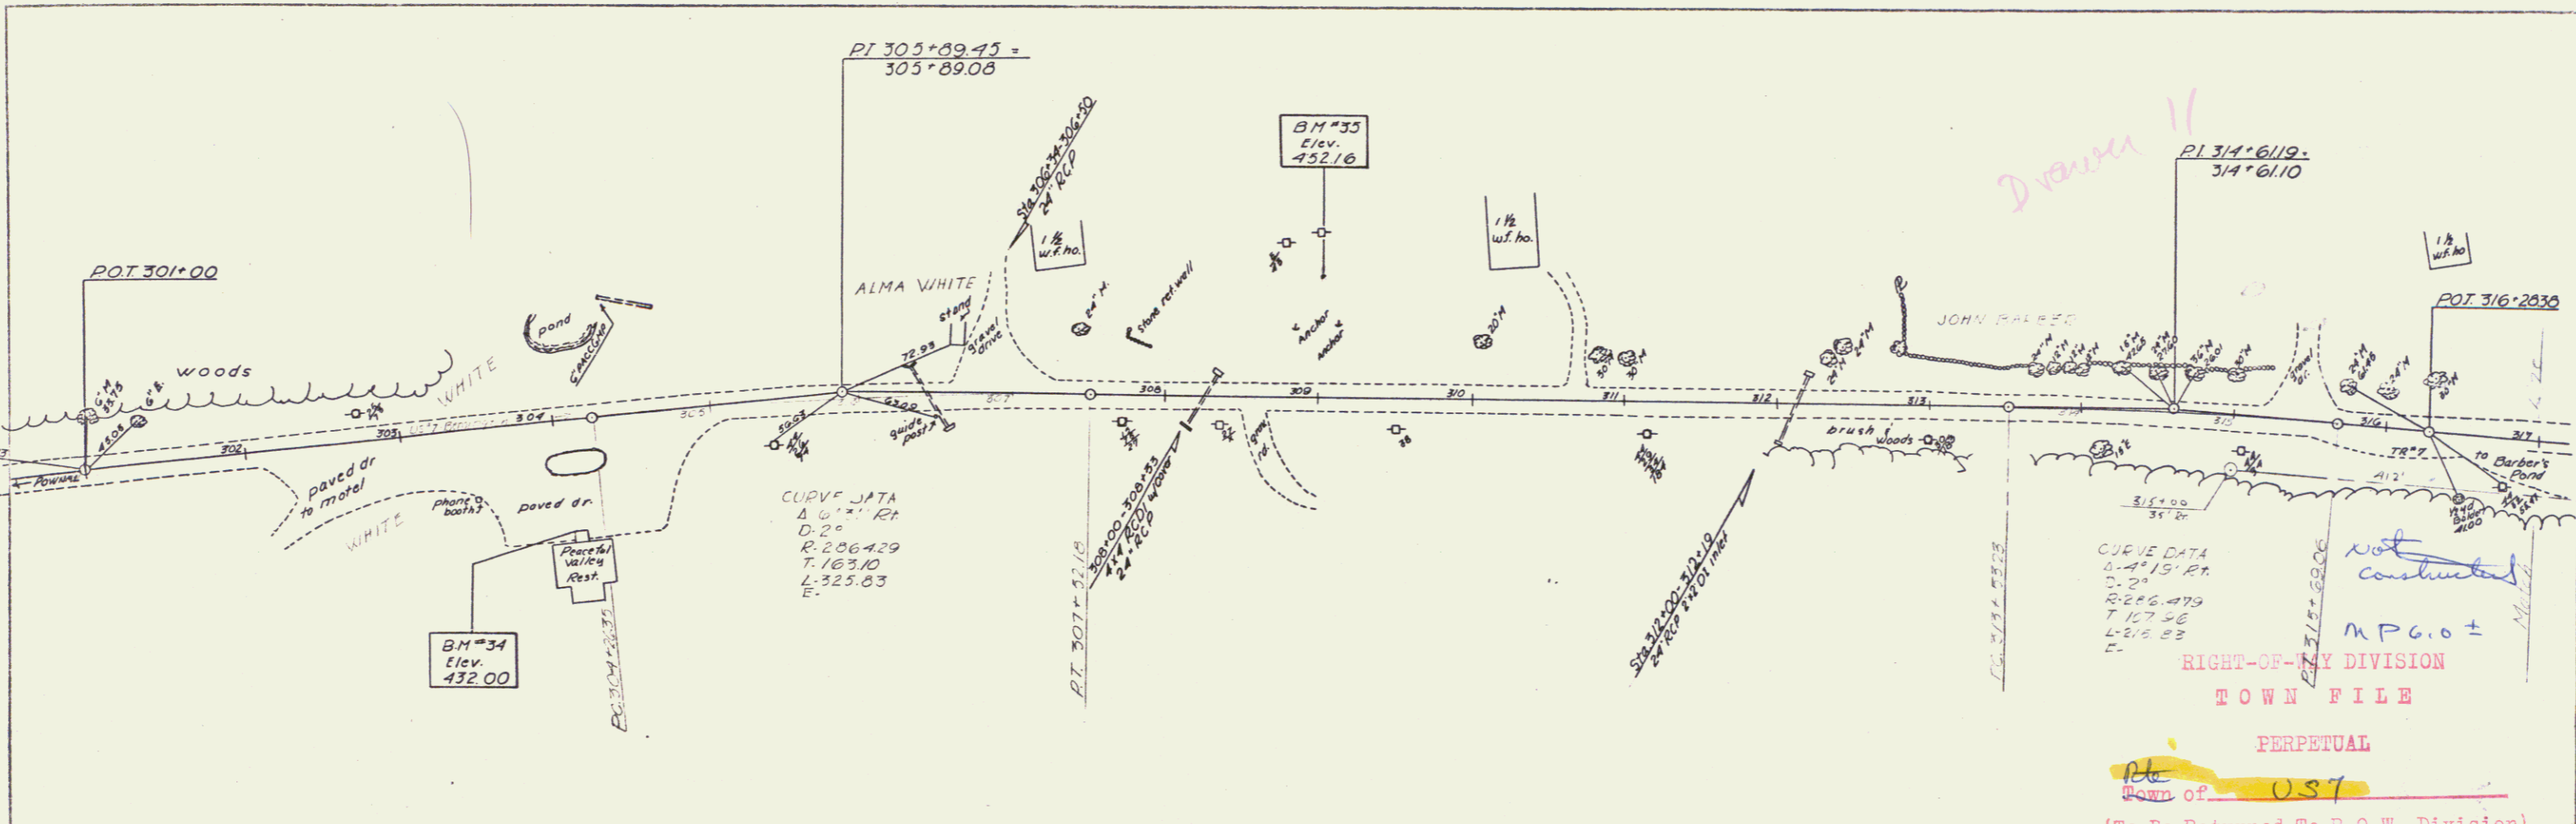

Drawn 11

CURVE DATA
 Δ 107.11 Rt
 D: 2°
 R: 2064.29
 T: 163.10
 L: 325.03
 E

RIGHT-OF-WAY DIVISION
 TOWN FILE
 PERPETUAL
 Town of [illegible]
 (To Be Returned To R.O.W. Division)

Town of Pownal
 project no. 5P019-6616
 Sheet 2 of