


4258 ESTATE OF WALTER JOEL BURRINGTON
 WALTER H. BURRINGTON ADMIN.
 JOEL & BURRINGTON
 BRUCE E. BURRINGTON
 BERNICE H. BURRINGTON
 (A-0704) STA. 123+29-128+44.4
 CULVERT RIGHTS STA 124+00,
 COND. 7/30/59
 REC.: POWNAL BK. 61 PG. 235-7/30/59

THREE CABLE GUARD RAIL W/STEEL POSTS
 Left Right
 Sta. 125+00 Sta. 126+00
 156+86 156+86

Drilling and Blasting of Solid
 Rock Subgrade, Item 114 Mod
 137+00 - 139+00

EDGAR H. MERCHANT ESTATE
 DR. J. GORDIS ARMSTRONG, ADMIN.
 1A 15.50 STA 124+72-160+55
 CULVERT RIGHTS STA 131+50, 137+00, 143+50, 150+15
 COND. AMEND. #1 10/18/60
 REC.: POWNAL BK. 62 PG. 162-10/18/60
 DATED 10/17/60
 S + 15 - 149+85 RT
 148+10 - 149+85 LT

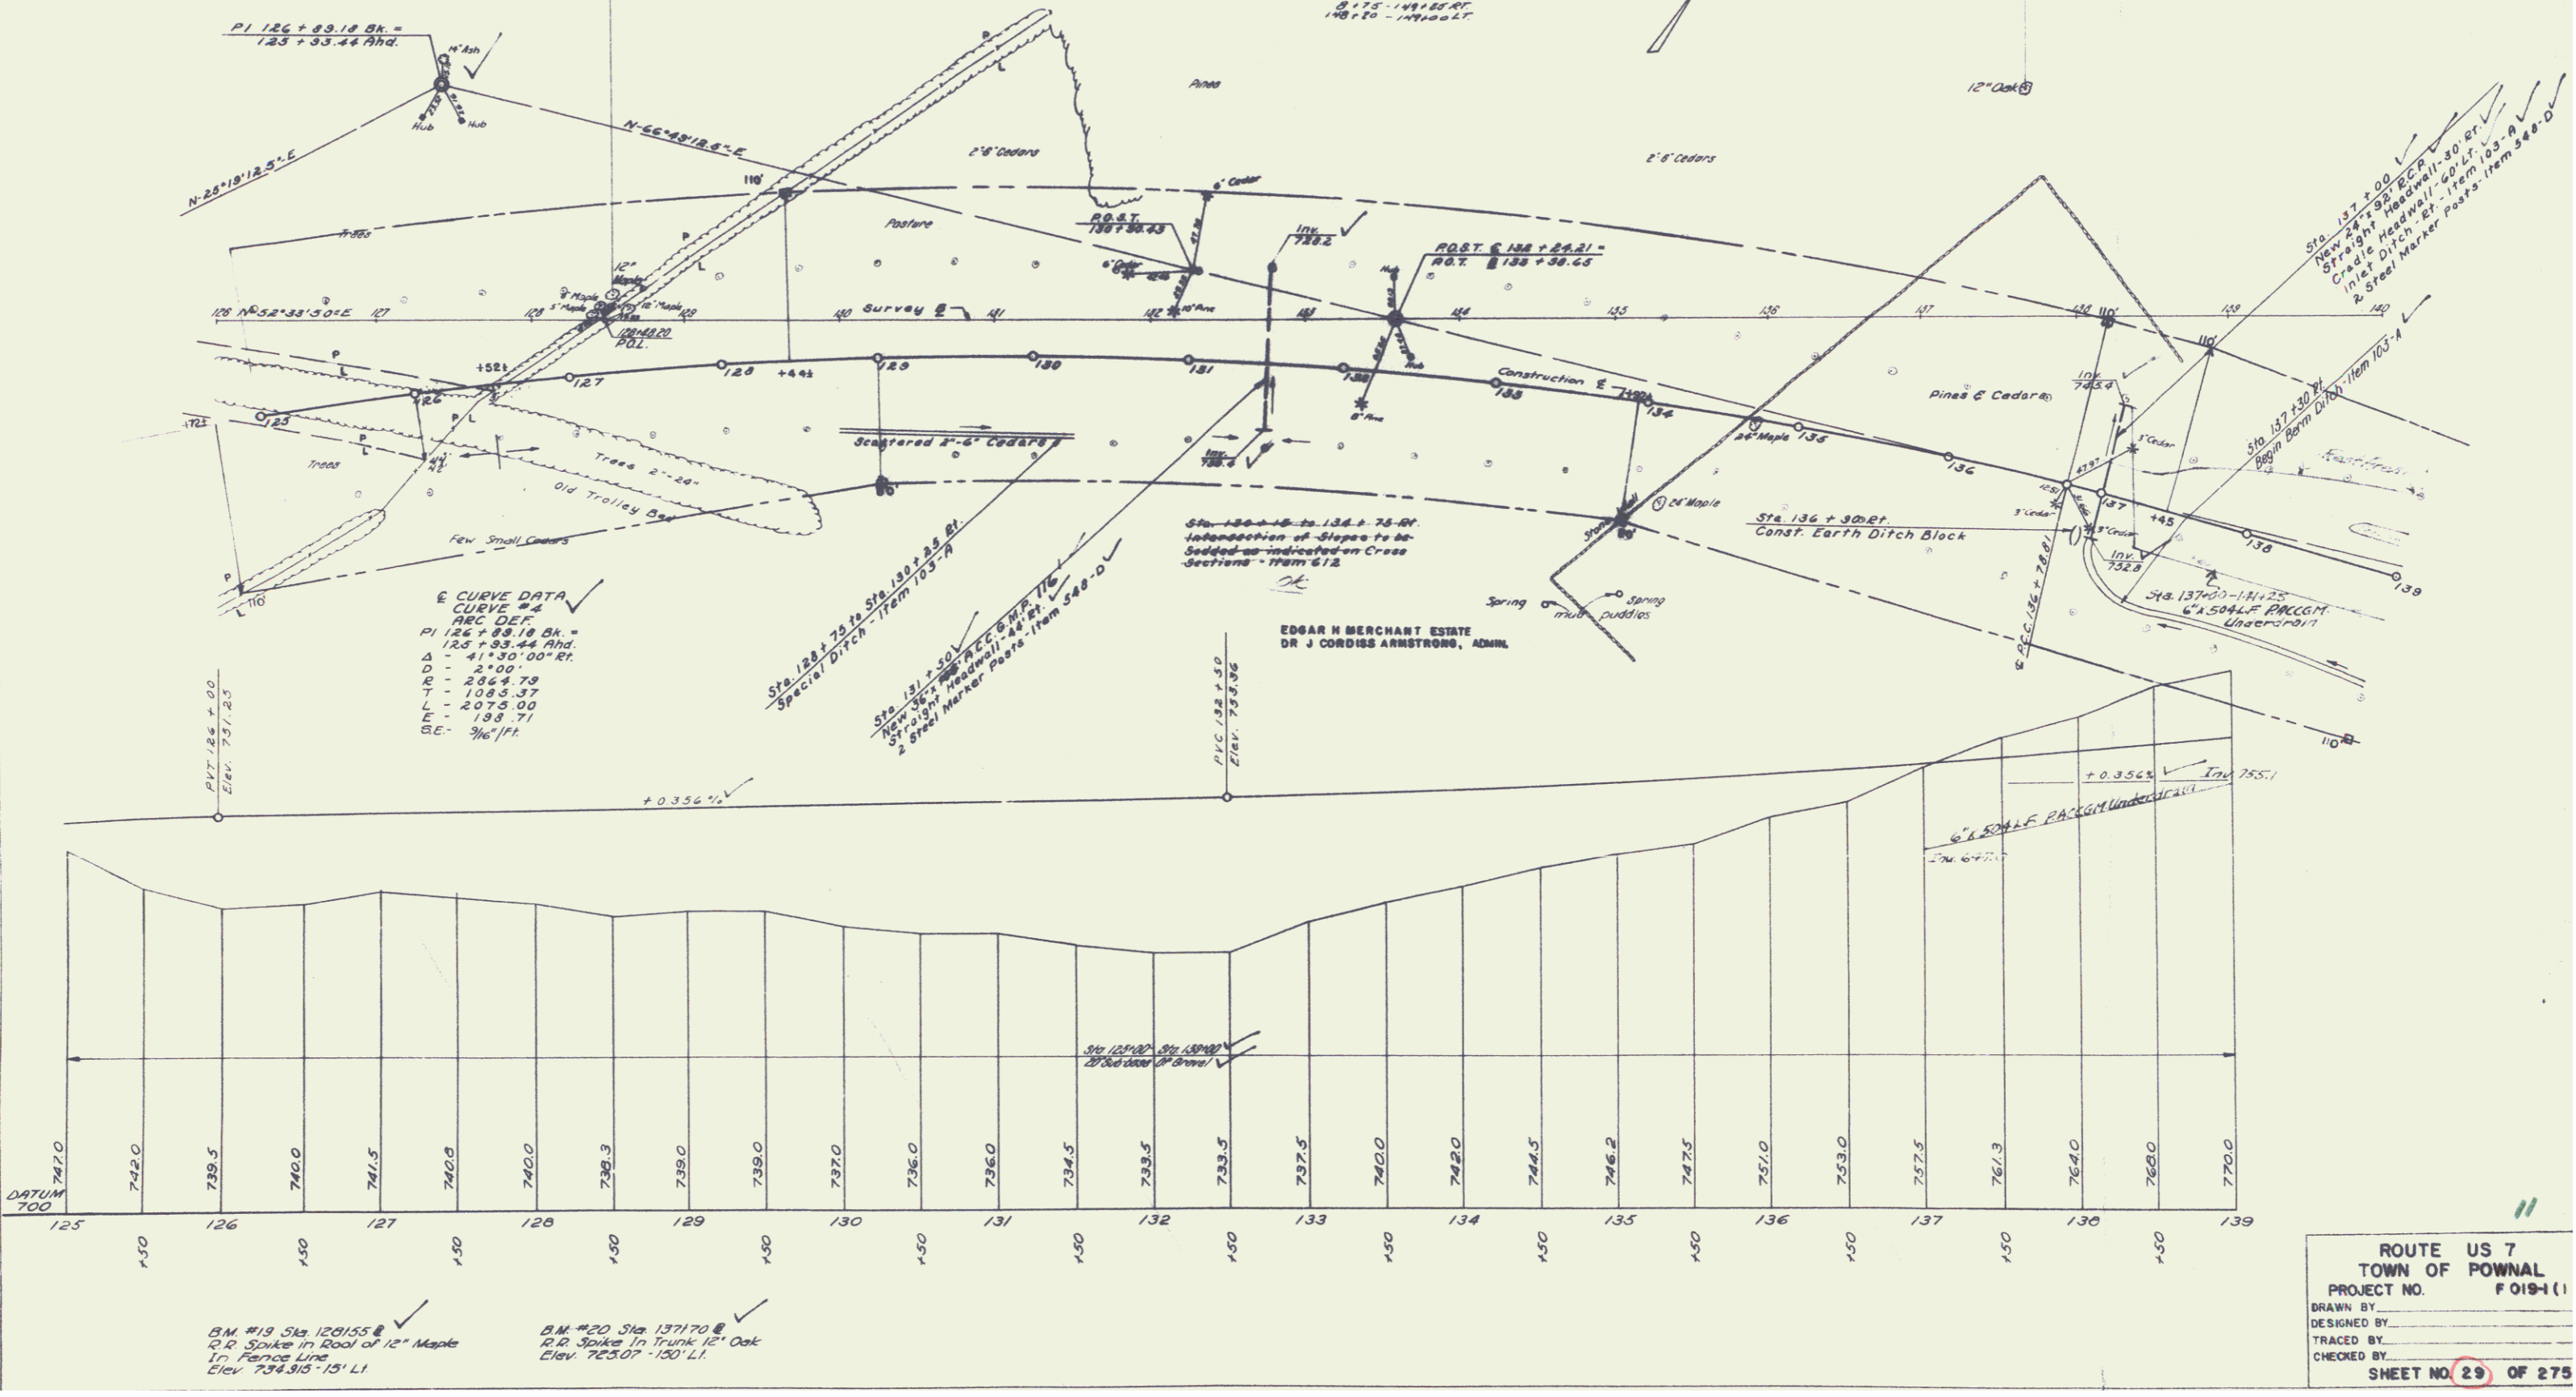

ROUTE US 7
 TOWN OF POWNAL
 PROJECT NO. F 019-1 (1)
 DRAWN BY: _____
 DESIGNED BY: _____
 TRACED BY: _____
 CHECKED BY: _____
 SHEET NO. 29 OF 275