
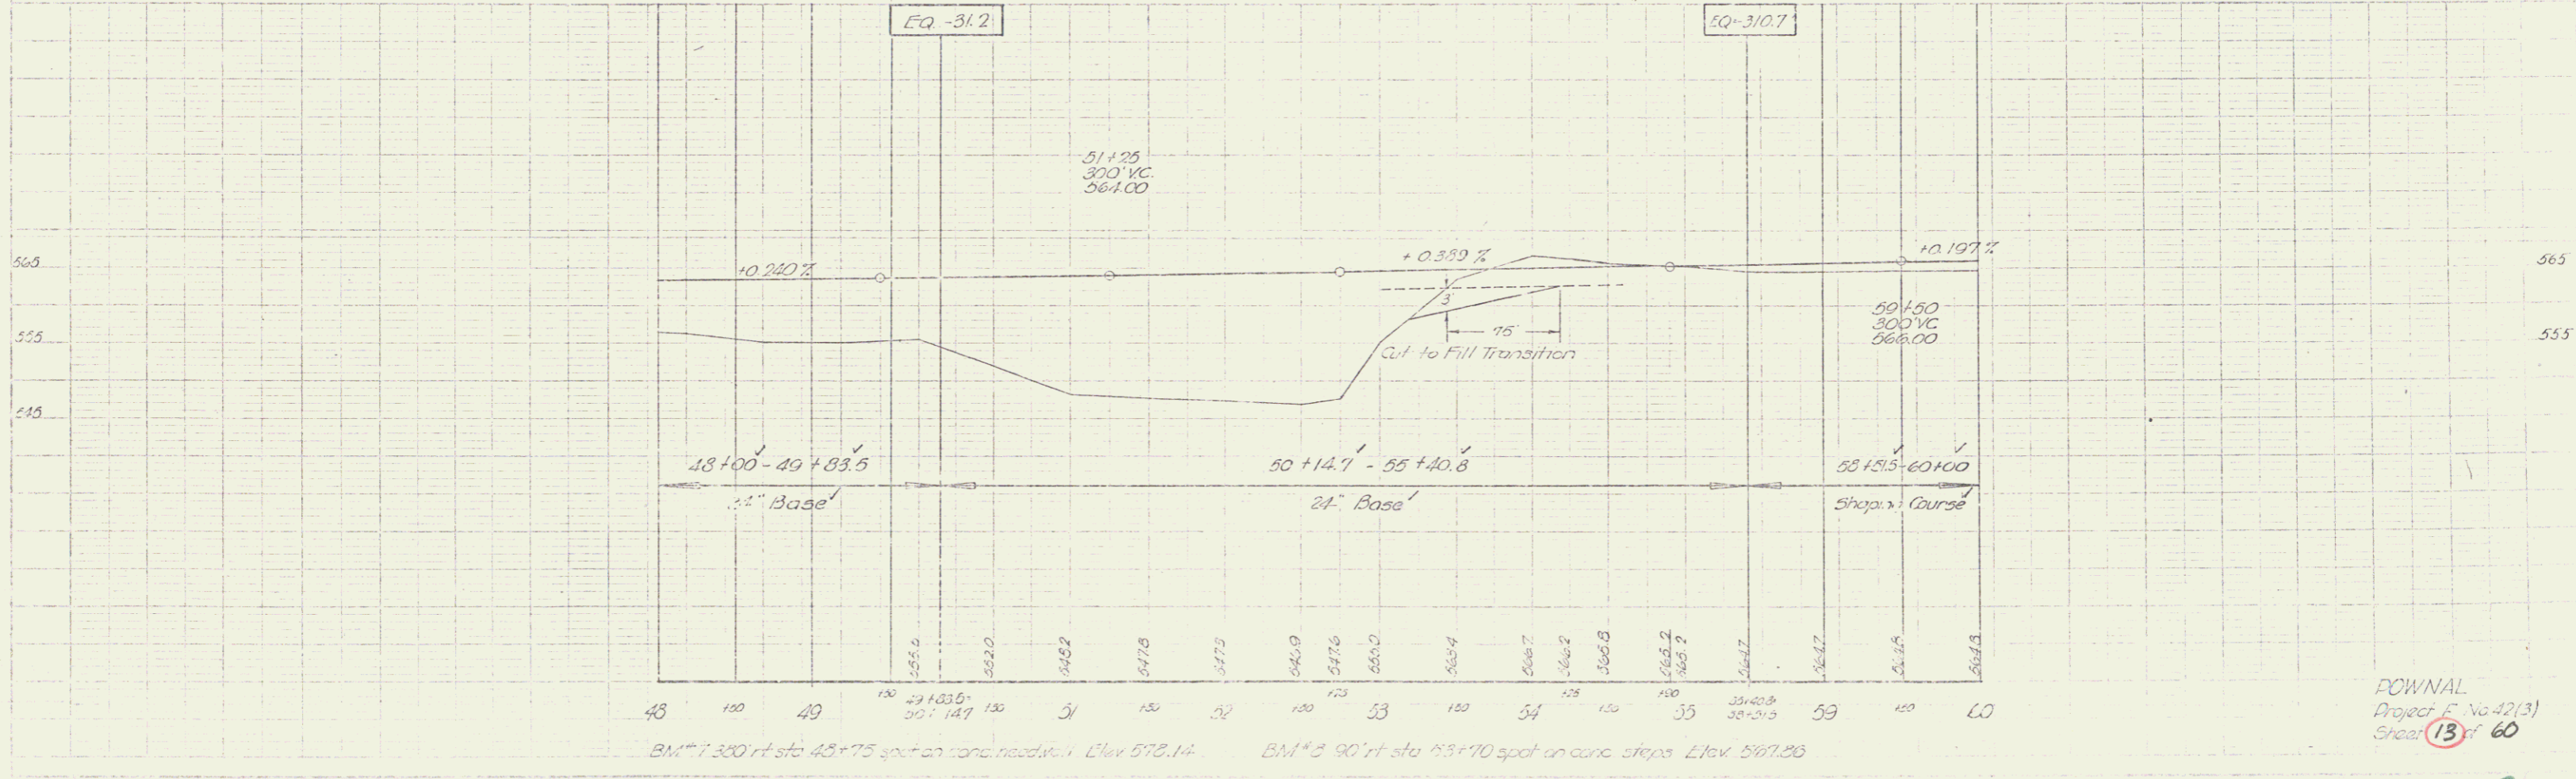
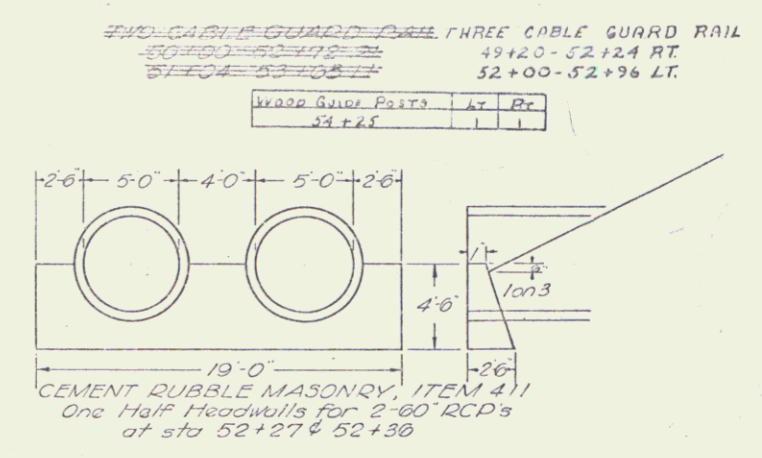


1230
 1231
 1232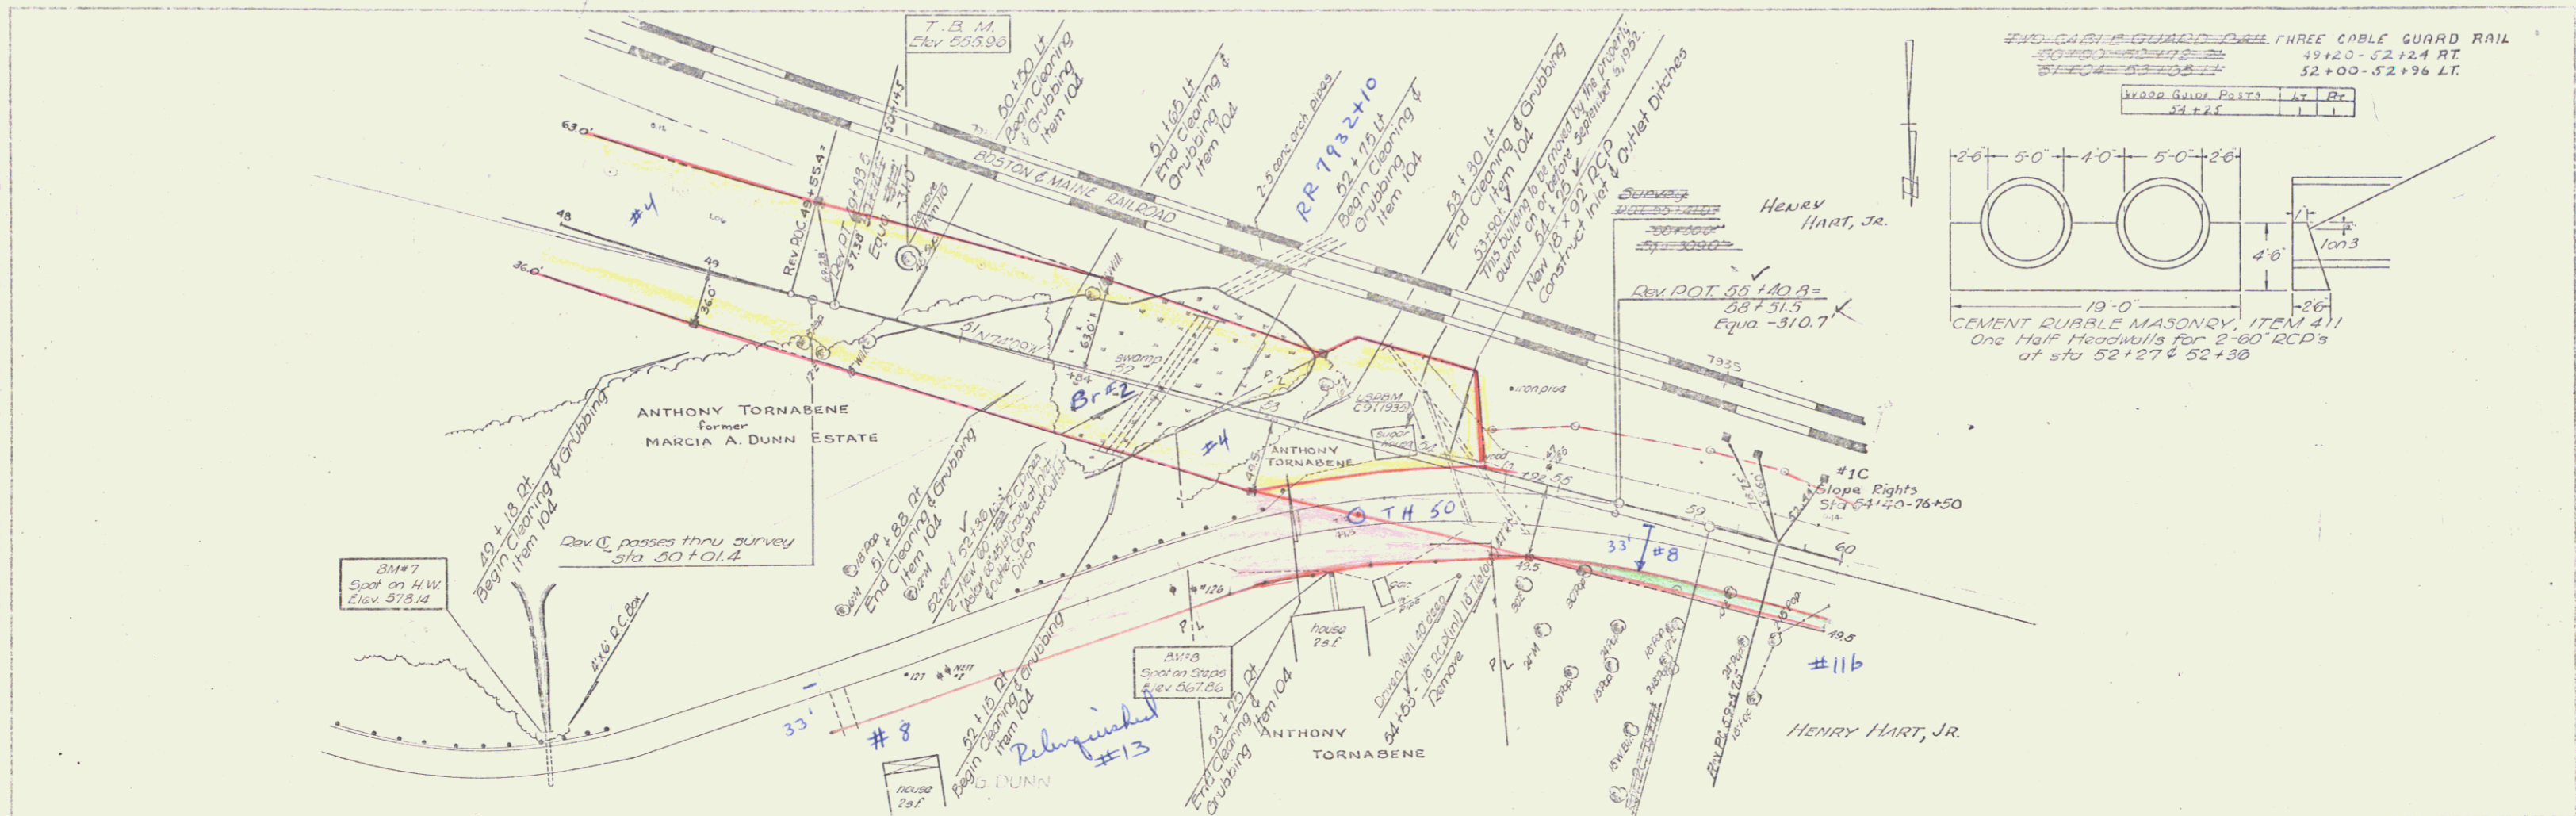
FOWNAL
 Project E. No 42(3)
 Sheet 13 of 60