



THREE CABLE GUARD RAIL
75+00 - 76+50 LF

Parcel #	Instr.	Date	Grantor	Grantee	Recorded	Book	Page	Date	Remarks
#8	Q.C.D.	8-28-52	Clifford E. & Bertha L. Martell	St. of W.	76	59	12	8-20-52	

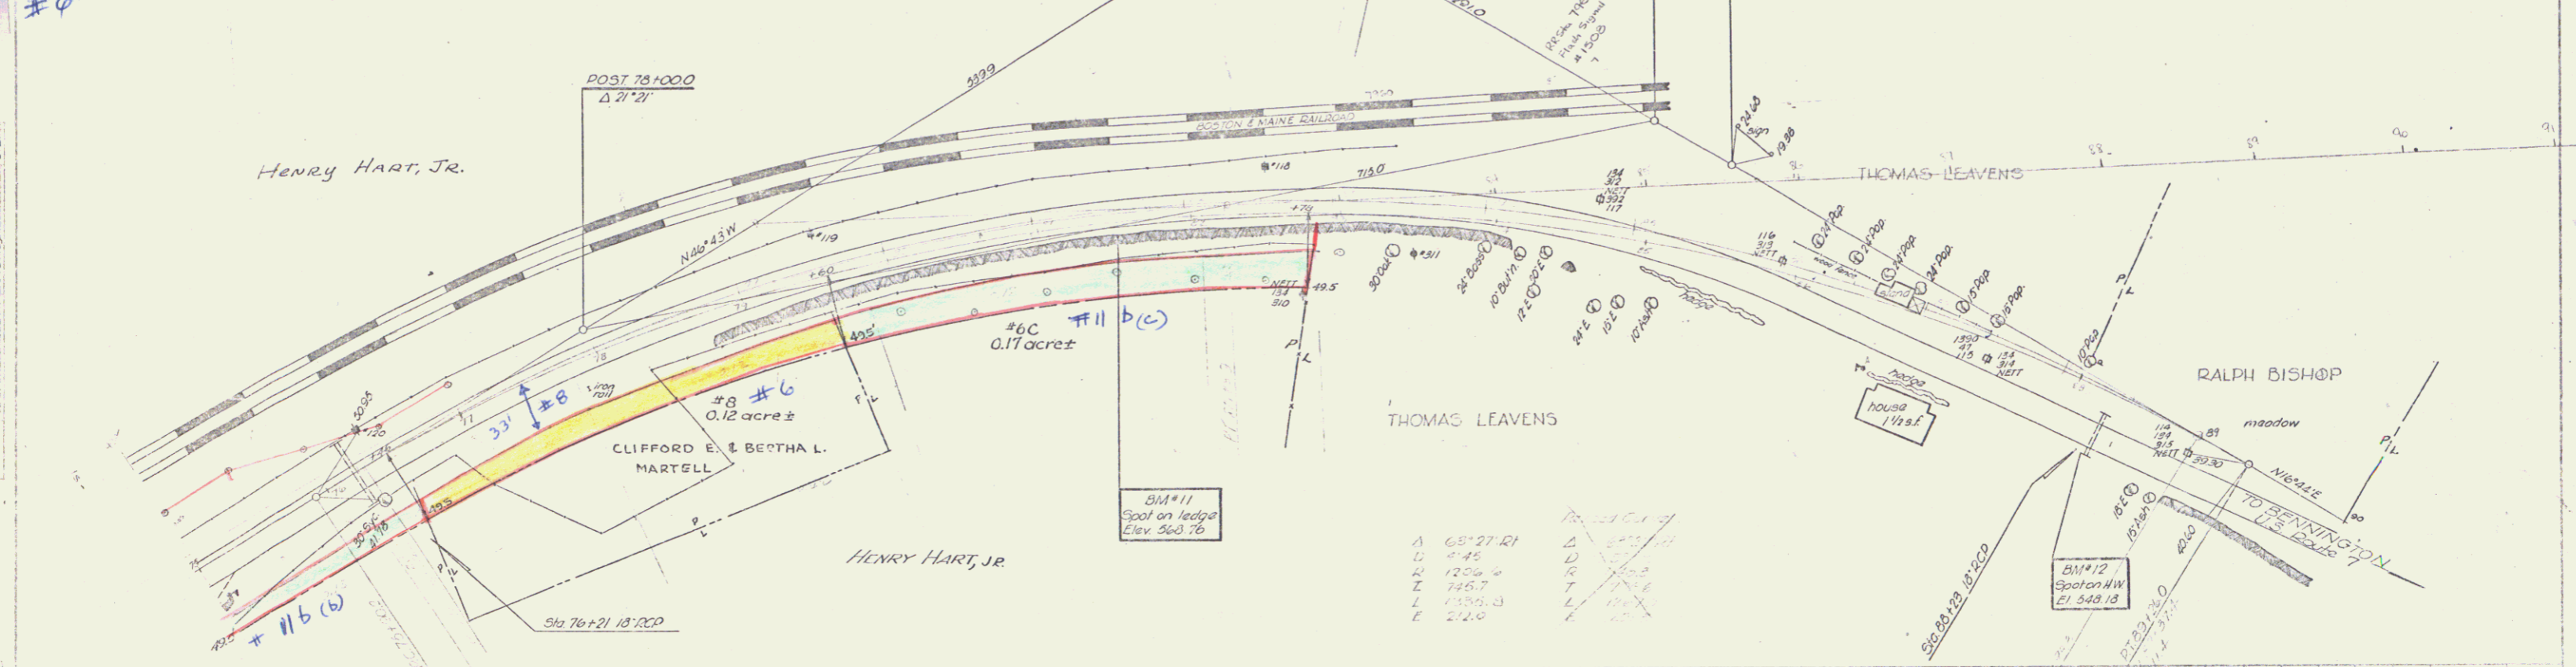

Station	Angle	Distance	Station	Angle	Distance
A	65° 27' 21"	11.0	D	27° 15' 11"	11.0
B	9° 45'	12.0	E	17° 15' 11"	12.0
C	12° 06' 4"	745.7	F	17° 15' 11"	745.7
D	745.7	17° 15' 11"	G	17° 15' 11"	174.0
E	17° 15' 11"	174.0	H	17° 15' 11"	174.0

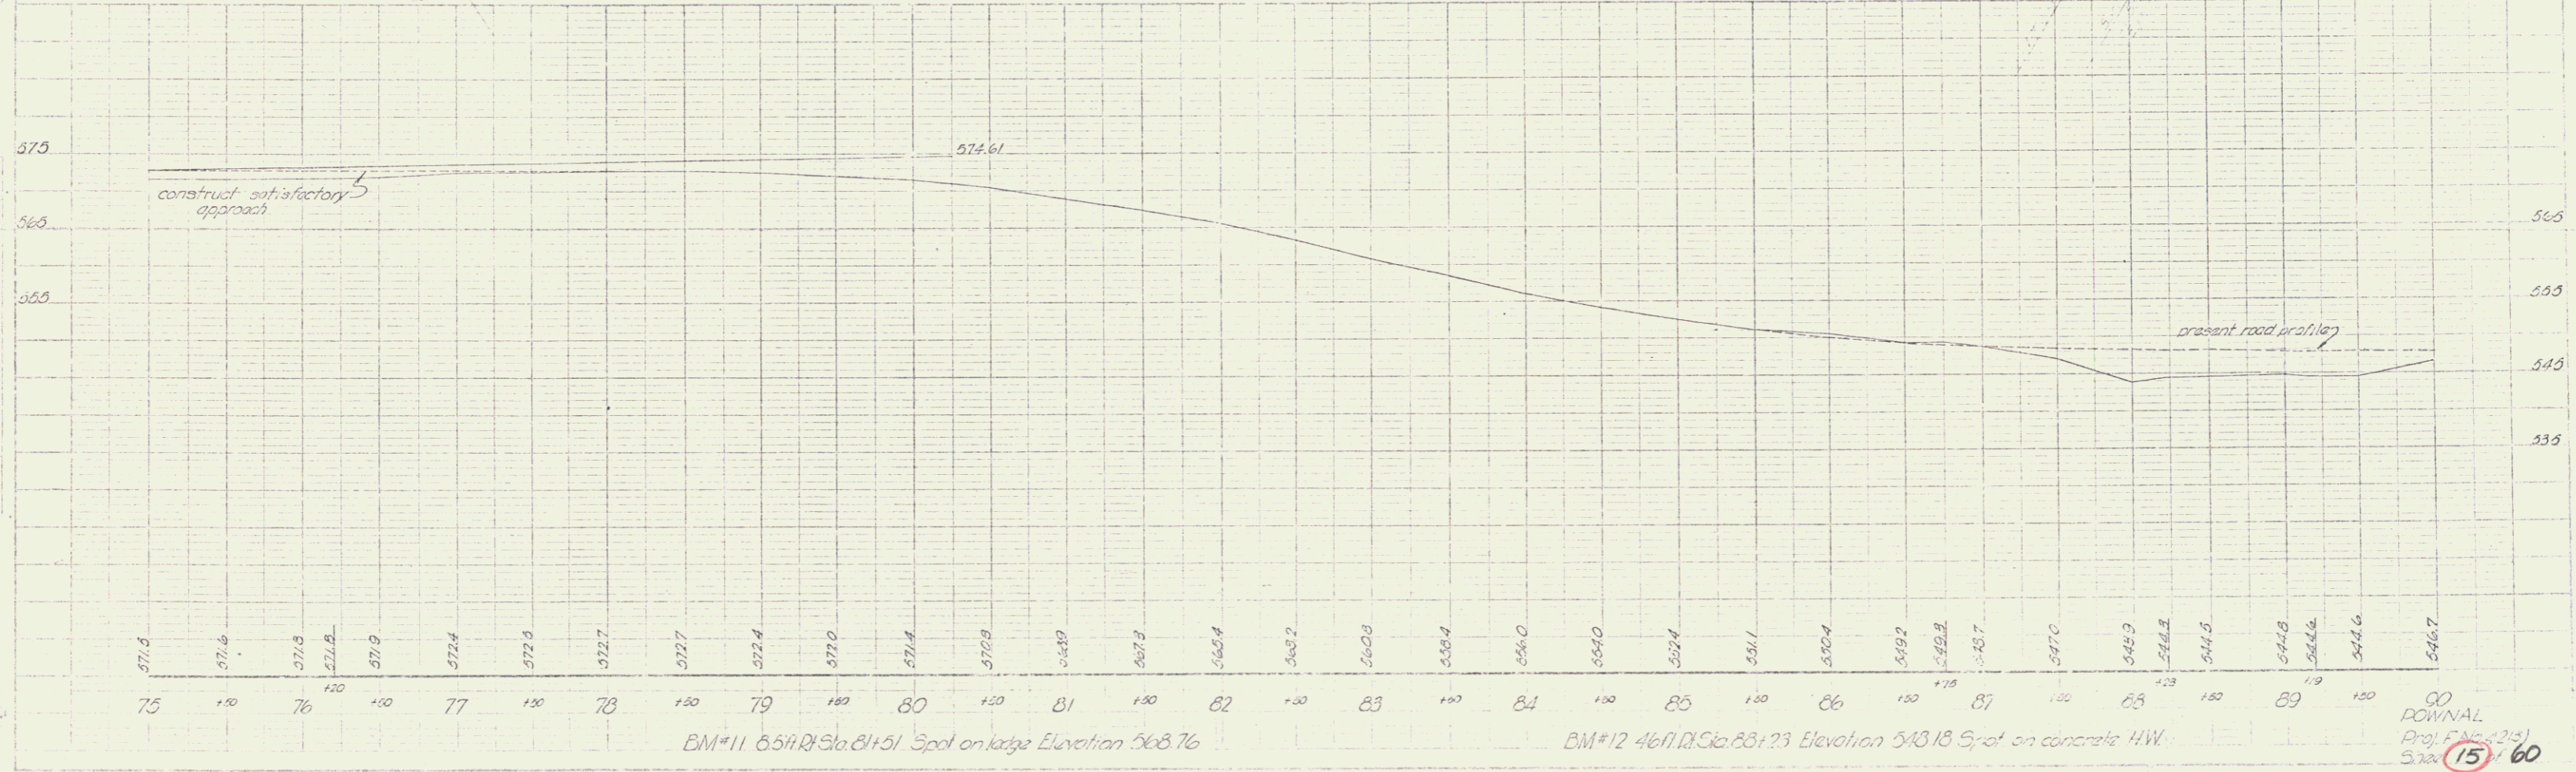

1/2" = 100'
 1/4" = 50'
 1/8" = 25'

1/4" = 5'
 1/8" = 2.5'

GO DOWNAL
 Proj. F.N. 4215
 5/22/60 (15) 60