

STATE OF VERMONT
DEPARTMENT OF HIGHWAYS
RIGHT-OF-WAY PLANS
DETAIL SHEET
OF

TABLE OF PROJECT PROPERTY ACQUISITION

PARCEL NO.	GRANTOR	SHEET NO.	BEGINNING STATION	ENDING STATION	TAKING	REM.	RIGHTS	TITLE TAKEN	DATE	TOWN OR CITY RECORDED	BK.	PG.	REMARKS
1	KELLY, THOMAS P & MARGARET O'S.		513+00 513+55 LT. 515+45 LT.	516+18	0.26 A±		DRIVE (T) DRIVE (T)						
2	GREENBERG, NORMAN H.		513+00	515+36 515+33 RT.	0.16 A±		DRIVE (T)						
3	ANDERSON, ALBERT W. & SVEA N.		516+13 516+10 LT.	518+24 517+30 LT.	0.08 A±		DRIVE (T)						
4	BENNINGTON PARK LAWN CEMETERY		515+33 516+00 RT.	526+75 520+31 RT.	1.7 A±		SLOPE (2,880°) (T)						
5	TAYLOR, ROLLIN J. & MARION L.		523+45 522+70 RT.	524+54	1272'±		DRIVE (T)						
6	GREENBERG, EDWARD H.		524+50	526+75	0.15 A±								

TABLE OF REVISIONS

REVISION NO.	SHEET NO.	DESCRIPTION OF REVISION	DATE	MADE BY	APPROVED BY
#1		Parcel #3, Changed taking from 0.15A± to 0.08A± to correct computing error. Order #467	9-15-66	RST	JW
2	2	Parcel Nos 1 & 2, Reduced taking (0.04A±) per Change Order #485.	9-30-66	dof	JW

MP 1.75 - 2.00
RIGHT-OF-WAY DIVISION
TOWN FILE
PERPETUAL
TOWN OF US7
(To Be Returned To R.O.W. Division)

Pin # 992532

MADE BY: BCG. DATE: 7-28-66
CHECKED BY: JGP. DATE: 7-28-66

PRESENT R.O.W.
--- ---
--- --- TAKING WITHOUT ACCESS
--- P --- TAKING WITHOUT ACCESS ALONG PROPERTY LINES
--- L ---
--- --- TAKING WITH ACCESS
(P) PERMANENT EASEMENT
(T) TEMPORARY EASEMENT


LEGEND
SR SR SLOPE RIGHTS
P P PROPERTY LINE
--- Δ --- TOP OF CUT
O O TOE OF SLOPE

APPROVED: Thomas C. Bennett DATE: 8-8-66
CHIEF OF ACQUISITION
APPROVED: J.M. Doolittle DATE: 8-8-66
HIGHWAY ENGINEER
APPROVED: H.P. Redigan DATE: 8-8-66
TOWN ENGINEER


PROJECT BENNINGTON
NO. BP 019-1-6612
SHEET 1 OF 10

Town of Bennington

PLAN
 DATE: _____
 DRAWN BY: _____
 CHECKED BY: _____
 IN CHARGE: _____
 NO. _____

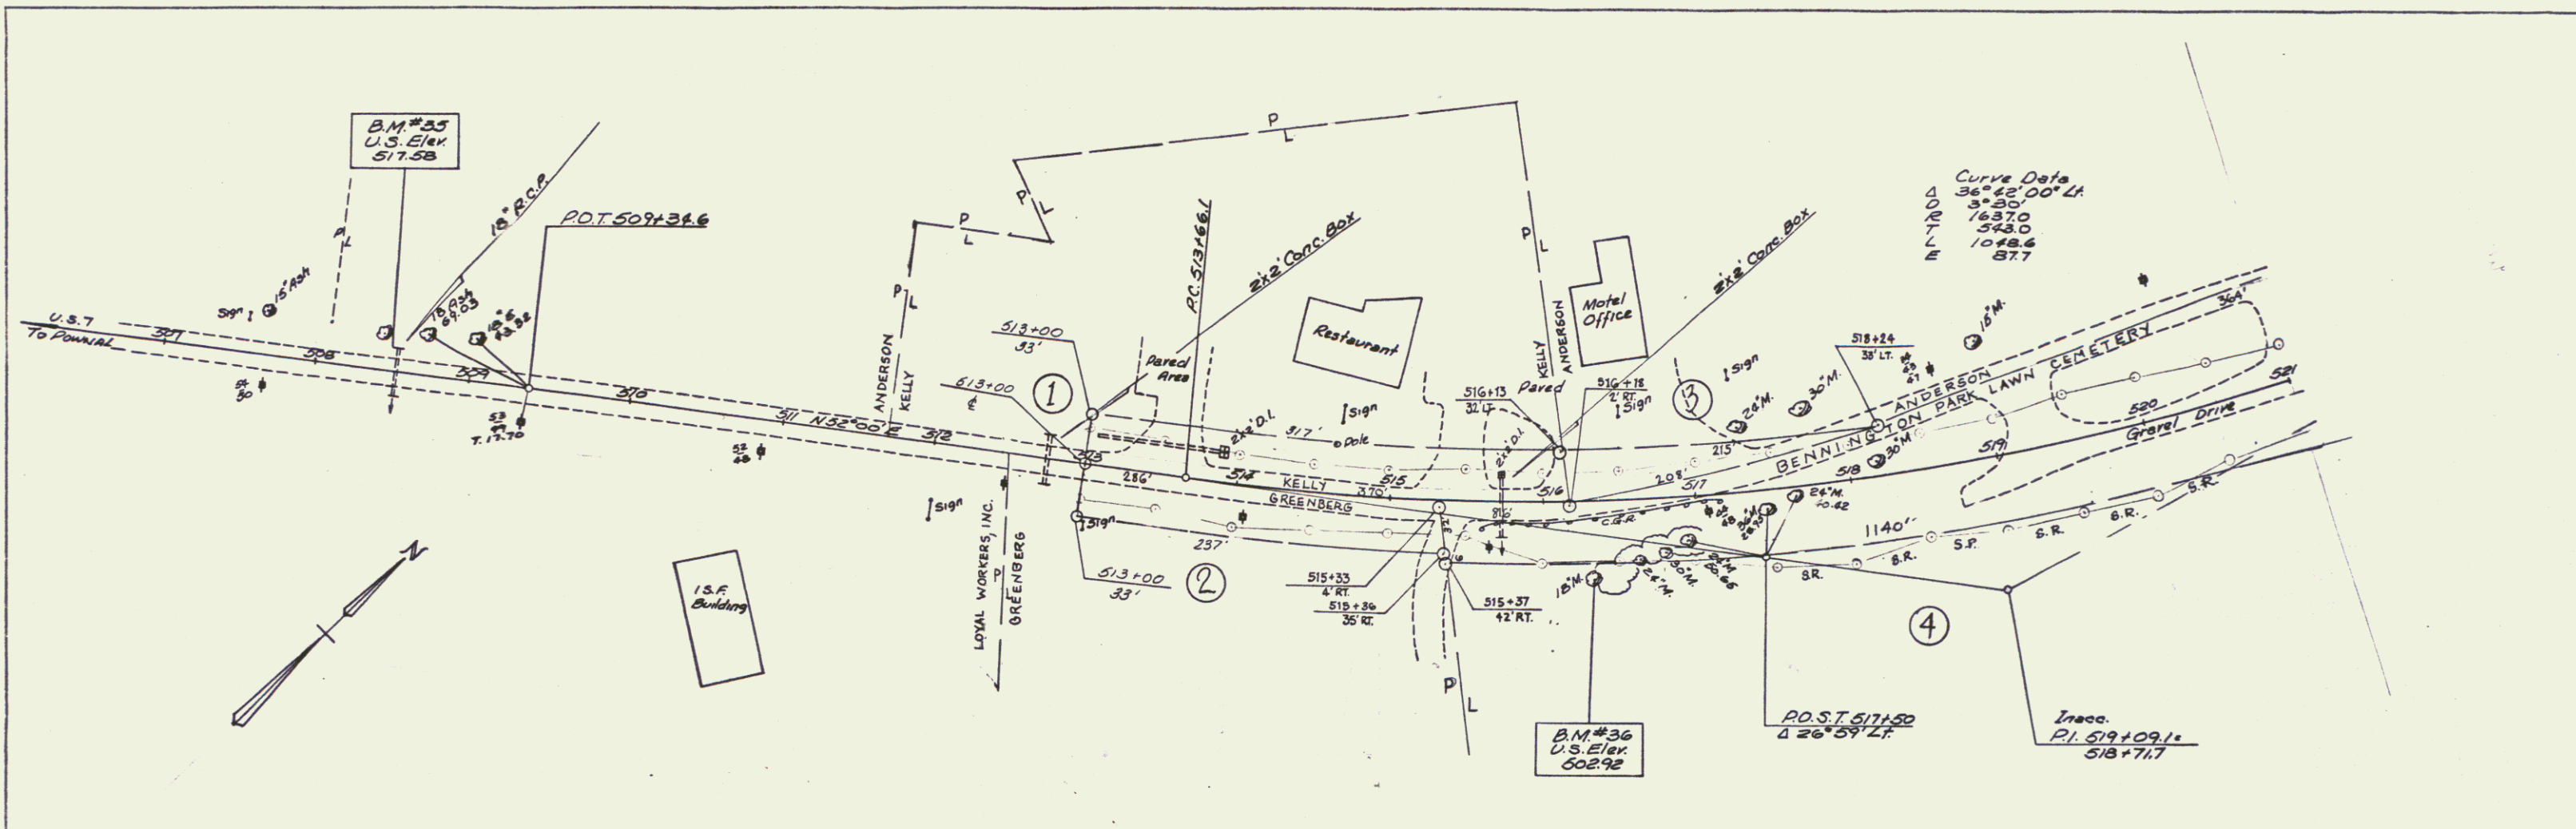


PROFILE
 DATE: _____
 DRAWN BY: _____
 CHECKED BY: _____
 IN CHARGE: _____
 NO. _____

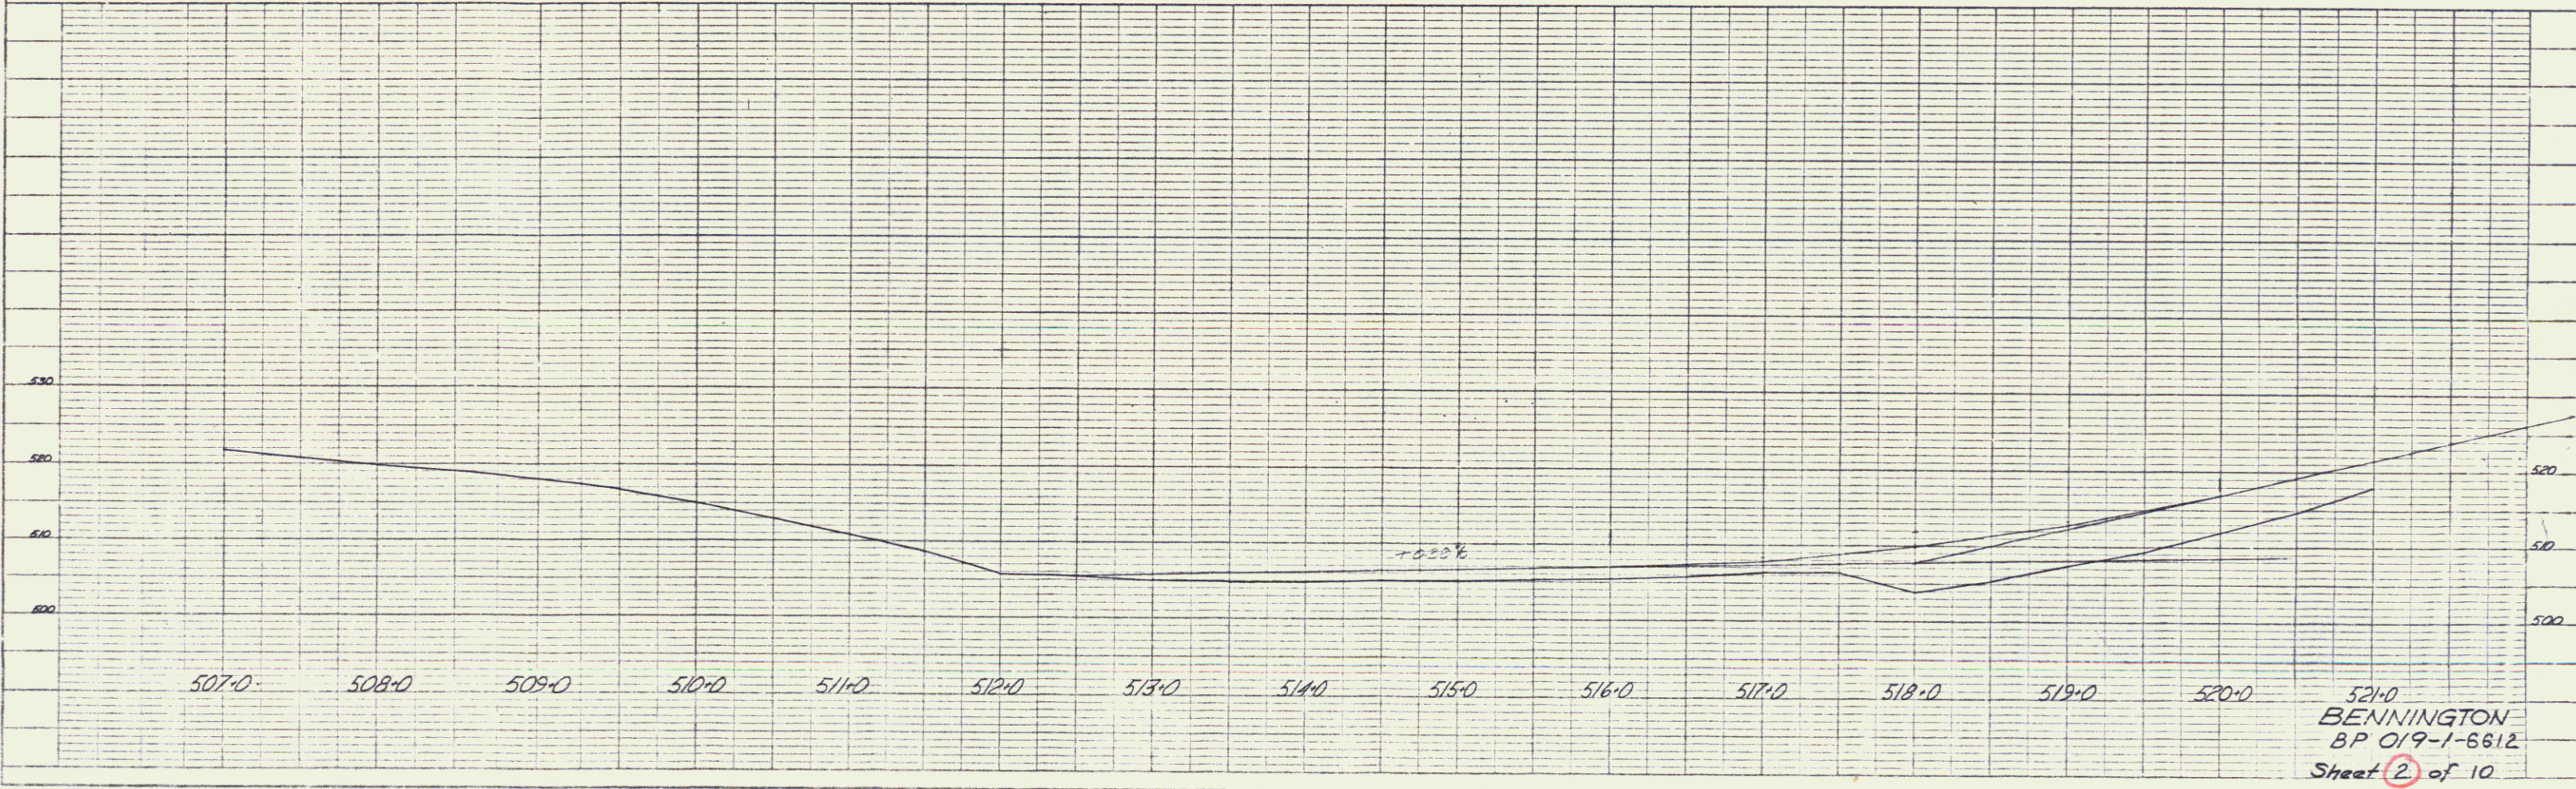


K&E
 48 7012 IMPERIAL

PLAN
 DATE: _____ BY: _____
 CHECKED: _____
 NOTE BOOK NO. _____
 BT. OF WAY CHECKED: _____

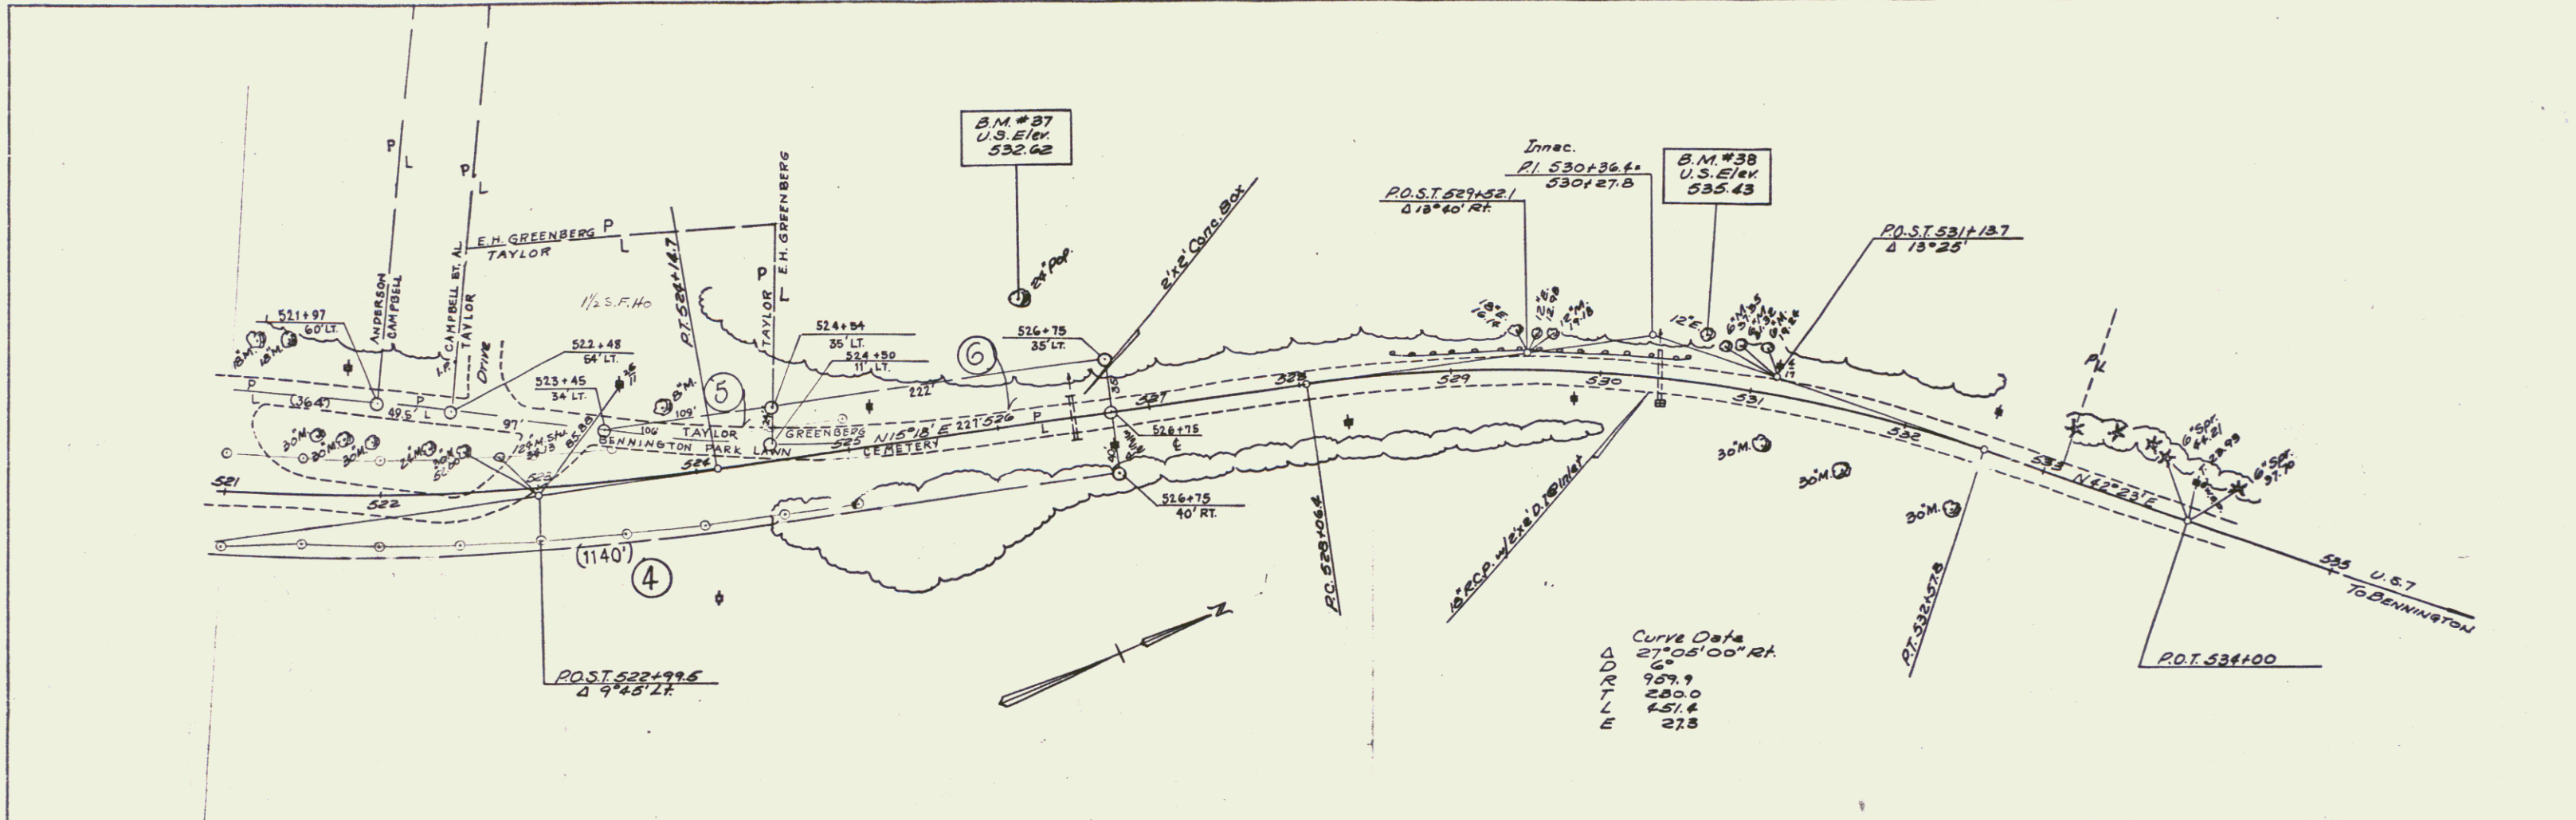

PROFILE
 DATE: _____ BY: _____
 CHECKED: _____
 NOTE BOOK NO. _____
 BT. OF WAY CHECKED: _____

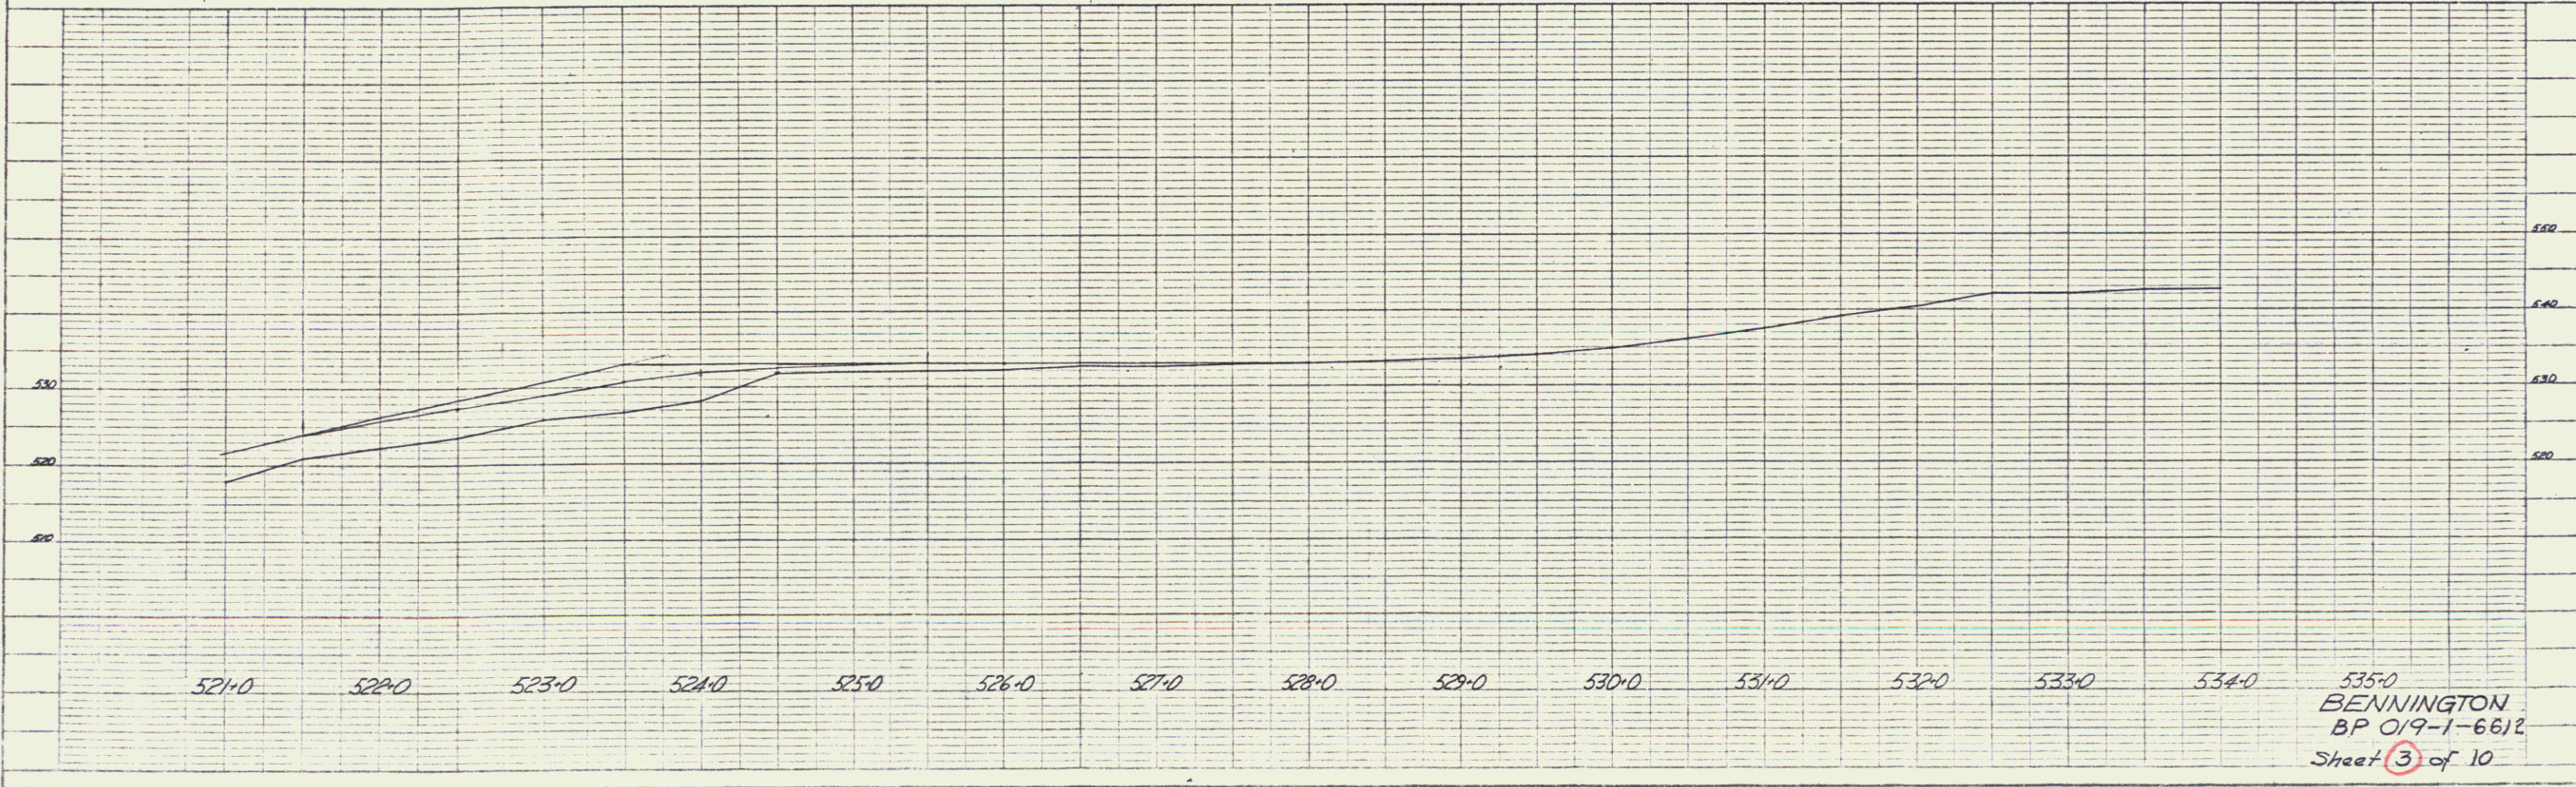

535+0
 BENNINGTON
 BP 019-1-6612
 Sheet 3 of 10