
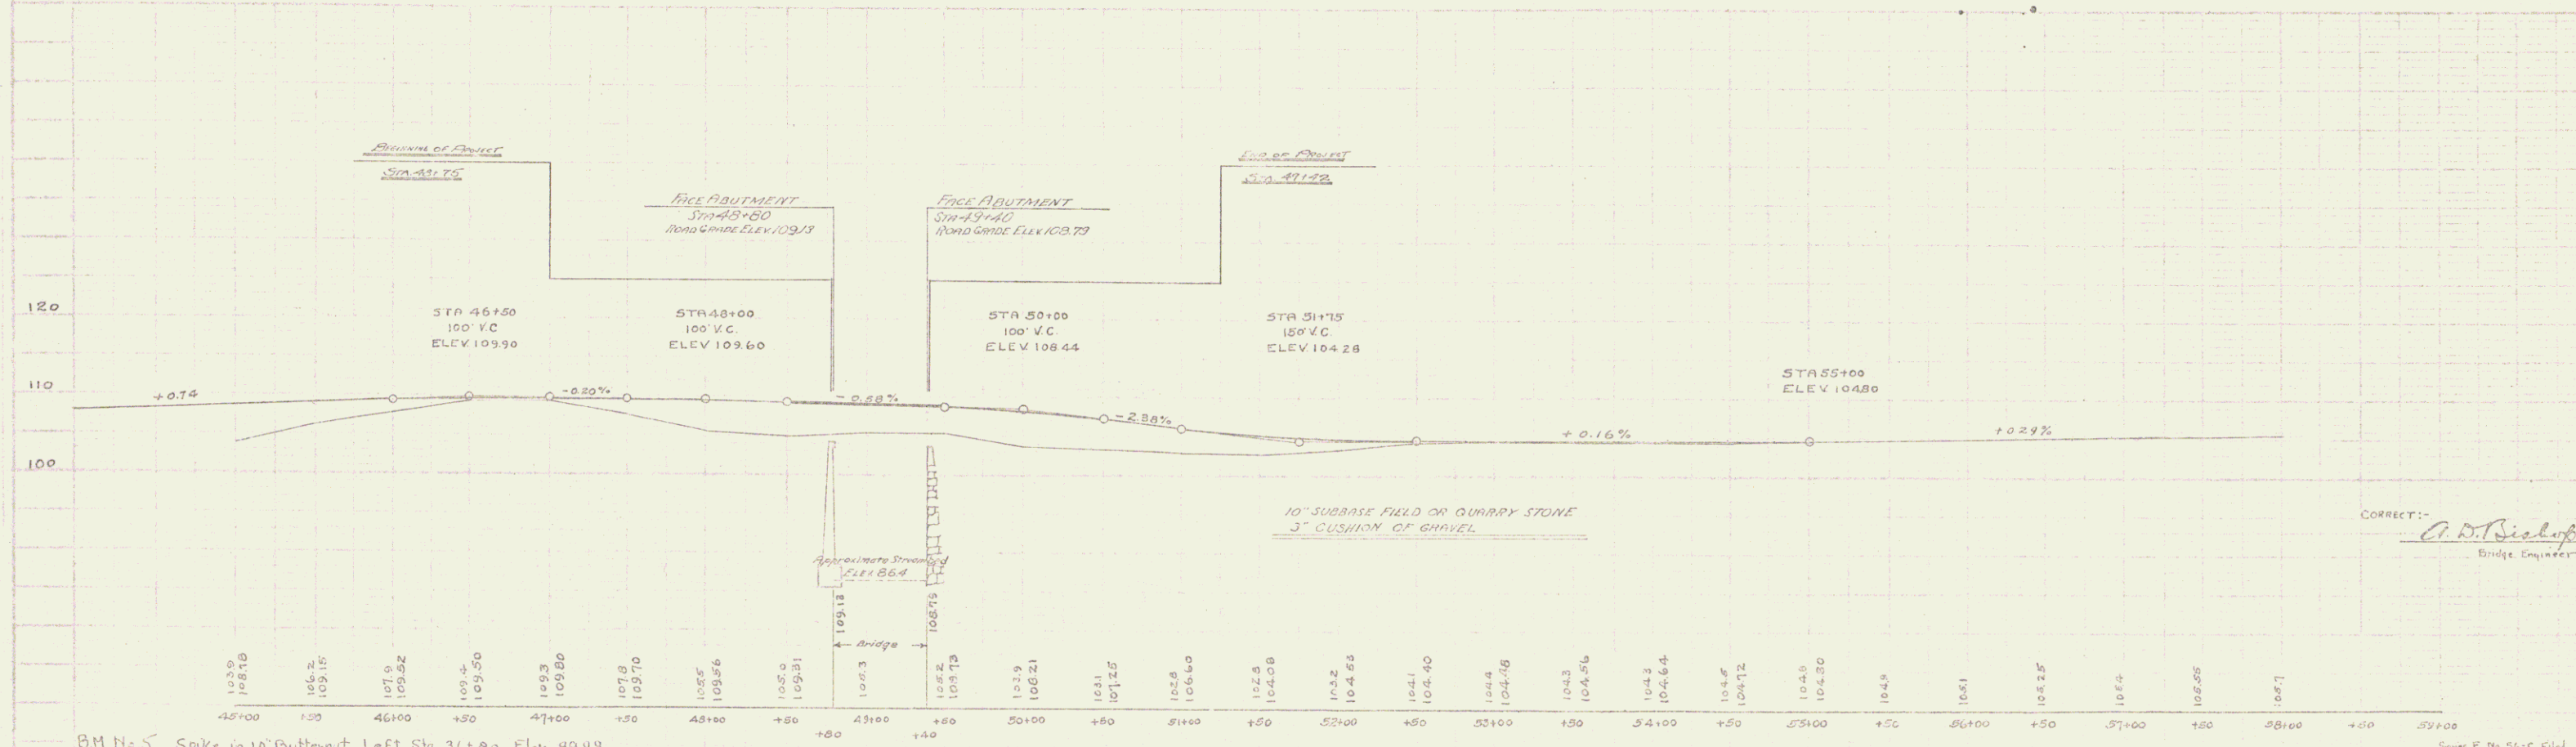


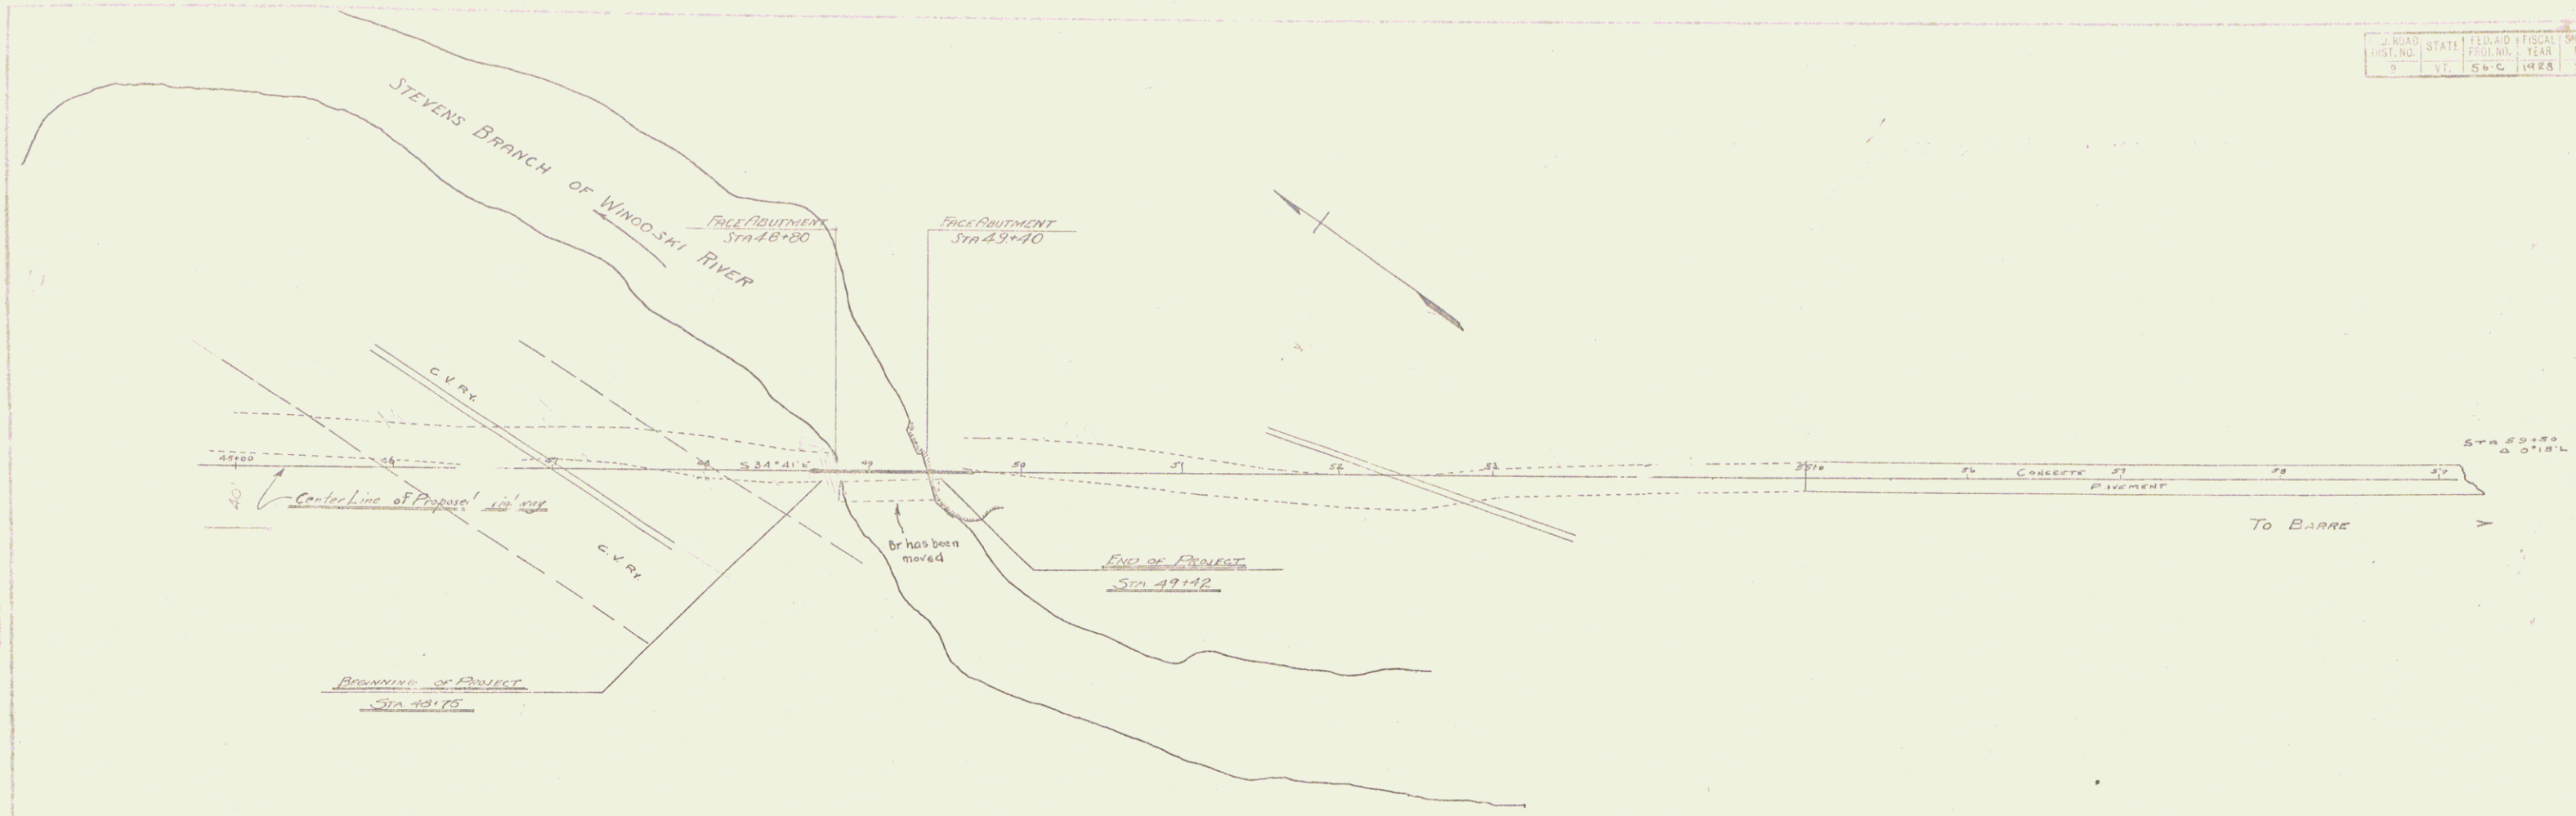

BM No 5 Spike in 10" Gutternut Left Sta 36+80 Elev. 99.49  
 BM No 6 Spike in 14" Elm Left Sta 62+23 Elev. 116.06

CORRECTED  
 A. D. Bishop  
 Bridge Engineer