


STA. 131+19
F.A.P. 56 B(1) STOPS

STA. 131+49
F.A.P. 56 B(1) RESUMES

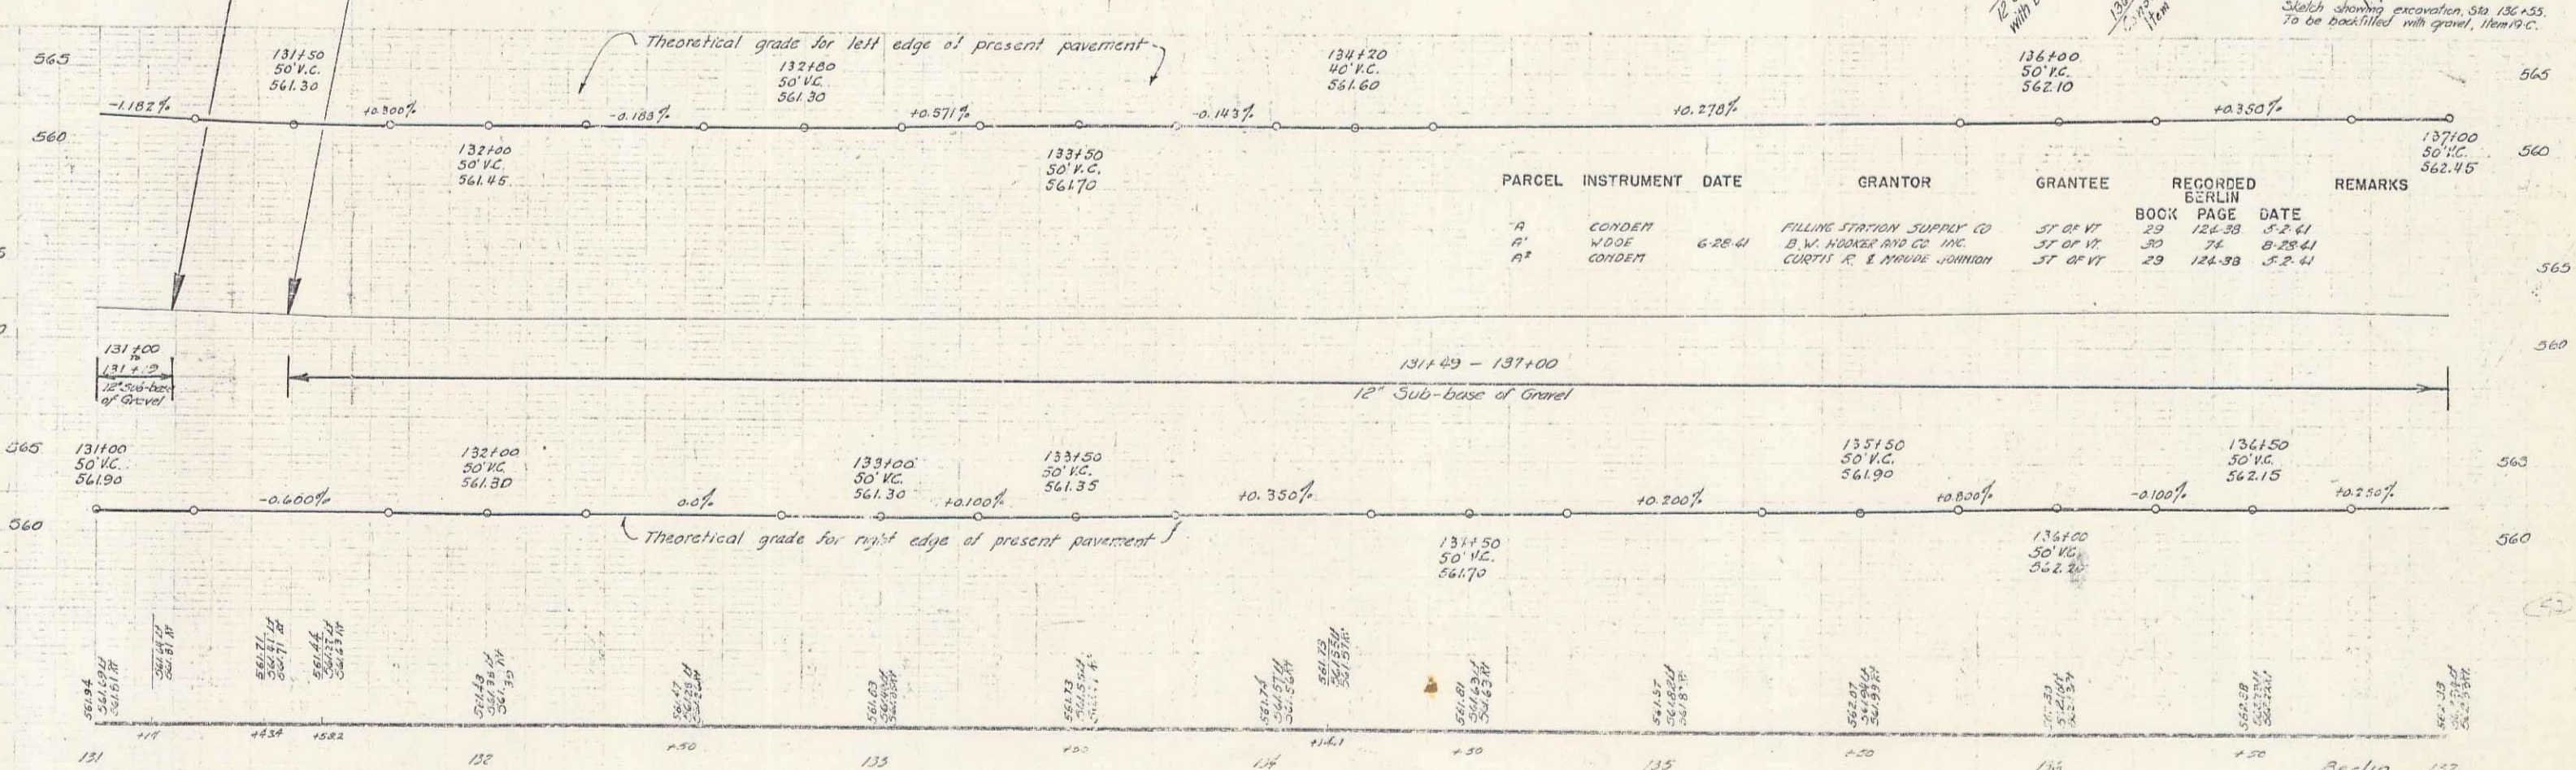

PARCEL	INSTRUMENT	DATE	GRANTOR	GRANTEE	RECORDED BERLIN	REMARKS
A	CONDEN		FILLING STATION SUPPLY CO	ST OF VT	BOOK 29 PAGE 124-38	5-2-41
A'	W.D.E	6-28-41	B.W. HOOKER AND CO. INC.	ST OF VT	29 74 B-28-41	5-2-41
A''	CONDEN		CURTIS R. & MAUDE JOHNSON	ST OF VT	29 124-38	5-2-41

Berlin 137
Series NEAR No. 53-101
Sheet 18 of 77 Sheets