


Sta. 153+35 to Sta 156+60 Lt.
Raw cut slope to be Topsoiled & Seeded
(Roadside Improvement Force Account Item)

RECORDED
DATE: 5/6/41
SHEET: 6
TOTAL SHEETS: 39

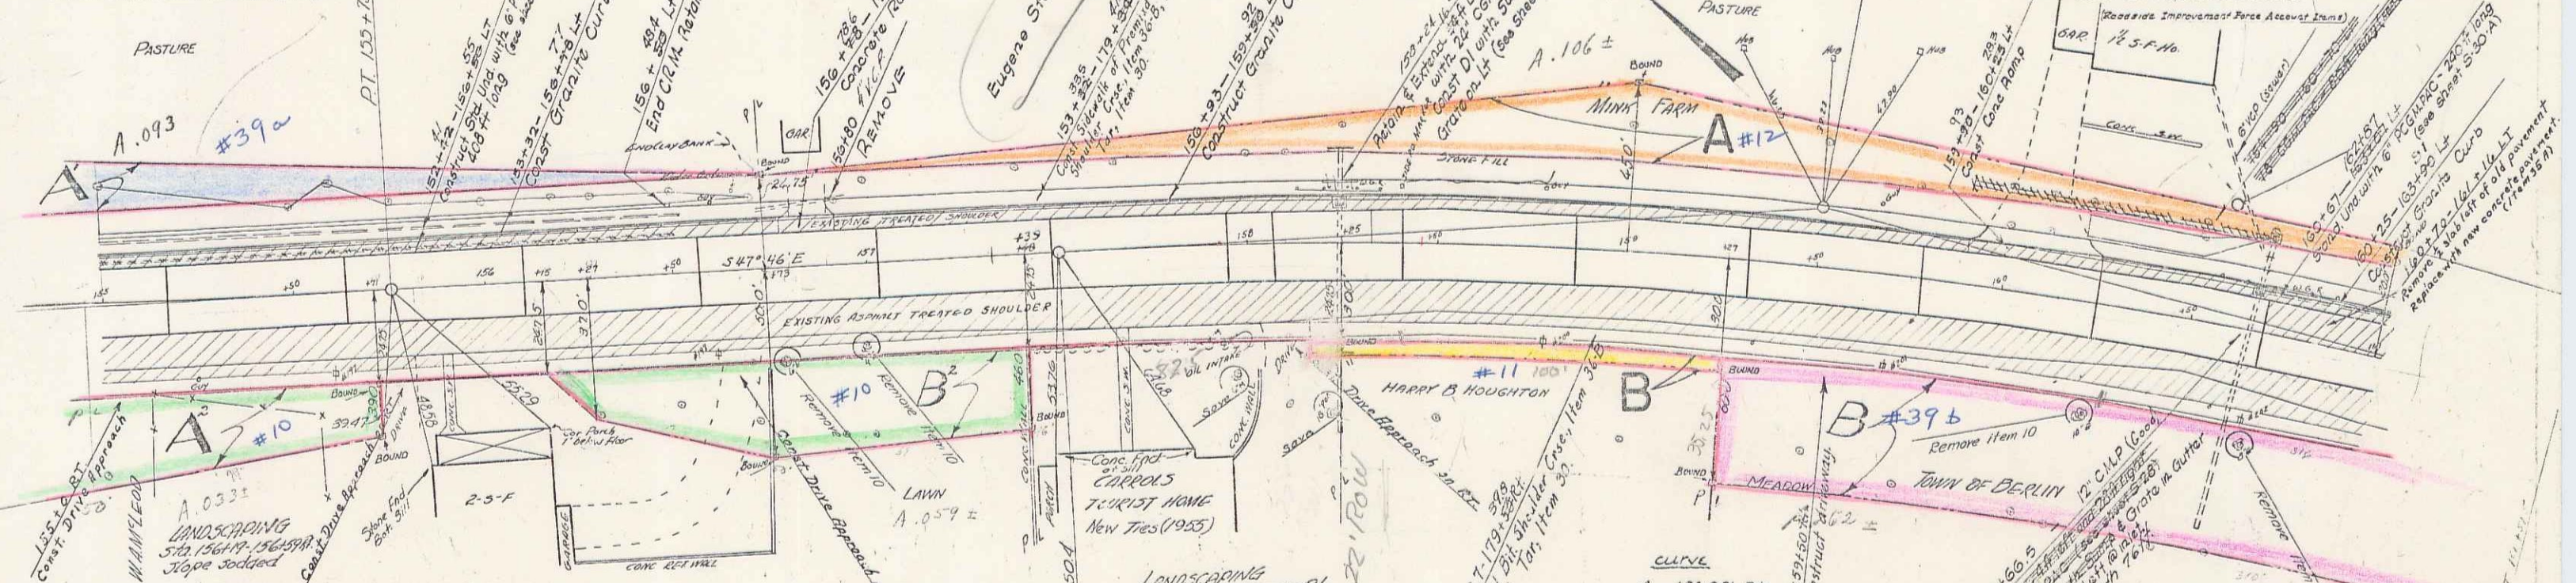


PARCEL	INSTRUMENT	DATE	GRANTOR	GRANTEE	RECORDED	REMARKS
A	W.D.O.E.	5-5-41	EUGENE STEFANAZZI	ST. OF VT. 30	59	6-20-41
B	W.D.O.E.	4-22-41	HARRY B. HOUGHTON	ST. OF VT. 30	56	6-20-41
A, B	CONDEMIT		TOWN OF BERLIN	ST. OF VT. 29	126-38	5-2-41
A, B	W.D.O.E.	6-16-41	WILLIAM E. ROBERTSON	ST. OF VT. 30	72	8-28-41

Book BERLIN
Page DATE
126-38 5-2-41
72 8-28-41

REMARKS: SLOPE EASEMENT

CURVE
Δ 18° 03' RT
D 4° 30'
R 1273.6
T 202.2
L 401.1
E 16.1

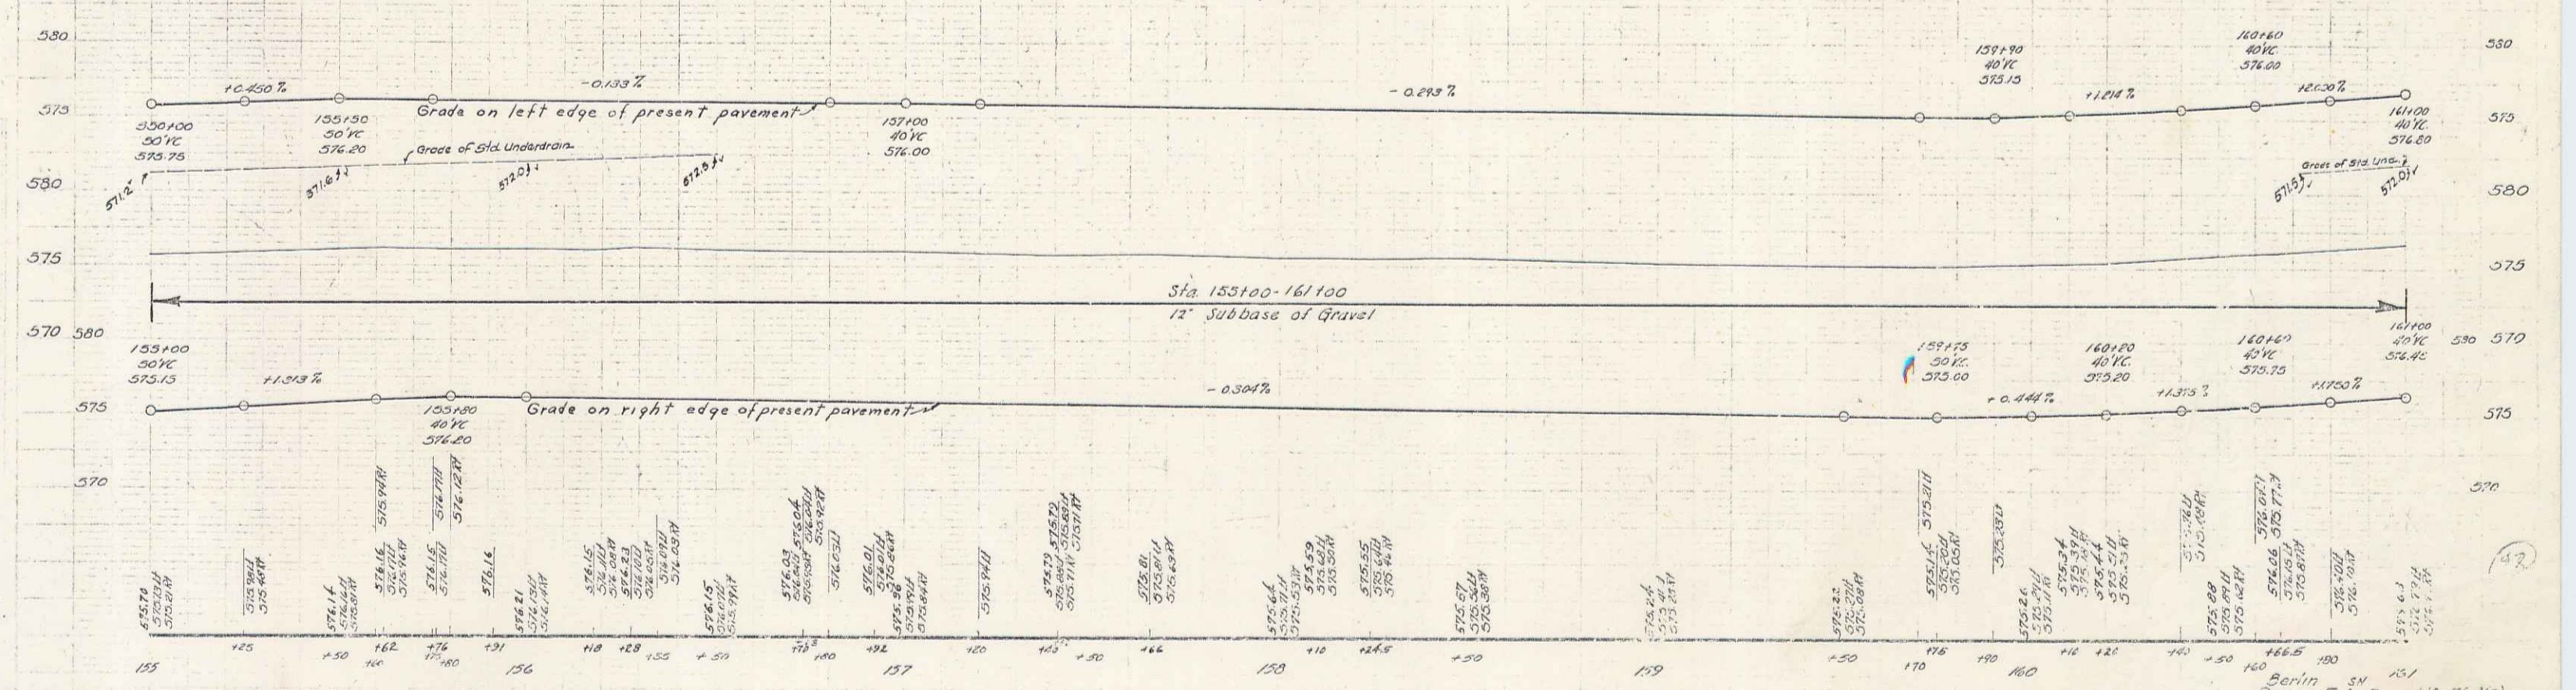

Berlin, N.Y.
Series F.A.P.
Sheet 6 of 39 Sheets