
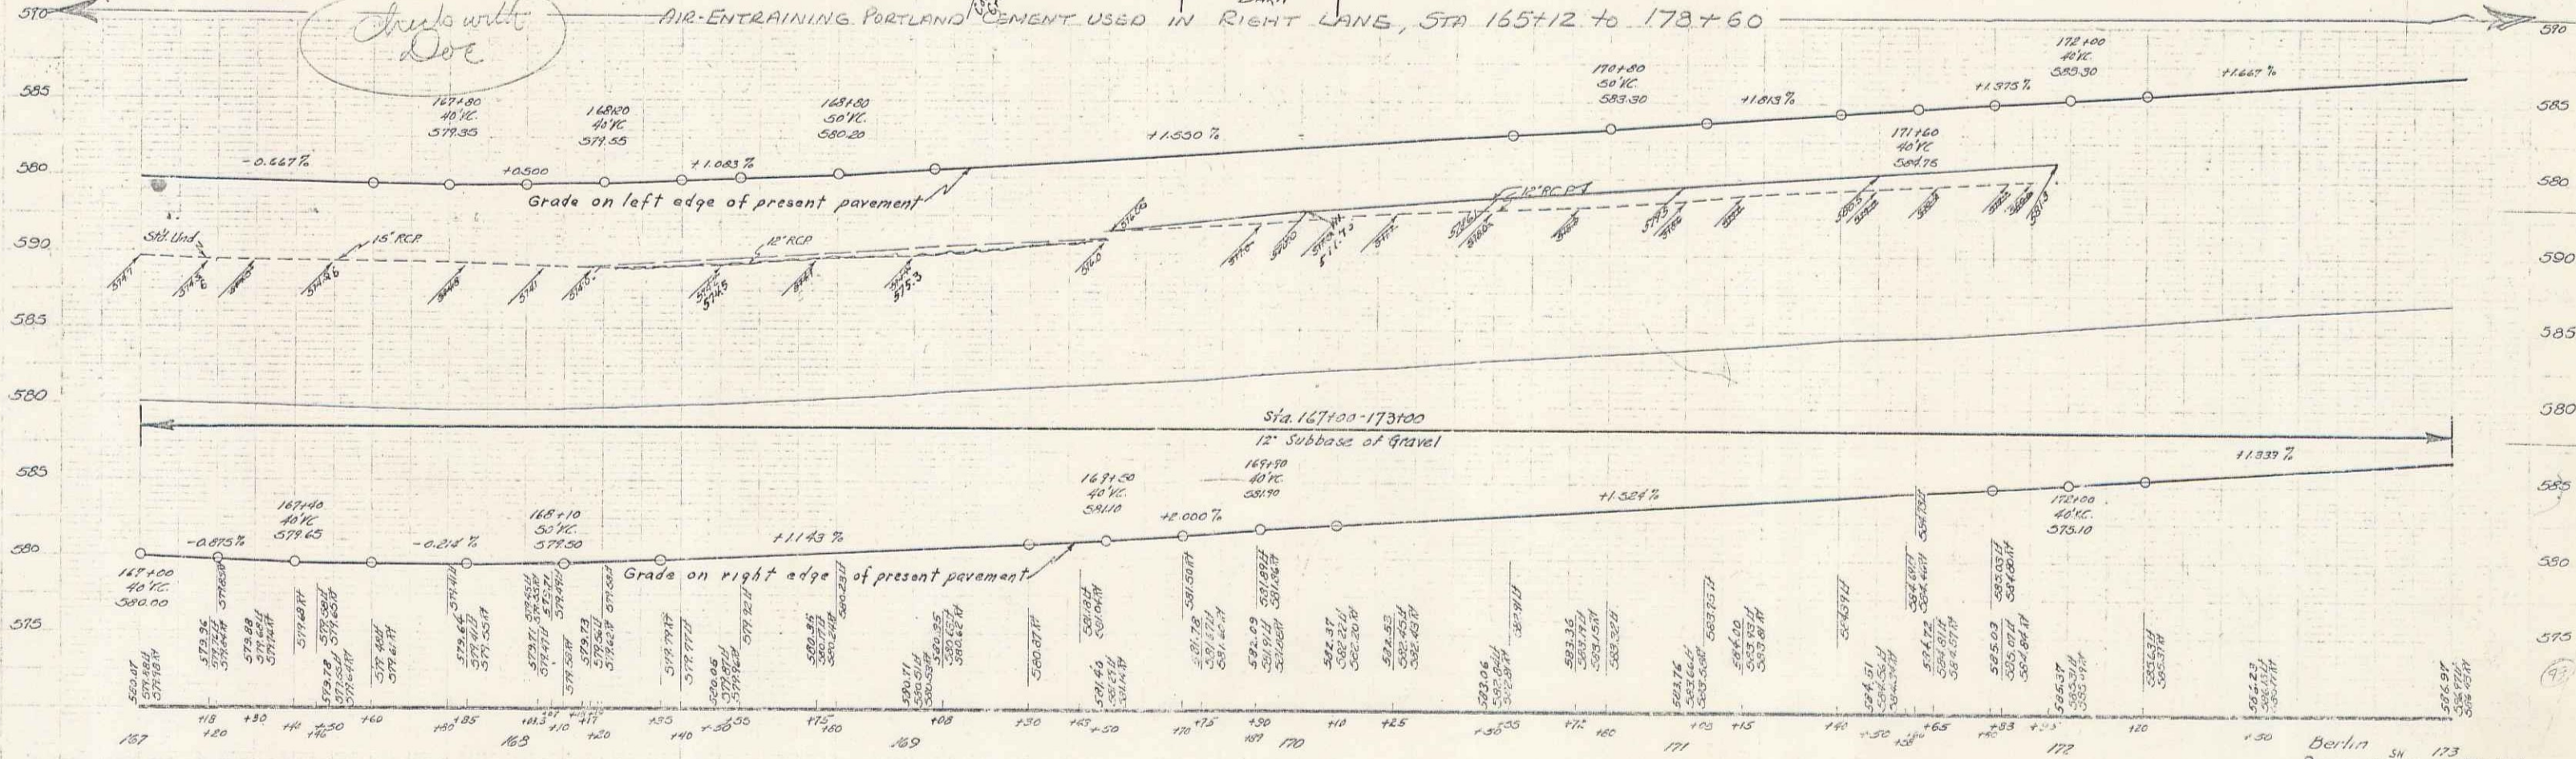


LANDSCAPING
Sta. 167+40-167+55 Lt
Slope seeded.

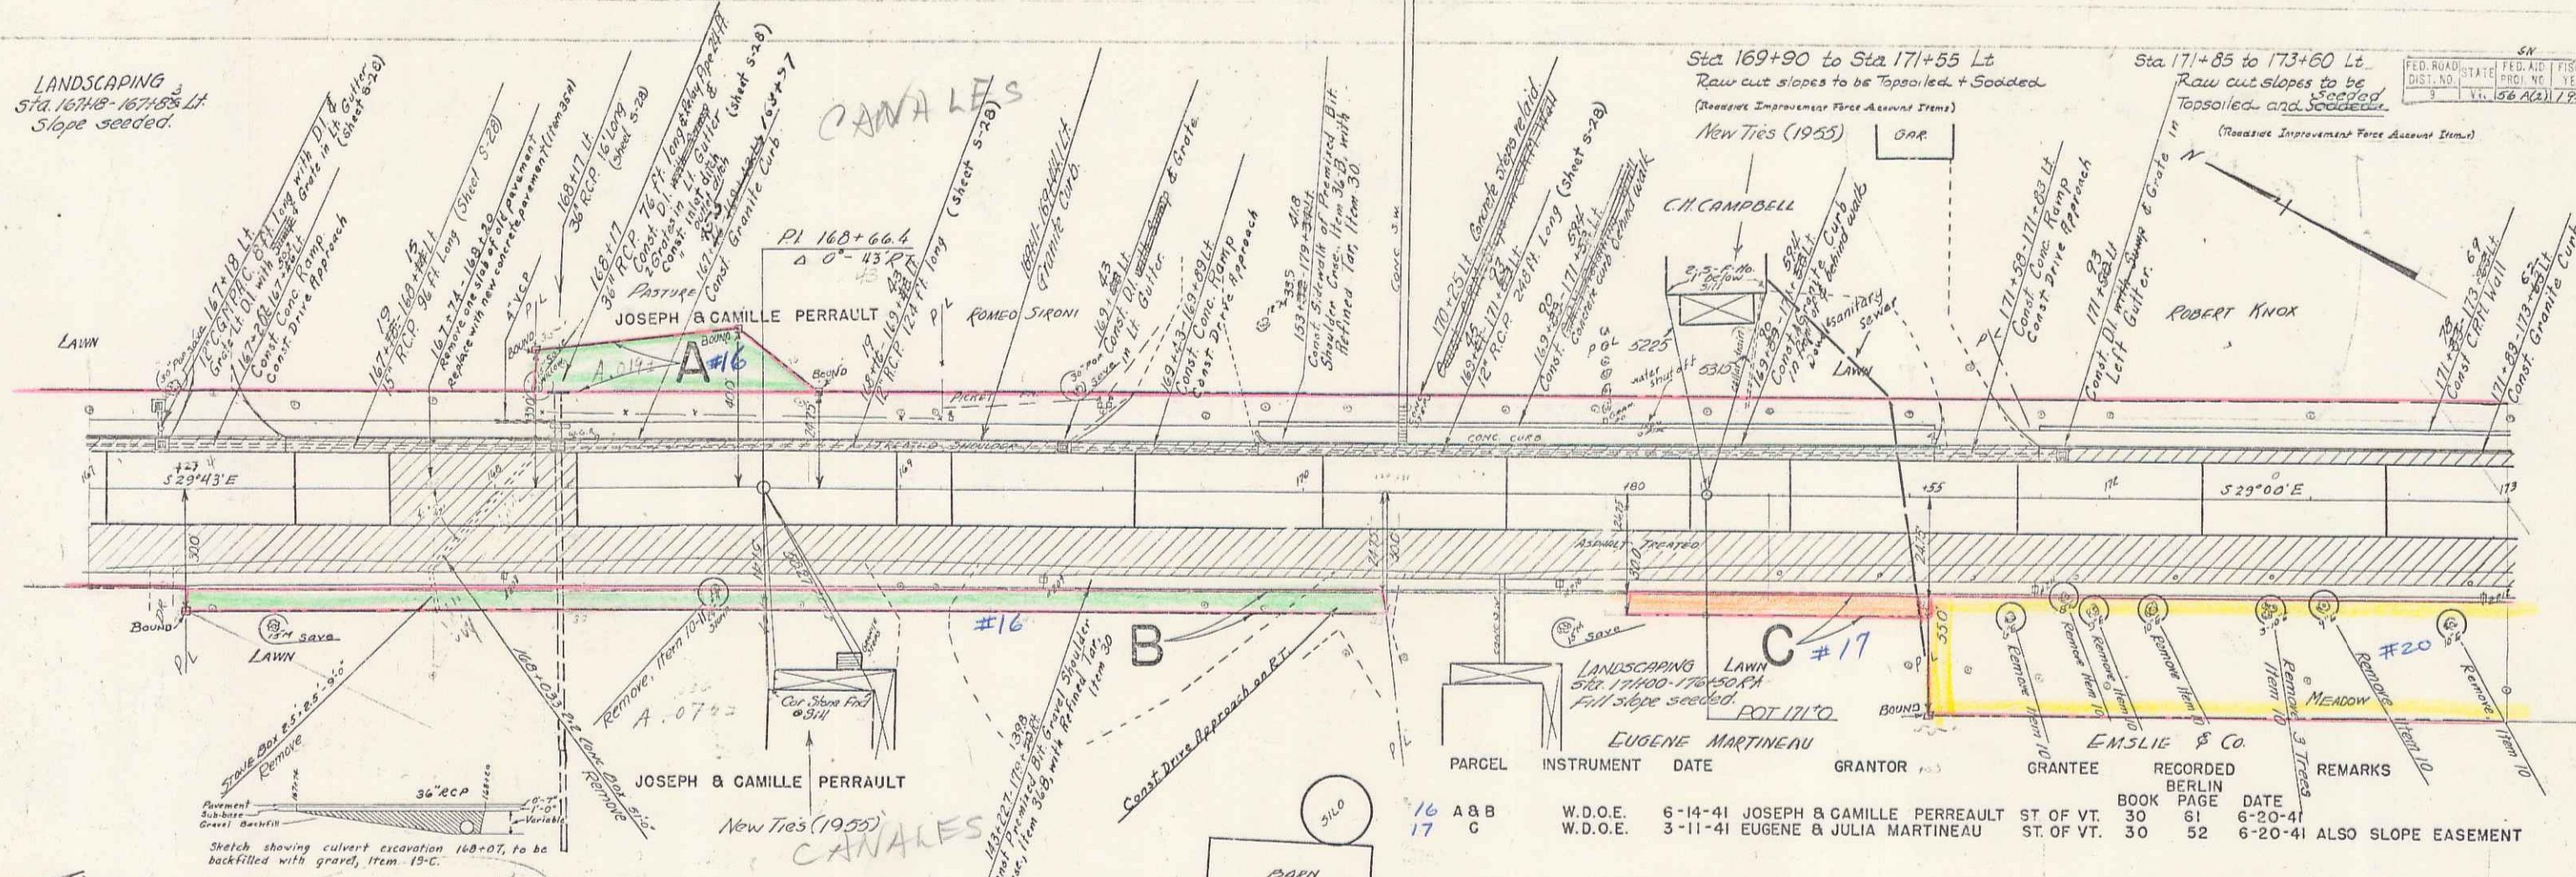

FED. ROAD DIST. NO.	STATE	FED. AID PROJ. NO.	FISCAL YEAR	SHEET NO.	TOTAL SHEETS
1	Vt.	56 (A2)	1941	8	33

Berlin Series R.A.P. No. 56-A(2)
Sheet 8 of 39 Sheets