
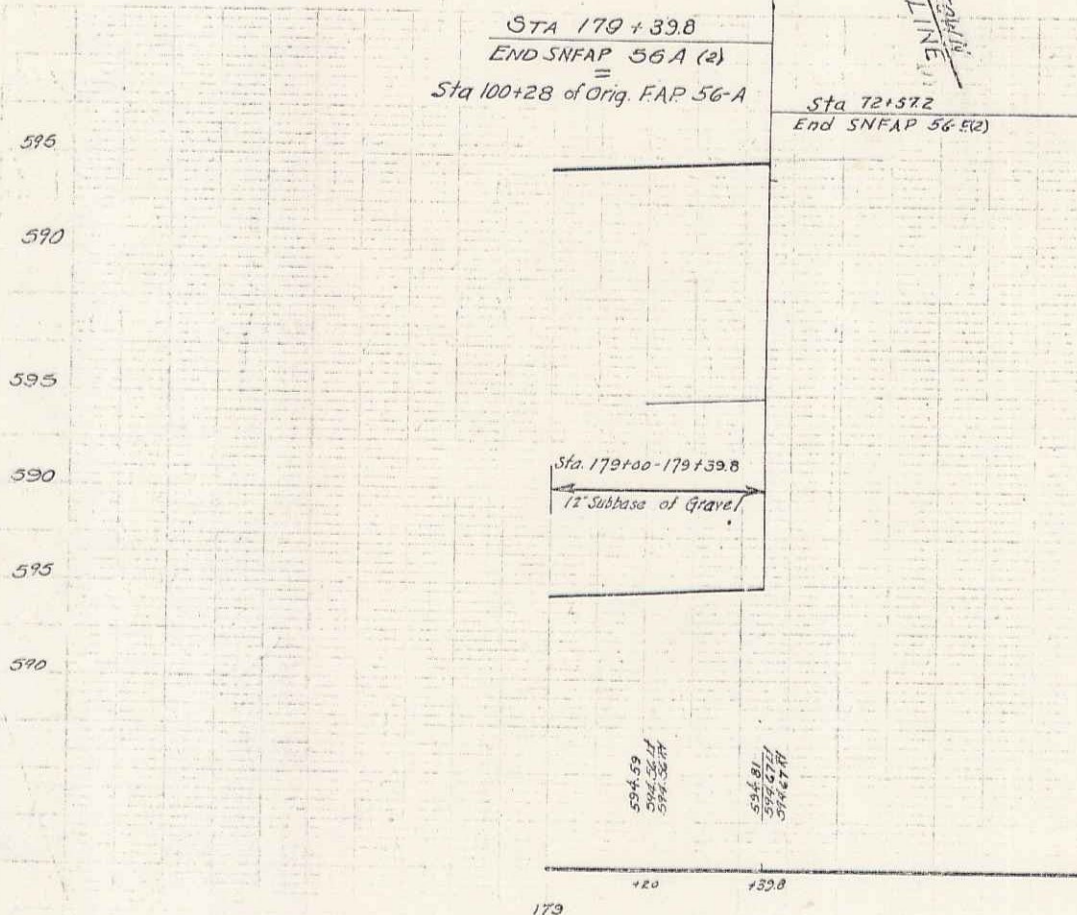


PER. YEAR	STATE	FISCAL YEAR	DATE	TOTAL
1911	MASS.	1911	10	59

$\Delta$  55° 01' RT  
 D 6° 30'  
 R 882.0  
 T 459.2  
 L 846.4  
 E 112.3

POST 70+47.2  
 $\Delta$  925 RT

POST  
 $\Delta$  22° 16' RT

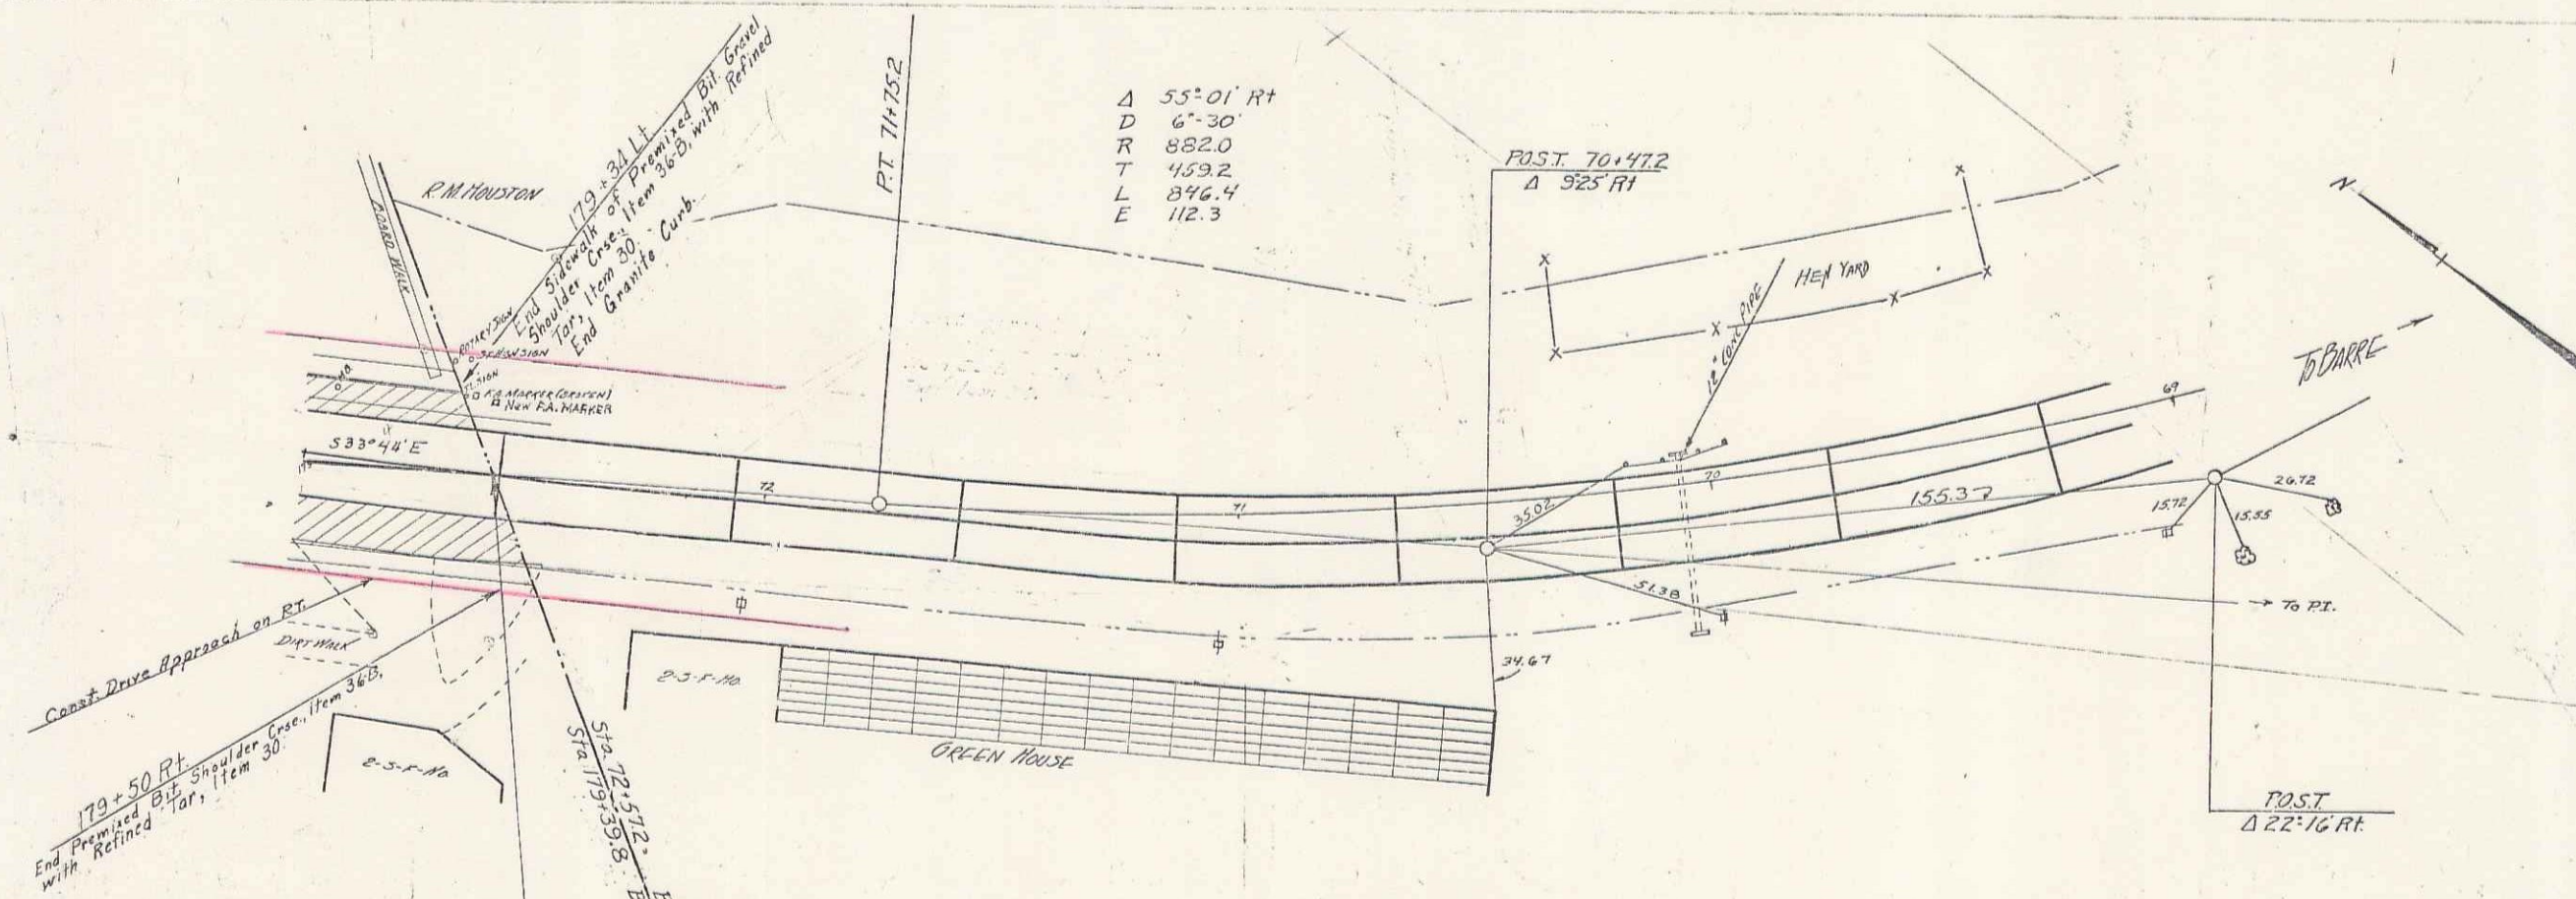

Berlin <sup>SM</sup>  
 Series F.A.P. No 56-A(2)  
 Sheet 10 of 39 Sheets.