

INDEX OF SHEETS

SHEET NO.	TITLE PAGE
1	TYPICAL CROSS-SECTION OF IMPROVEMENT
2	BANKING AND WIDENING TABLES
3	QUANTITY SHEET
4	EARTHWORK SHEET
5-6	PLAN AND PROFILE
7-10	PLAN AND BARREL SECTION
11	BOX DETAILS
12	STANDARD STRUCTURE SHEET
13	50-1 BRIDGE DETAILS
14	28 PIPE CULVERTS
15	30A DRAINAGE STRUCTURES
16	40 BARRICADES, SIGNS, & LIGHTS
17	41 ROUNDING OF SLOPES
18	48 GUARD RAIL
19	21-28 CROSS SECTIONS

2 1/2" CRUSHED GRAVEL MIXED-IN-PLACE SURFACE COURSE WITH GUTBACK ASPHALT, AND PRIME COAT OF REFINED TAR, ITEMS 26, 30, 31


STATE OF VERMONT
STATE HIGHWAY DEPARTMENT

PLAN AND PROFILE OF PROPOSED
STATE HIGHWAY
FEDERAL PROJECT

TOWN OF BARRE Pin# 99R548
BARRE-EAST BARRE ROAD
U.S. ROUTE 302


BEGINNING AT A POINT APPROXIMATELY 4015 FEET EASTERLY OF THE BARRE CITY—
BARRE TOWN LINE AND EXTENDING EASTERLY 1350.0 FEET
LENGTH OF PROJECT 1350.0 FEET = 0.256 MILES

FED. ROAD DIST. NO.	STATE	PROJ. NO.	SERIAL SHEET	TOTAL SHEETS
9	Vt.	1177	1	28

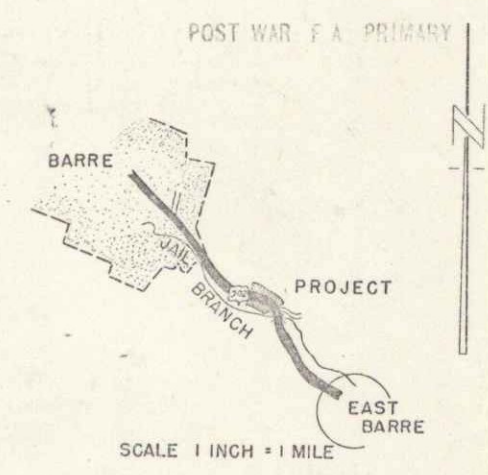

STANDARD STRUCTURE SHEETS APPROVED BY THE CHIEF ENGINEER
VERMONT STATE DEPT. OF HIGHWAYS

S 28 APRIL 26, 1944
S 30A APRIL 19, 1944
S 40 DEC 18, 1945

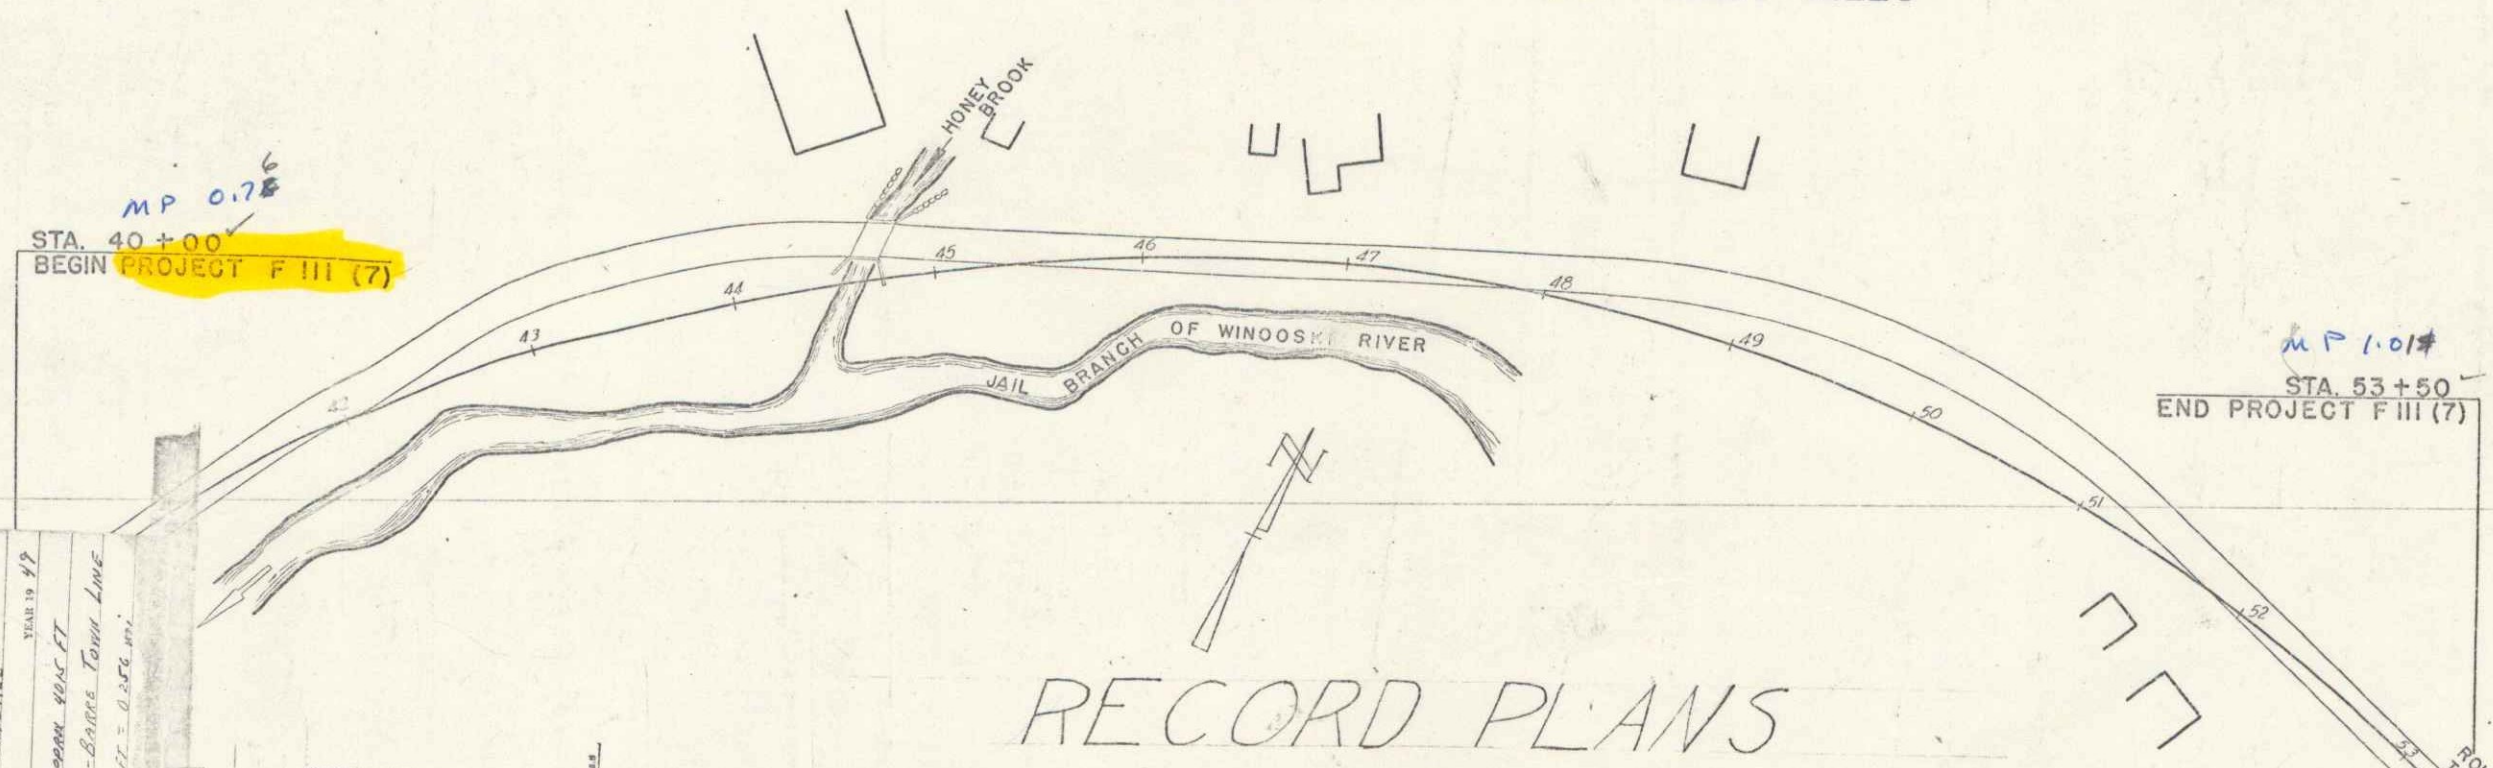

RECORD PLANS

Prepared by M.L. Bliss & L.R. Magnant
Resident Engineers - T. Dudley & R. Kere

PROJECT: BARRE
NUMBER: F-1177
DATE: 7-1-44
CONTRACTOR: Leo R. Adams, I. Lapeere
LOCATION: Beginning at a point approx. 4015 feet easterly of the Barre City-East Barre Town Line and extending easterly 1350.0 feet = 0.256 miles.

RECORD PLANS

DESCRIPTION	DATE	BY
Checked for Error & Omission	July 13, 1944	T. Dudley & R. Kere
Checked for Compliance with 1939 Specifications	July 13, 1944	T. Dudley & R. Kere

CURVE DATA

DEFLECTION ANGLE	Δ
DEGREE OF CURVE	D
RADIUS OF CURVE	R
TANGENT DISTANCE	T
LENGTH OF CURVE	L
EXTERNAL DISTANCE	E
POINT OF INTERSECTION	P. I.
POINT OF CURVE	P. C.
POINT OF TANGENT	P. T.
POINT ON TANGENT	P. O. T.

SCALES

TITLE	1" = 50'
TYPICAL	1" = 2'
PLAN	1" = 20'
PROFILE HORIZONTAL	1" = 20'
PROFILE VERTICAL	1" = 10'
CROSS SECTIONS	1" = 5'

THESE PLANS ARE SUBJECT TO SUCH REVISIONS AS MAY BE REQUIRED BY THE PUBLIC ROADS ADMINISTRATION OR THE COMMISSIONER OF HIGHWAYS.
CONSTRUCTION IS TO BE CARRIED ON IN ACCORDANCE WITH THE PLANS AND THE STANDARD ROAD AND BRIDGE SPECIFICATIONS OF 1934 AS APPROVED DECEMBER 23, 1934 BY THE PUBLIC ROADS ADMINISTRATION, INCLUDING ALL SUBSEQUENT APPROVED REVISIONS AND SUCH REVISED SPECIFICATIONS AND SPECIAL PROVISIONS AS ARE SUBMITTED WITH THE PLANS.

APPROVED: 26 July 44
H. E. Sauguet
COMMISSIONER OF HIGHWAYS

APPROVED: [Signature] Highway Engineer
APPROVED: [Signature] District Highway Commissioner
SERIES F NO. 1177 FILED
SHEET 1 OF 28