


Construct Drains
 Lt. Rt.
 45+40
 46+30
 46+50


Sta. 42+00 to 44+58 LL
 Gravel for fill mass to replace old
 pavement and make parking area. Pave gravel

POST WAR F.A. PRIMARY
 111(7) 8 28

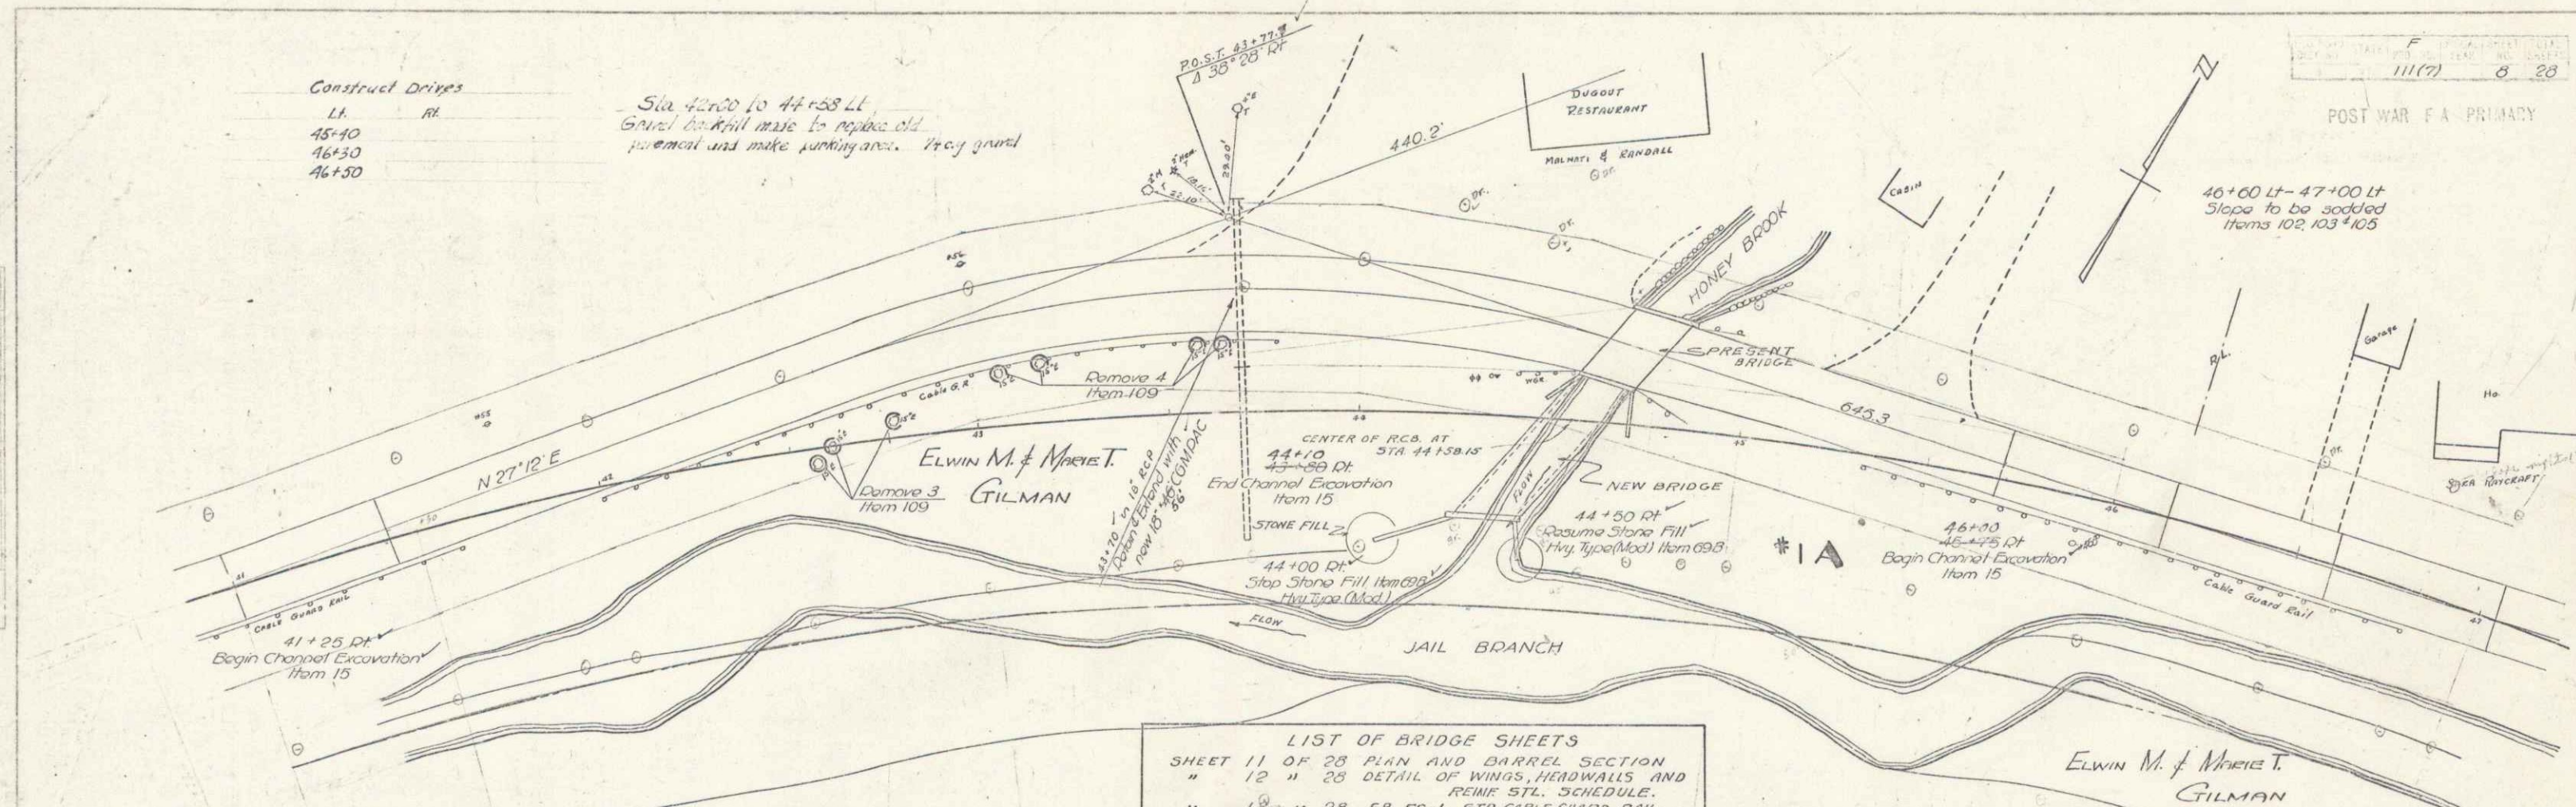

LIST OF BRIDGE SHEETS
 SHEET 11 OF 28 PLAN AND BARREL SECTION
 " 12 " 28 DETAIL OF WINGS, HEADWALLS AND
 REIN. STL. SCHEDULE.
 " 13 " 28 SB-SC-1, STD. CABLE GUARD RAIL.
 " 14 " 28 SB-U, BARRICADED SIGNS, LIGHTS.

CURVE DATA
 Δ 80° 48' RT
 D 6° 33'
 R 875.2
 T 744.5
 L 1233.6
 E 274.0

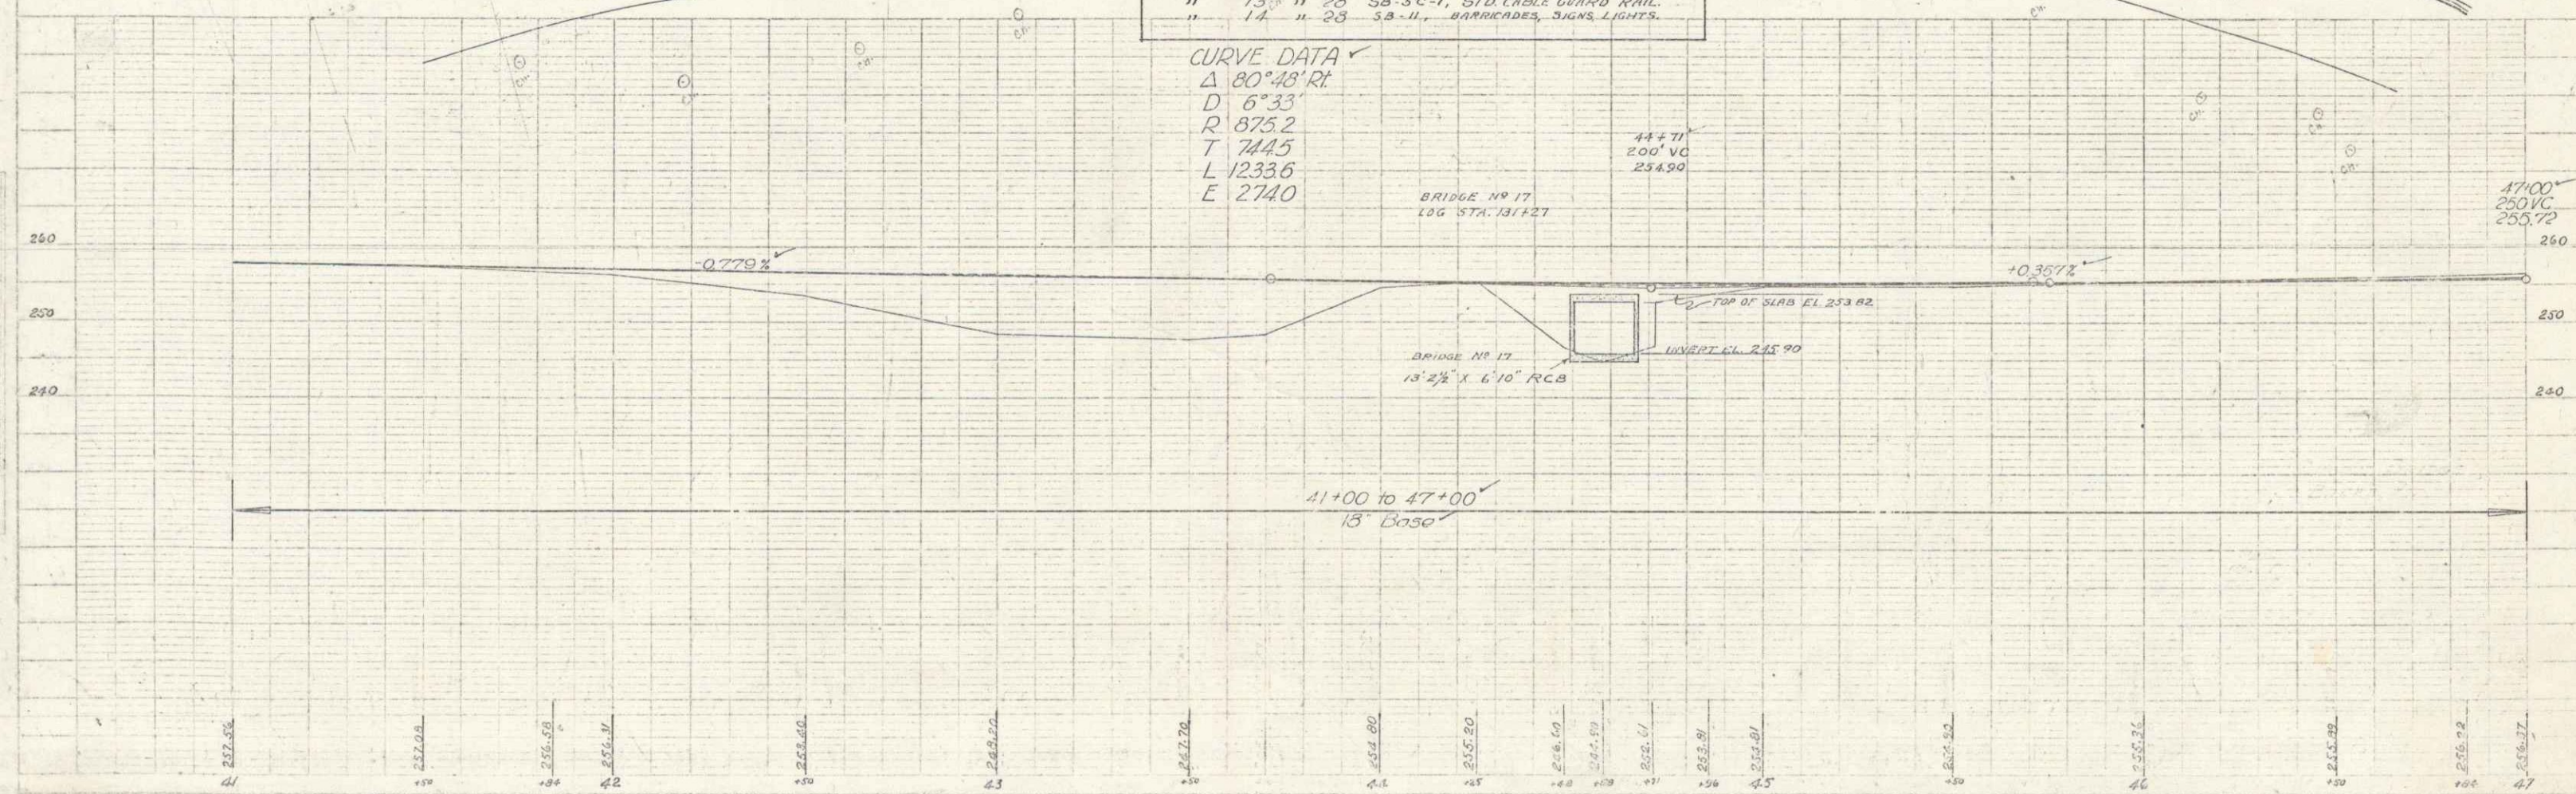

BRIDGE
 Series F no. 111(7)
 Sheet 11 of 28 sheets