
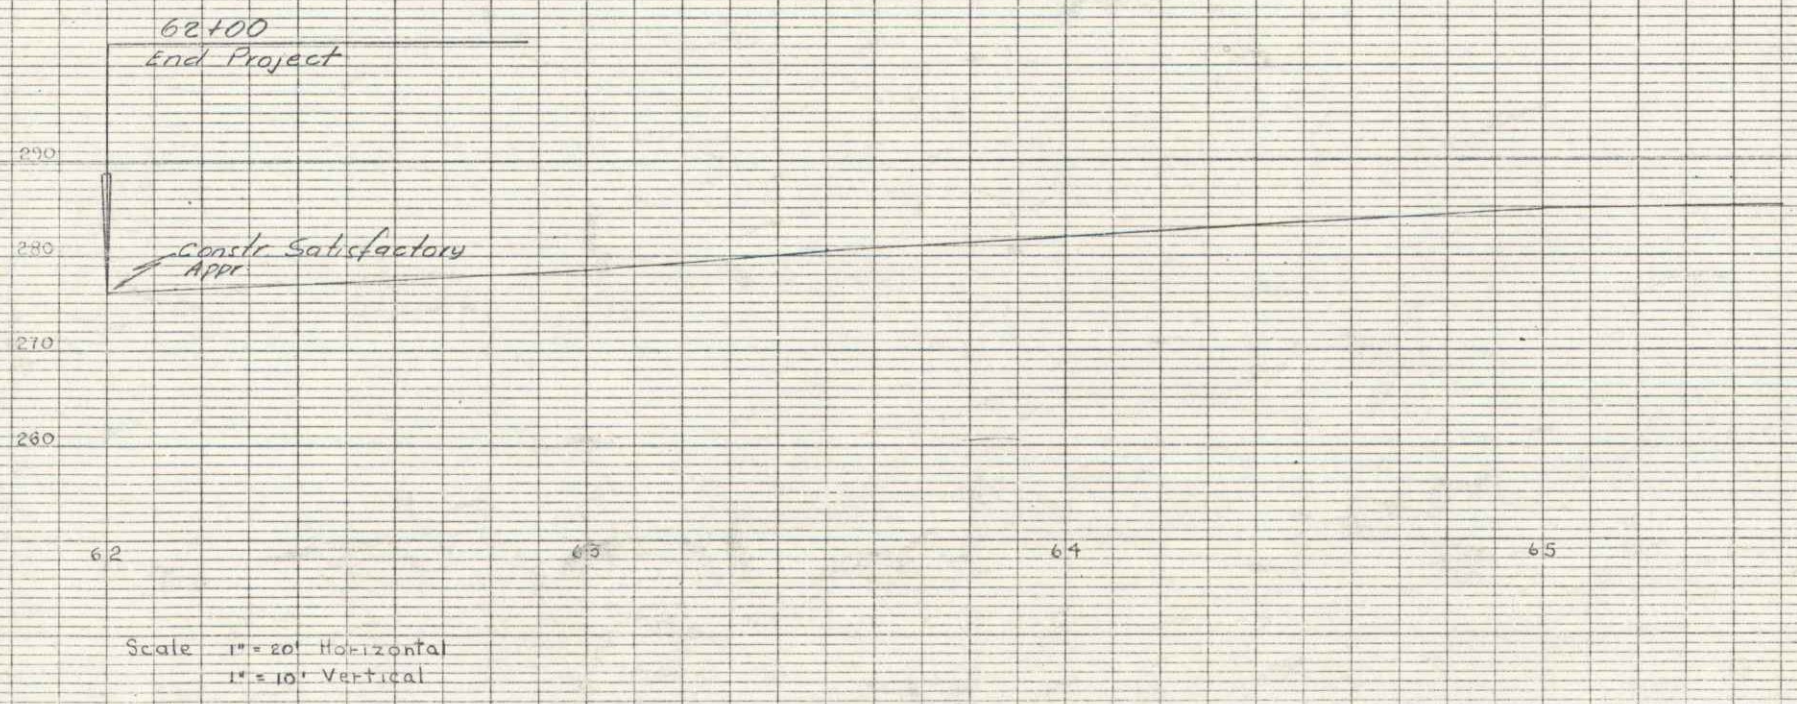


PLAN
 REVISED BY
 DATE CHECKED
 BY OF THE PROJECT

PROJ. NO.
 DATE
 CHECKED BY
 DATE OF THE PROJECT

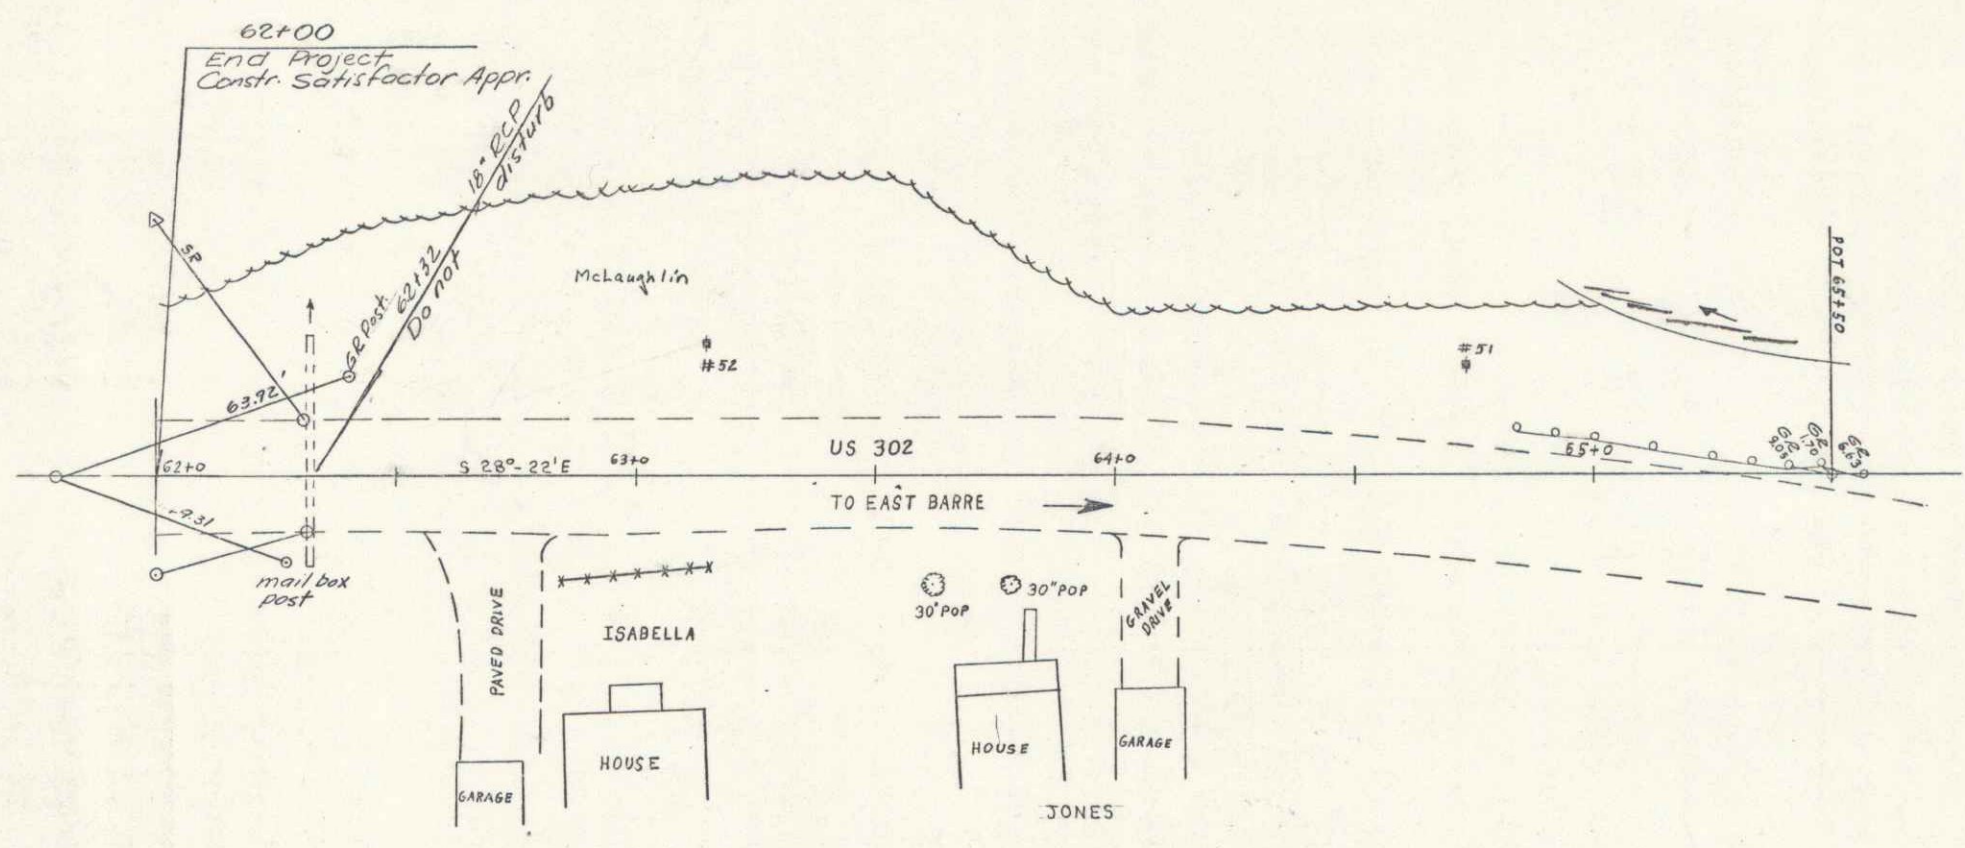

Scale 1" = 20' Horizontal
 1" = 10' Vertical

BARRE TOWN US 302
 BP 026-1-7101
 SHEET 6 OF 8

K&E PLATE 1, PLAN AND PROFILE
 PENNELL & BUCK CO.