


BP

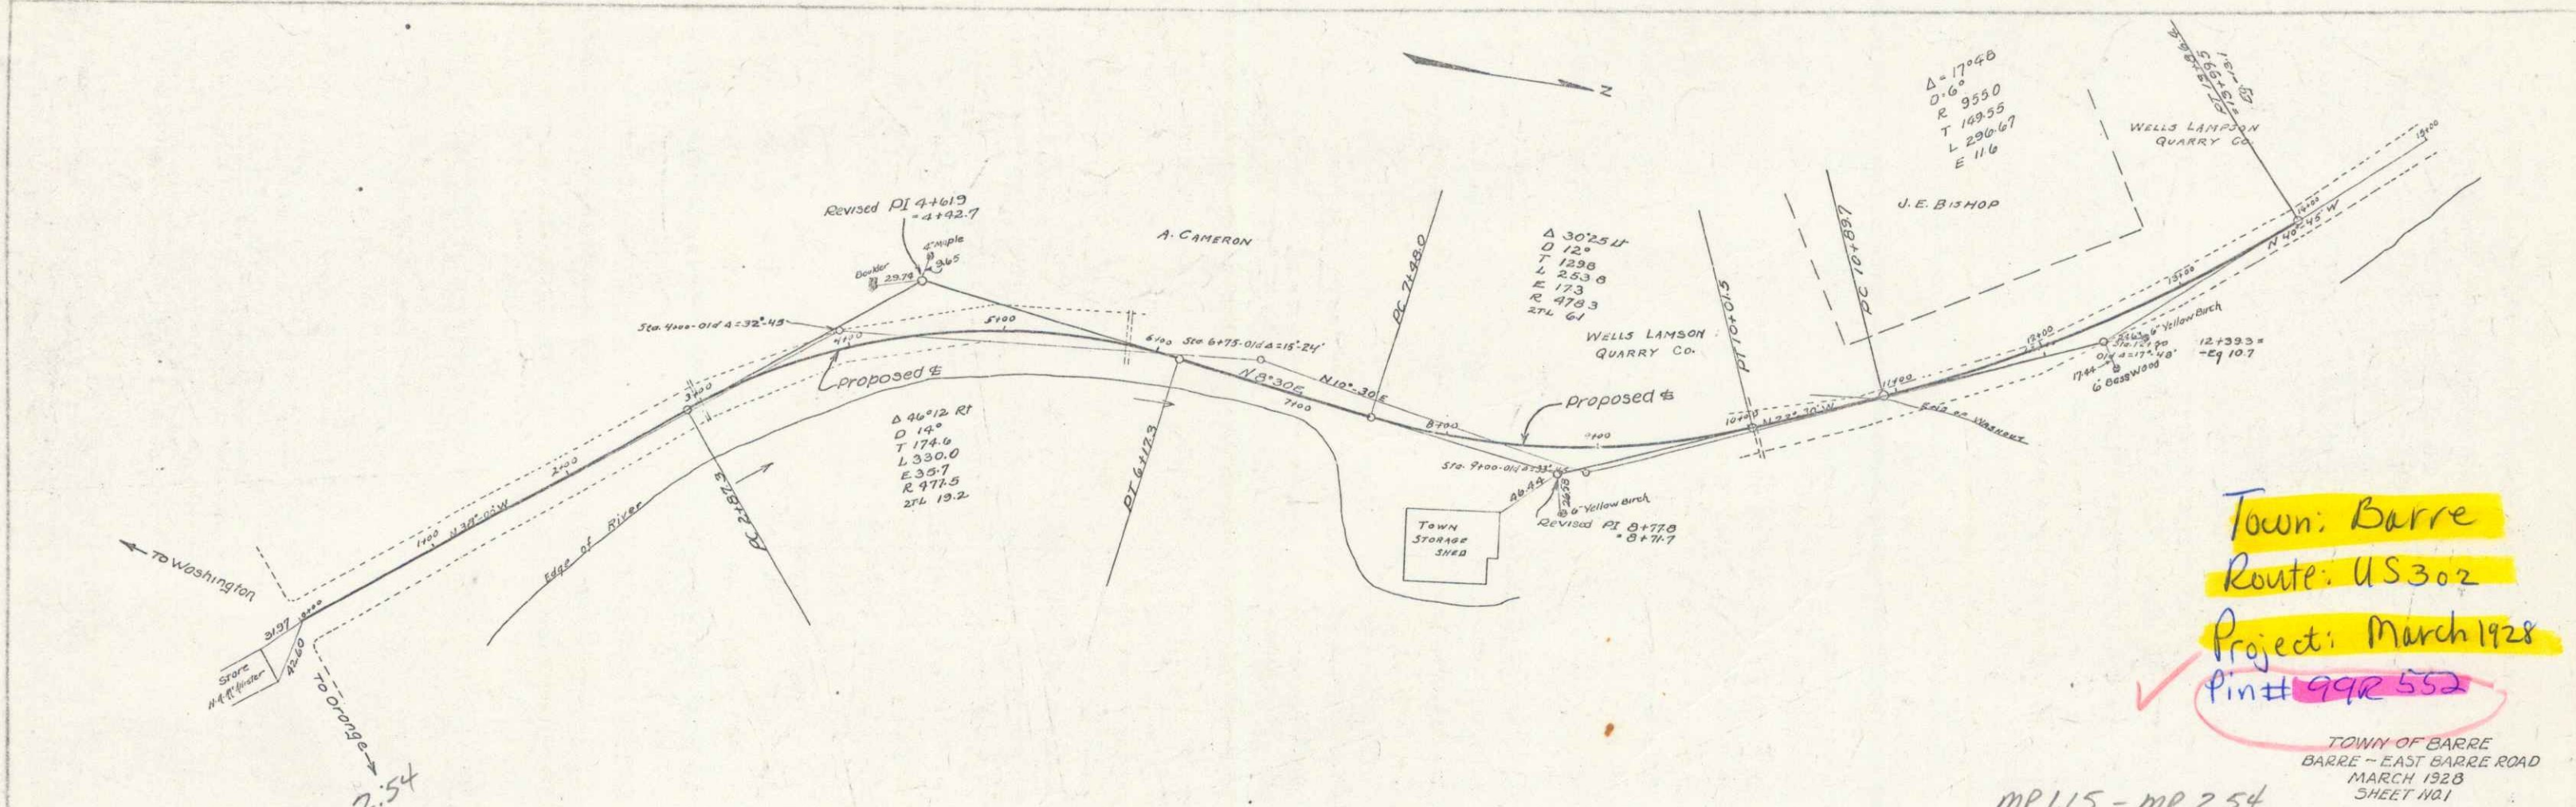


Town: Barre

Route: US 302

Project: March 1928

Pin # 99R 552

TOWN OF BARRE  
 BARRE - EAST BARRE ROAD  
 MARCH 1928  
 SHEET NO 1  
 MP 1.15 - MP 2.54  
 Old US 302 (Present TH 125)

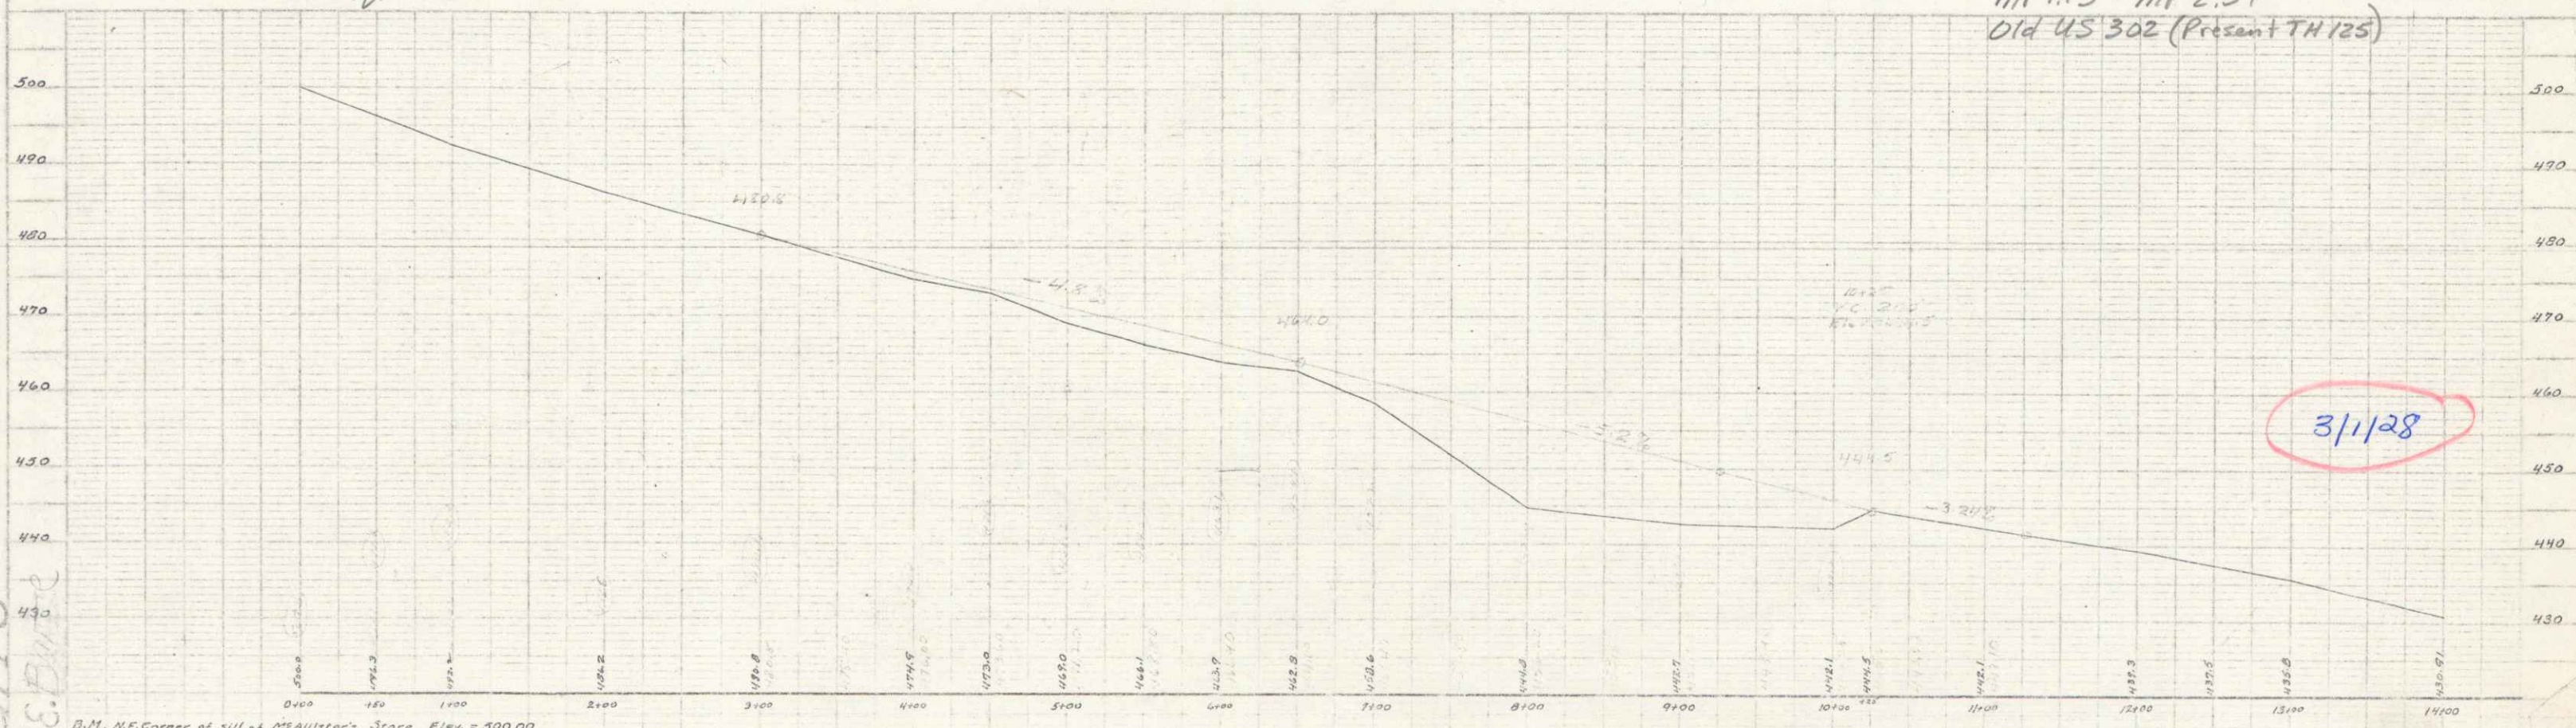

3/1/28

Barre  
Ba. E. Bird

D.M. NE Corner of sill of Ashlister's Stone. Elev = 300.00



Historical  
 STEARNS R. JENKINS  
 SHEET NO 1  
 US 302






PLAN  
 DATE  
 BY  
 CHECKED BY  
 TITLE


VERTICAL CURVE  
 DATE  
 BY  
 CHECKED BY  
 TITLE

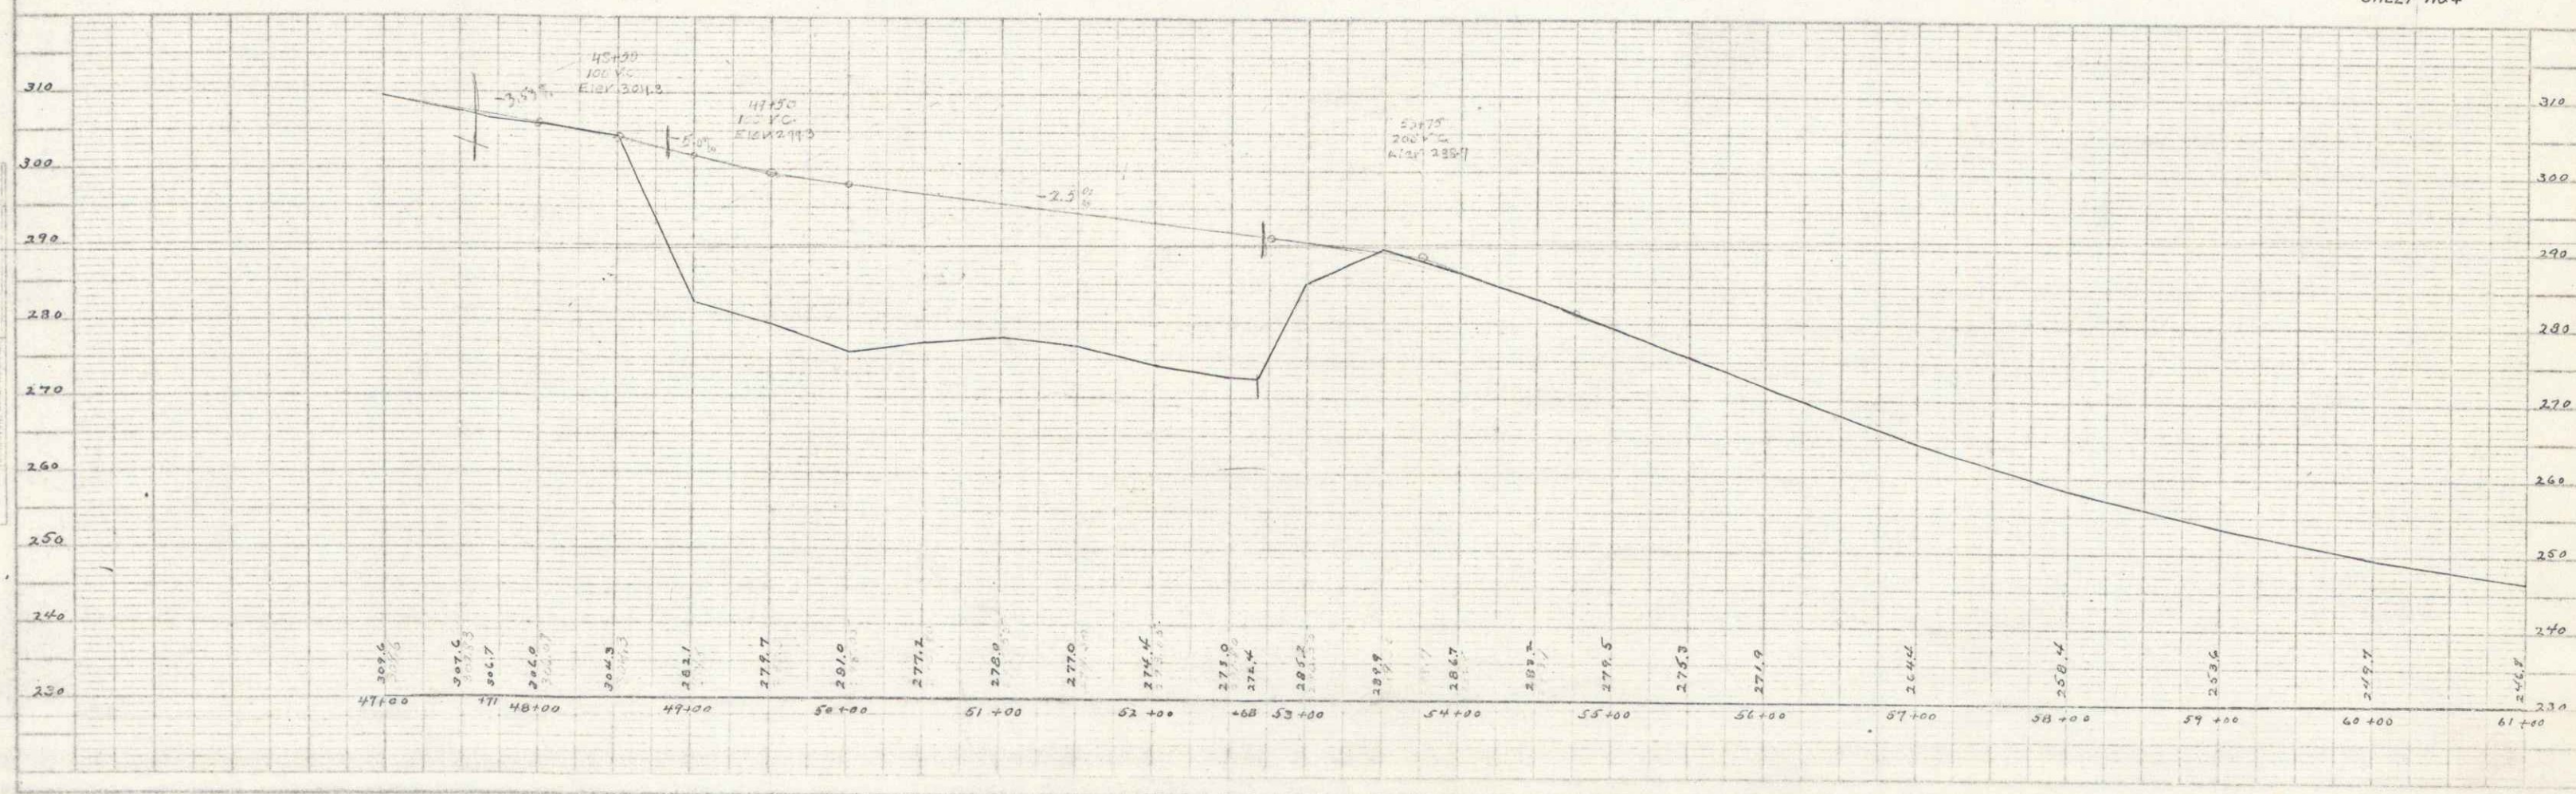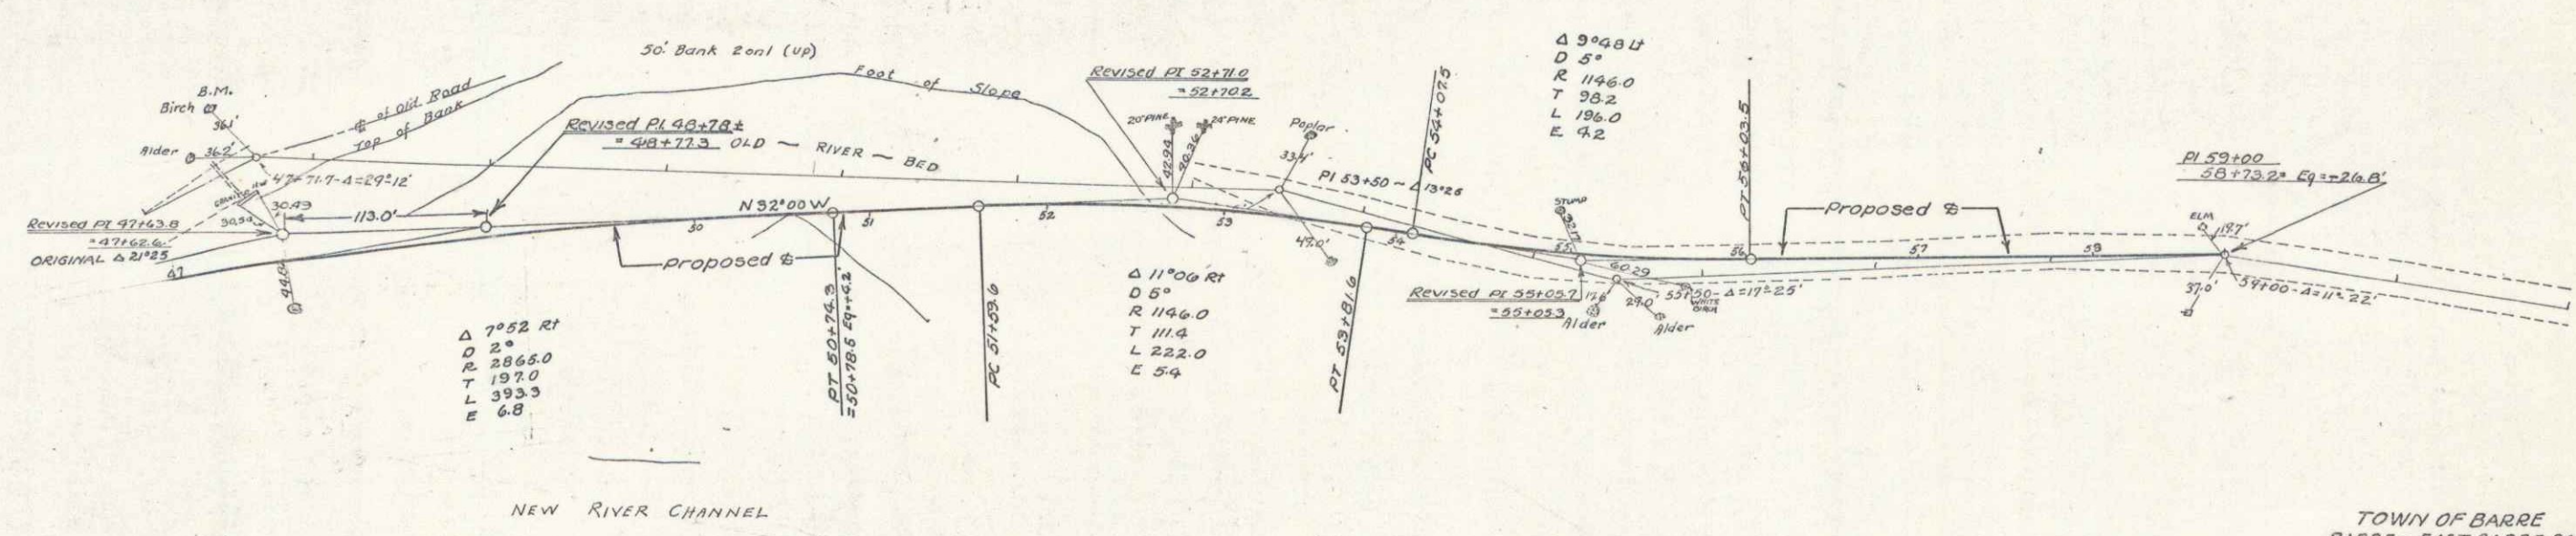

TOWN OF BARRE  
 BARRE - EAST BARRE ROAD  
 MARCH 1928  
 SHEET NO. 4

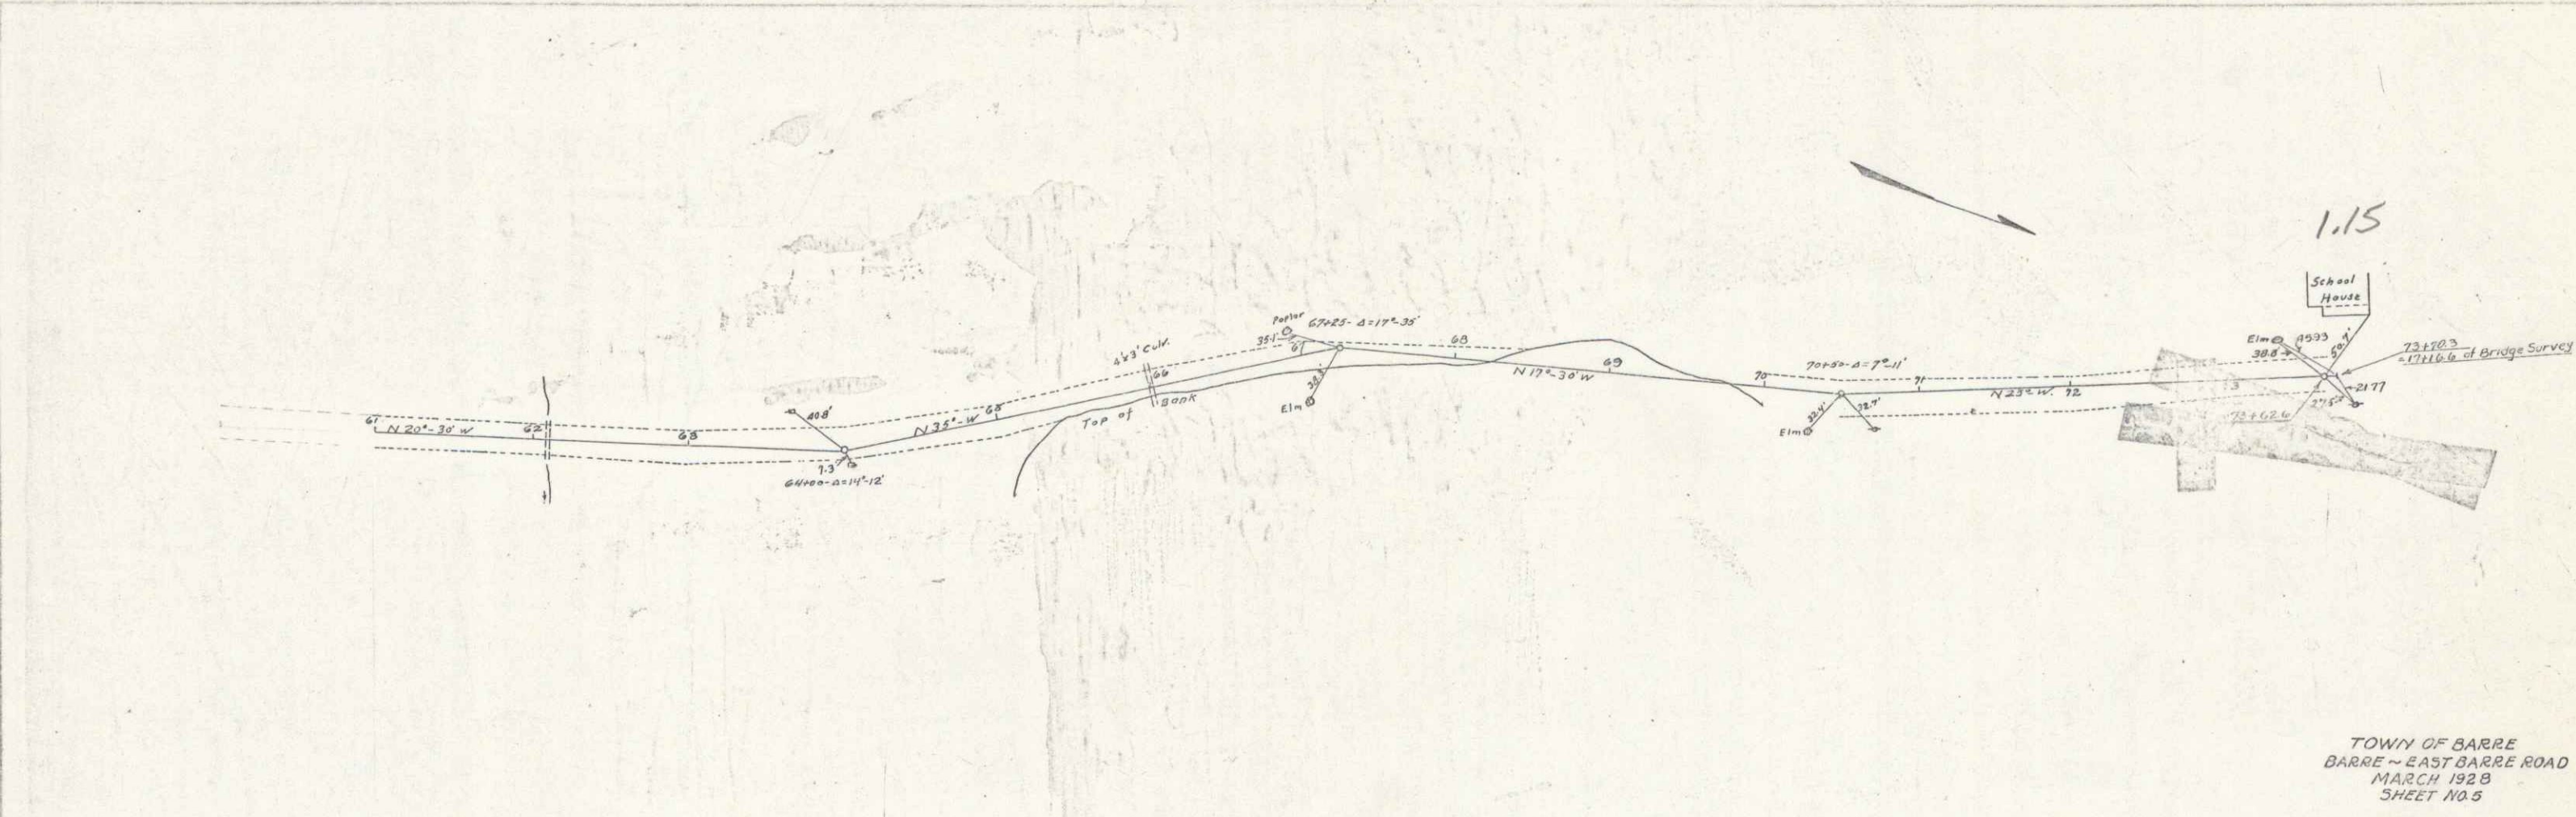

TOWN OF BARRE  
 BARRE - EAST BARRE ROAD  
 MARCH 1928  
 SHEET NO. 5

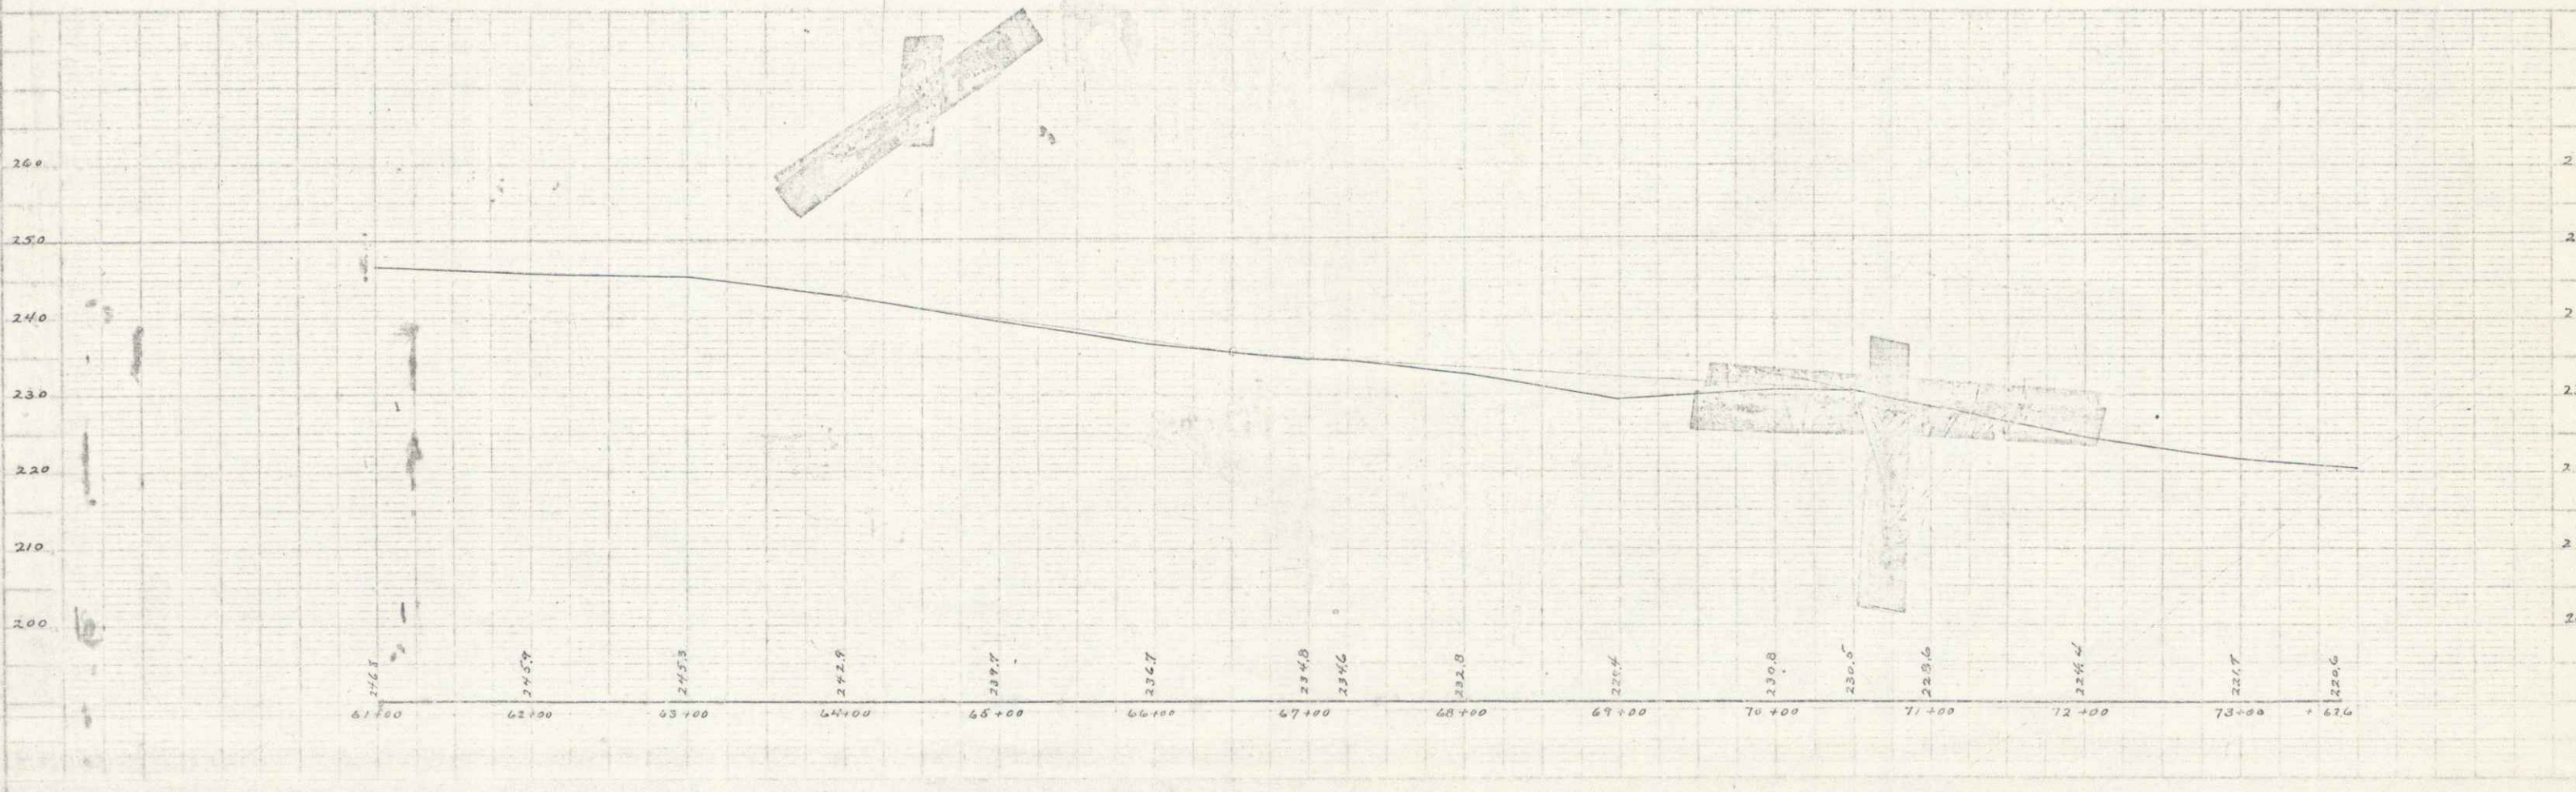

SHEET NO. 5  
 5