
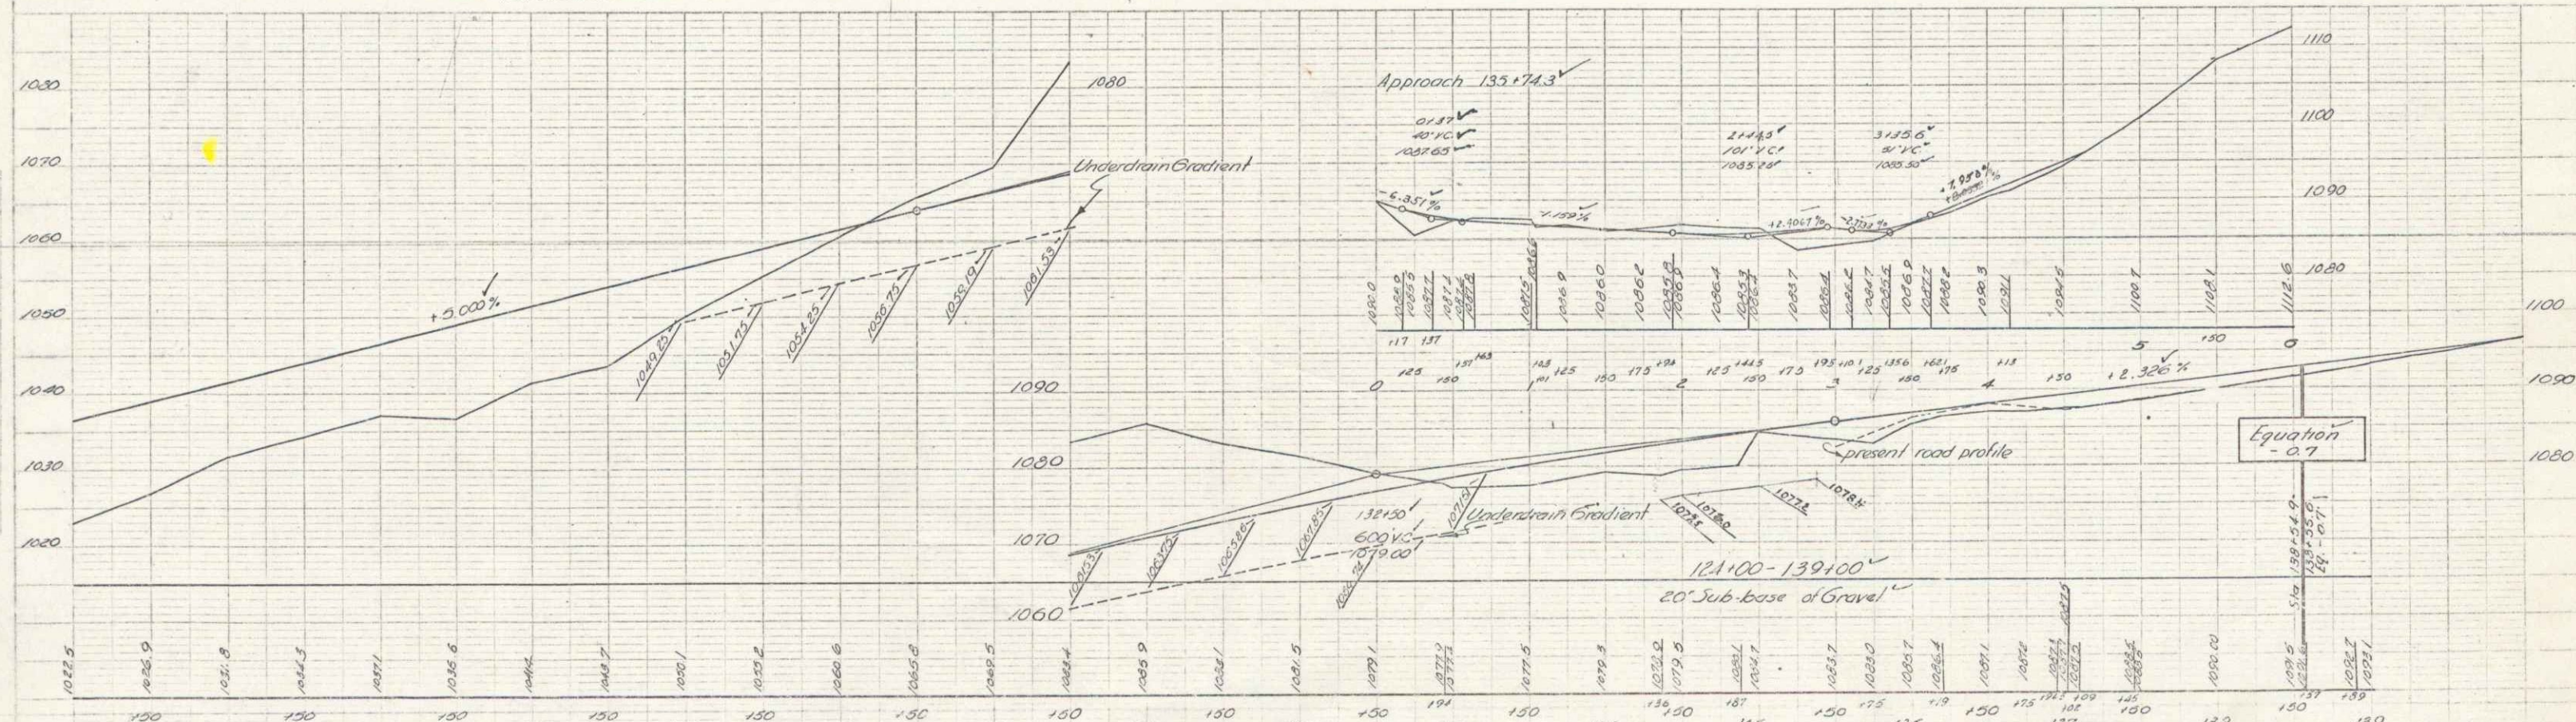


PLAN	1/2" = 10'
PROFILE	1" = 10'
SECTION	1" = 10'
DETAIL	1" = 10'
AS BUILT	1" = 10'

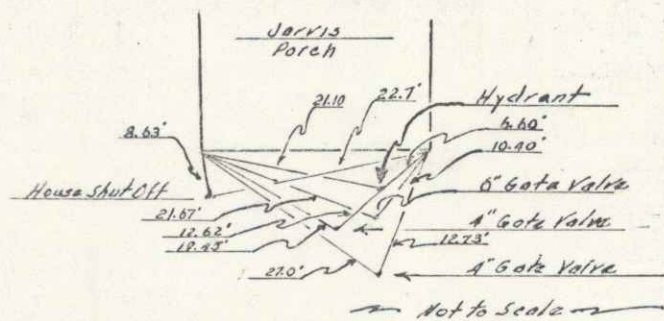

BM #15 S.I.R. 15" Iron at Sta. 127+15 Elev. 1044.29
 B.M. #15-A S.I.T. 12" Bal. 37' L.A. Sta. 127+05 Elev. 1032.36

BM #16 S.I.R. 30" Pine 12' L.A. Sta. 129+59 Elev. 1081.89
 B.M. #16-A S.I.R. 12" Cedar 75' Rk. Sta. 130+30 Elevation 1025.18

B.M. #17 Spike in Trunk 30' Elm 33' Rk. Sta. 137+15 Elev. 1057.24
 B.M. #17-A S.I.T. 15" Elm 50' Rk. 138+49 Elevation 1086.65

BARRIS
 Proj. 5-10-11(9)
 Sheet 12 of 87