
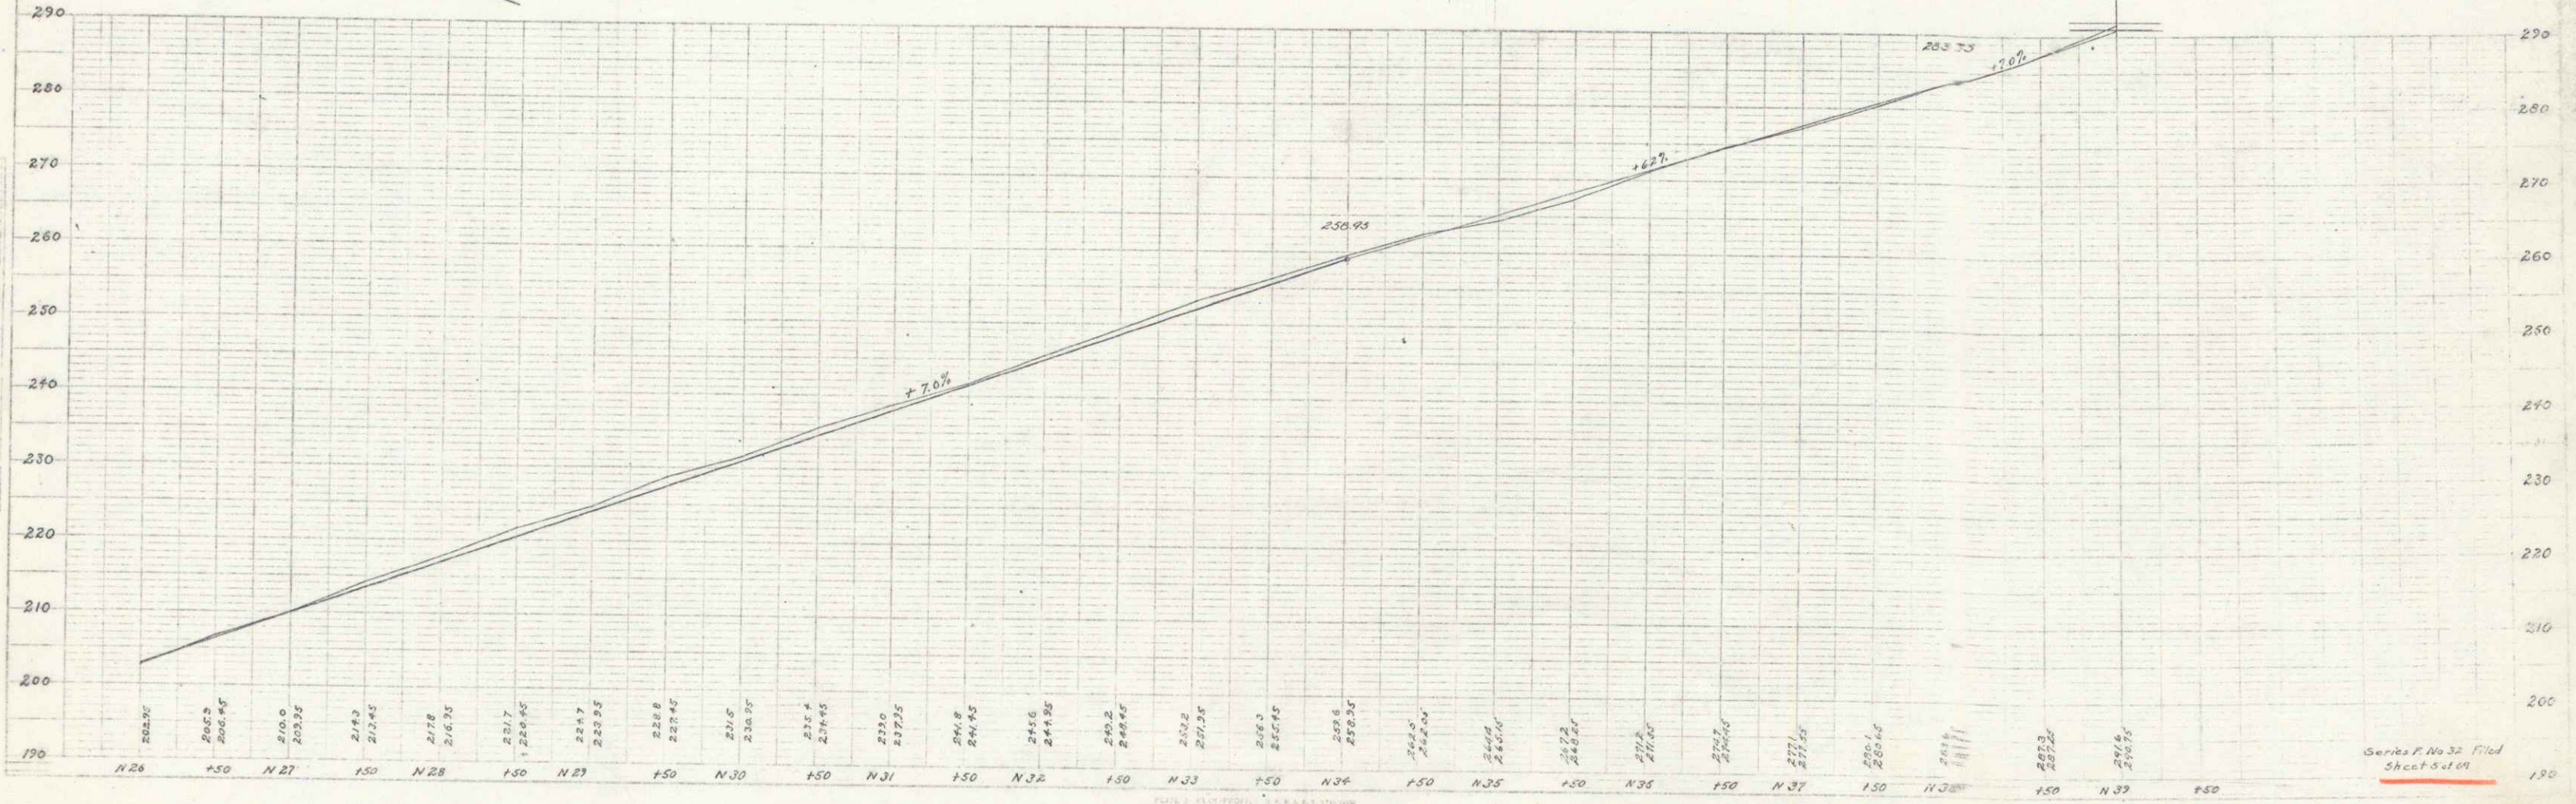


~~Notes to be deleted~~  
~~See note on C~~

**GUARD RAIL REQUIRED**  
 ON LEFT  
 Sta. 20+00 to Sta. 24+25 Length 25'  
 ON RIGHT  
 Sta. 29+03 to Sta. 29+33 Length 30'  
 Sta. 34+00 to Sta. 34+30 Length 30'  
**TOTAL THIS SHEET 48'**

FED. ROAD DIST. NO.	STATE	FED. AID PROJ. NO.	FISCAL YEAR	SHEET NO.	TOTAL SHEETS
100	VT	102	1957	2	4

G.E. NELSON

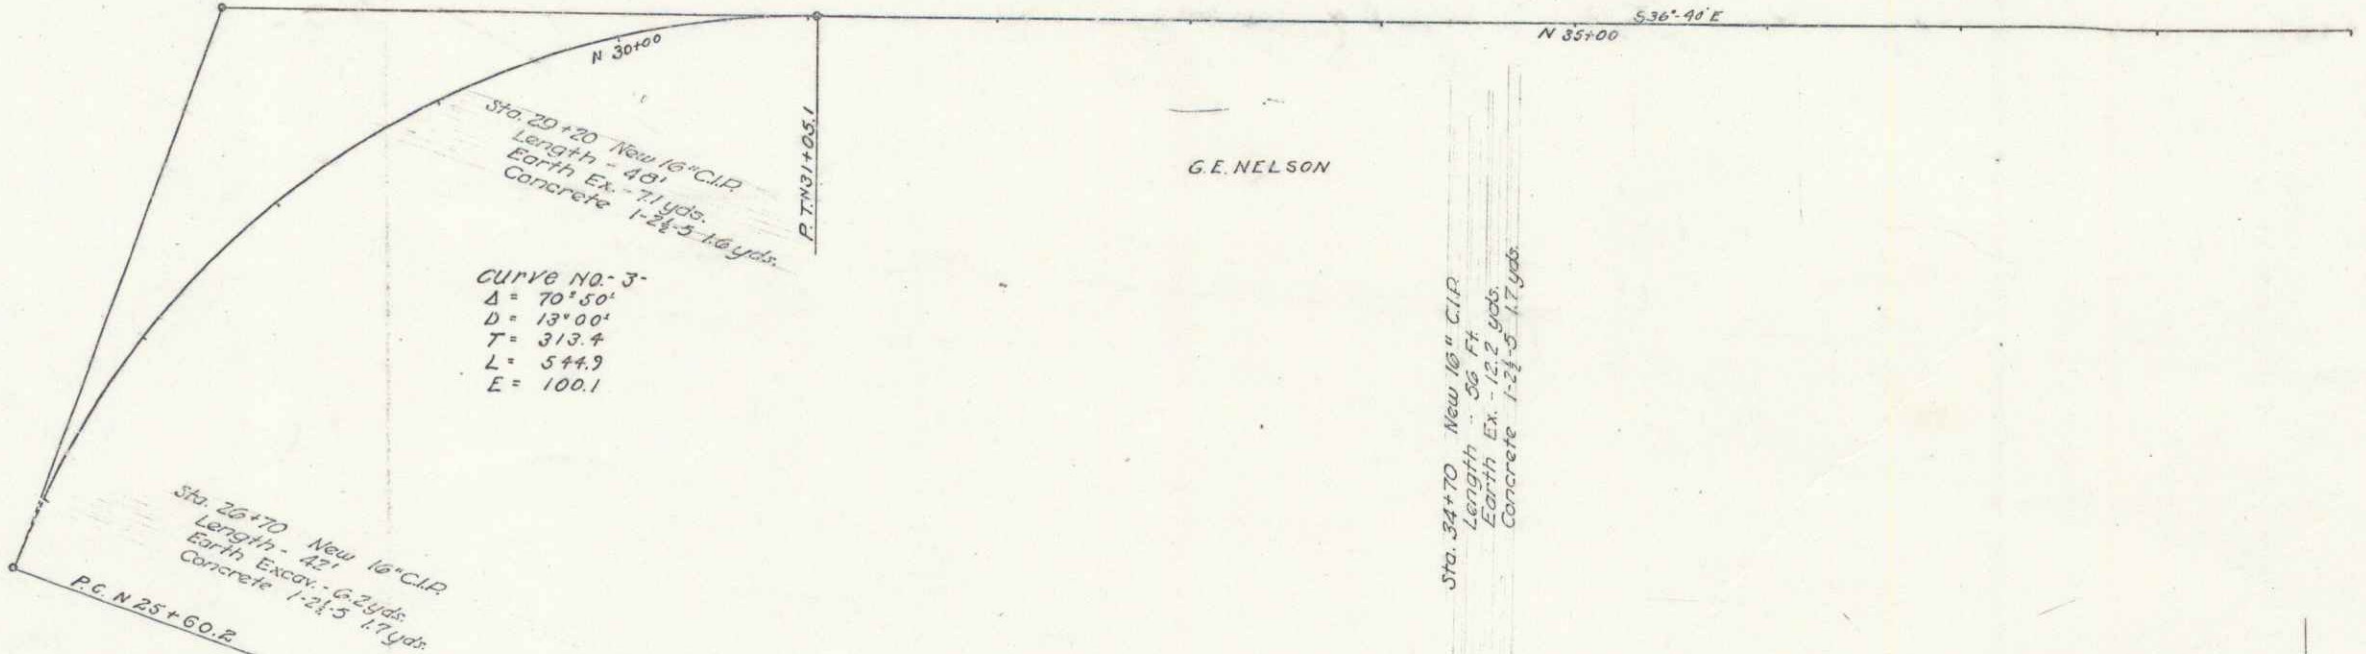

Series P No 32 Filed  
 Sheet 5 of 6

6