
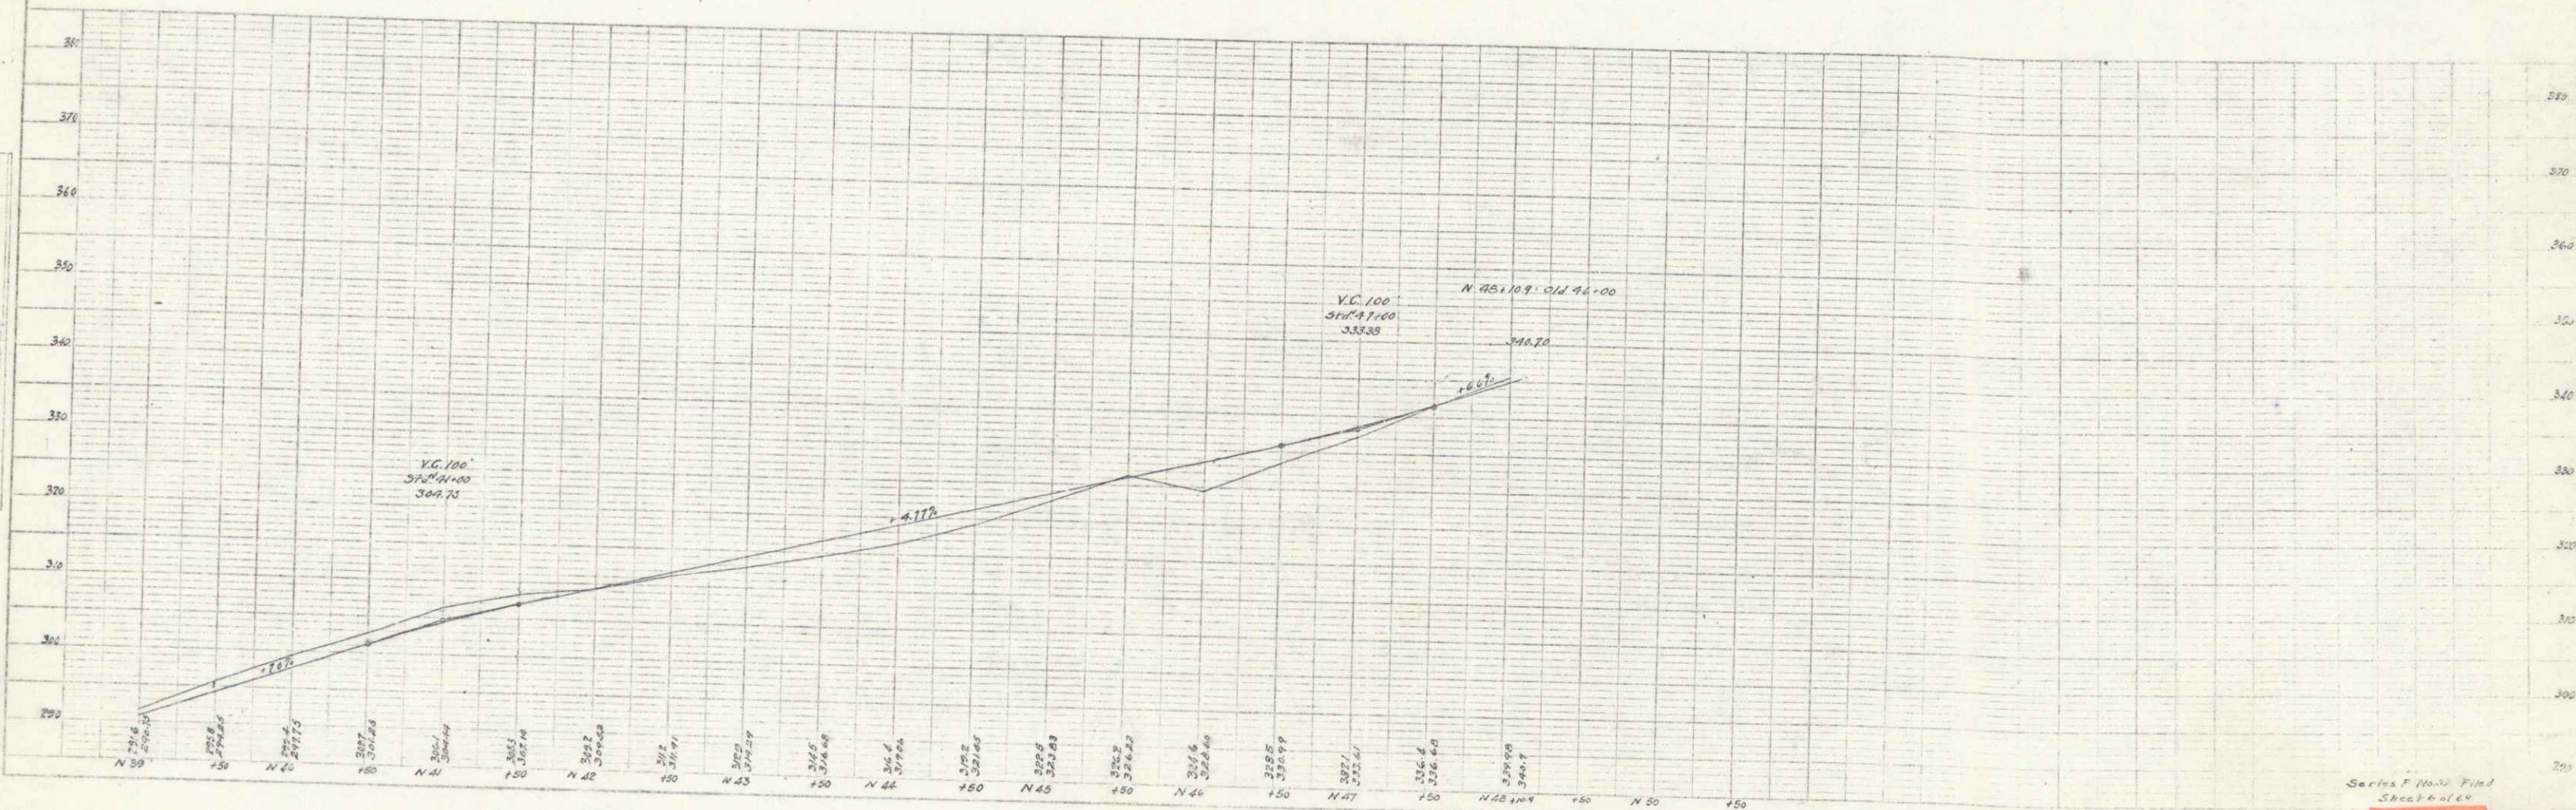


GUARD RAIL REQUIRED
 1. ON RIGHT 45'x45'
 STA 40+00 TO 40+30
 15'x15'x15'x15'
 15'x15'x15'x15'
 15'x15'x15'x15'
 15'x15'x15'x15'

Culverts
 Sta. 43+00 New 16" C.I.P. 30' long
 Earth Encov. 180'x45'
 Concrete 1-24-1 17'x45'

Curve No. 2
 I. 29°30'
 D. 415'
 T. 355'
 L. 638.1'
 E. 460'

FED. ROAD STAT.	FED. AID	FISCAL YEAR	SHEET NO.	TOTAL SHEETS
11	32	1927	6	62

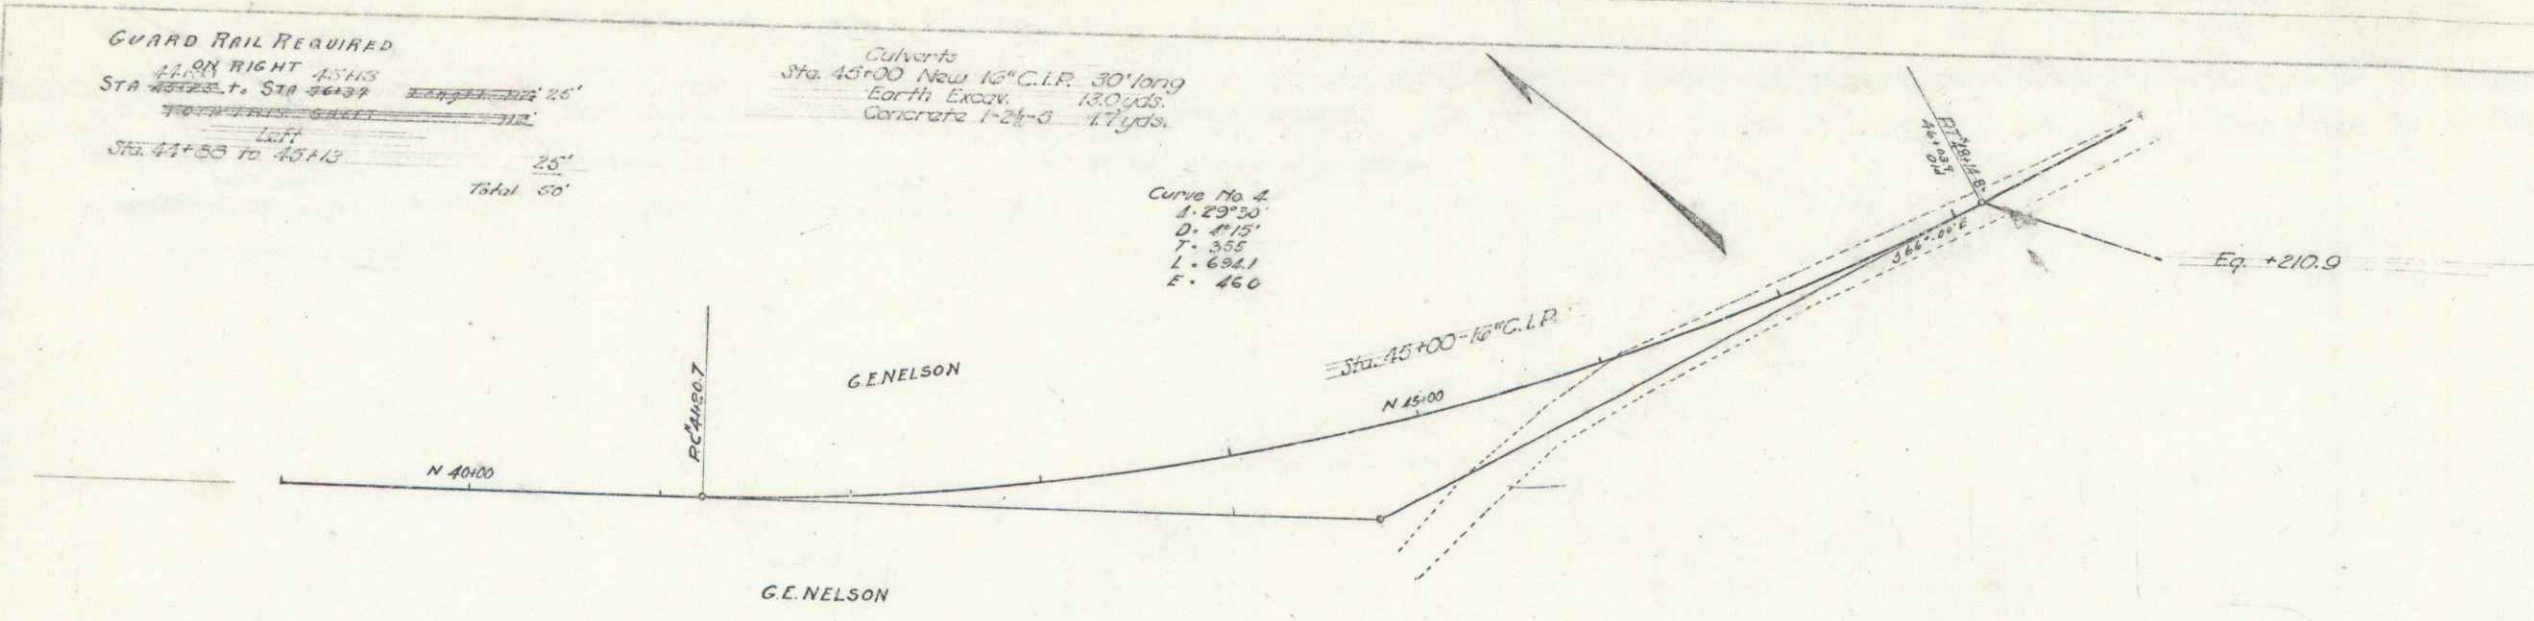

Series F No. 37
 Sheet 6 of 6