

GUARD RAIL REQUIRED ON LEFT

Sta	Length	Notes
133+00 to 134+25	225'	
137+38 to 137+55	17'	
145+25 to 145+56	31'	
147+15 to 147+35	20'	

ON RIGHT

Sta	Length	Notes
137+38 to 137+55	17'	
147+25 to 147+50	25'	

TOTAL THIS SHEET 338' 11" 2025'

C. NEW CULVERTS REQUIRED

Sta	Length	Notes
133+30	30 ft	12" Cor. I.P. 1-2-4 Concrete
147+32	30 ft	24" Concrete 1-2-5

WILLIAM CHAMBERLAIN



RELAYING PIPE CULVERTS

Sta	Length	Notes
137+50	30 ft	16" Cor. I.P. 1-2-5 Concrete

CULVERT REPAIRS REQUIRED

Sta	Length	Notes
137+50	6 ft	16" Cor. I.P. 1-2-5 Concrete

PROJECT NO.	STATE	YEAR	DATE	TOTAL SHEETS
5	VT	32	1921	12

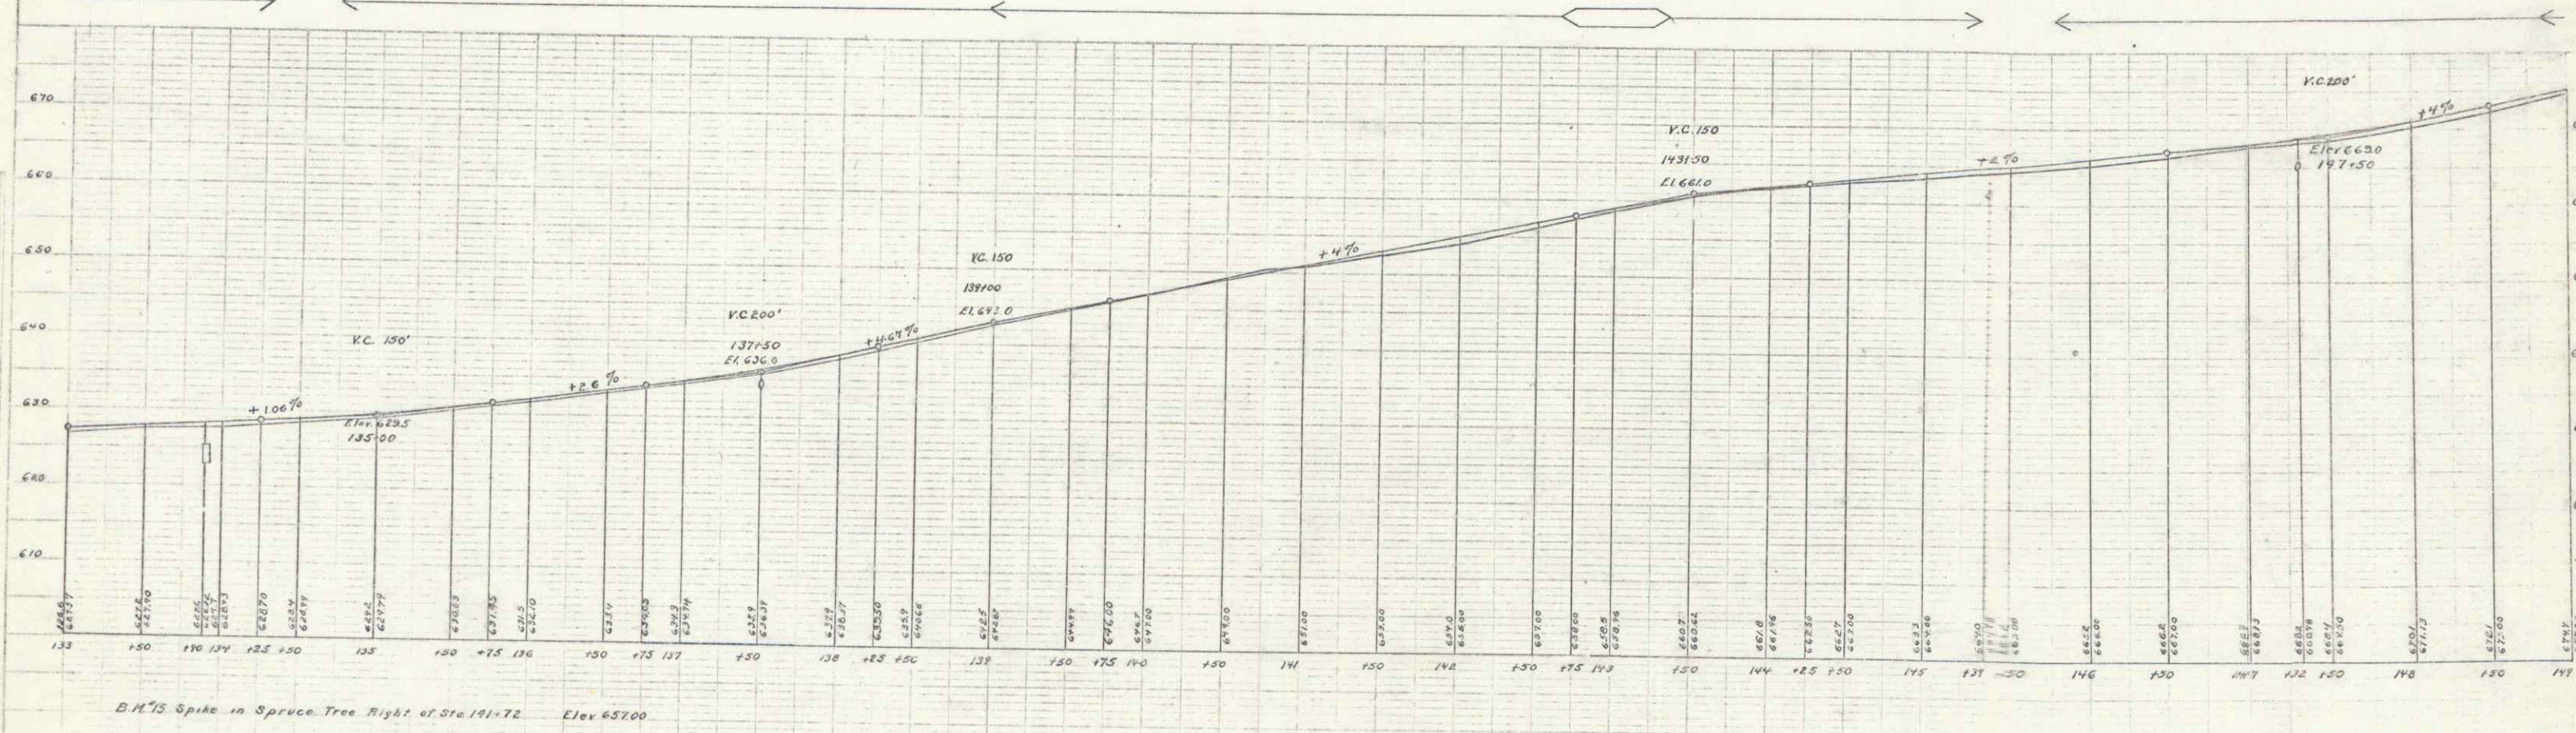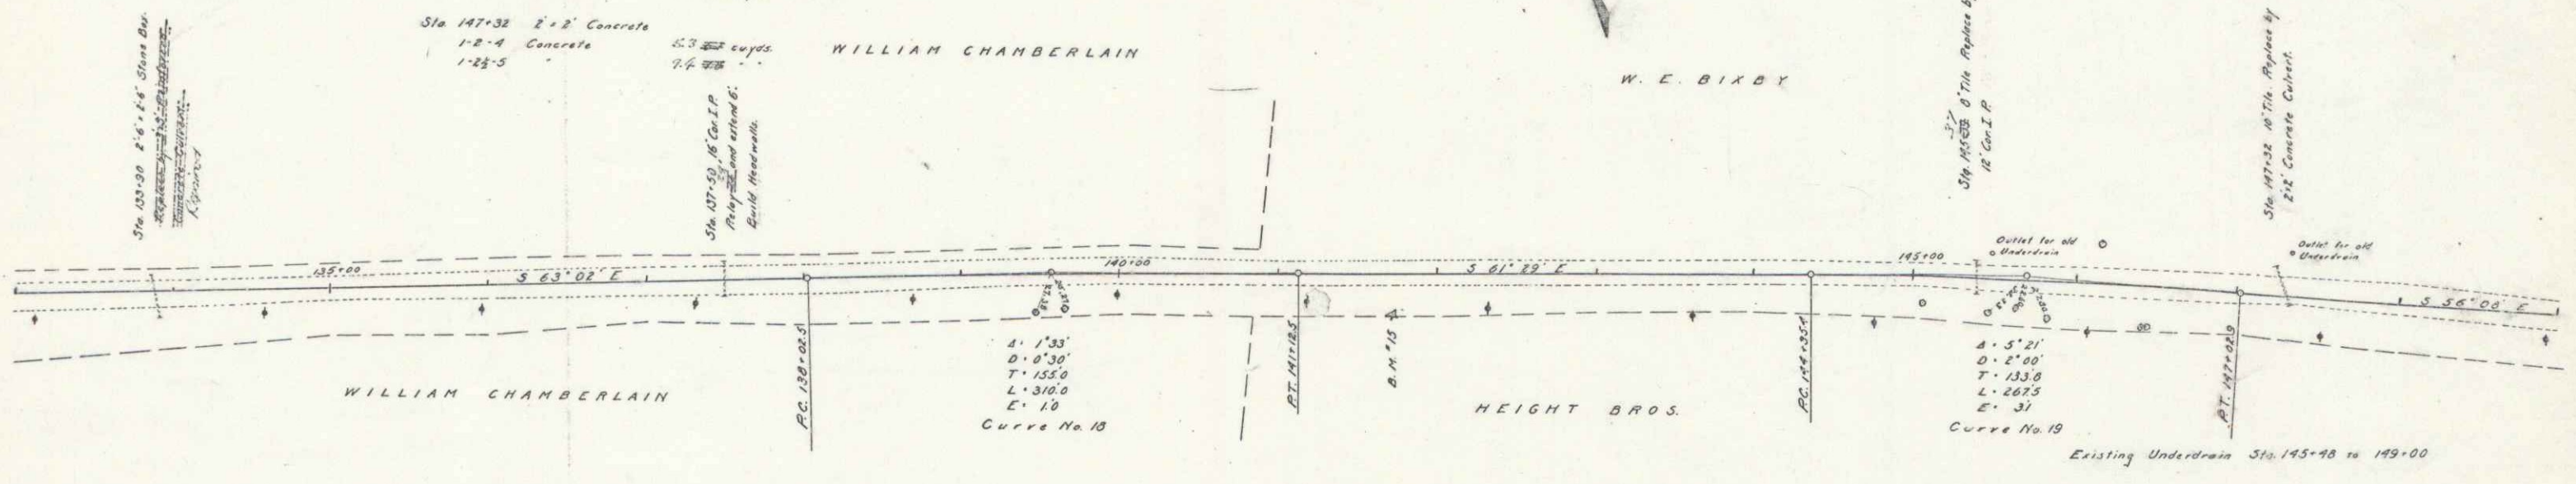

15