


PARCEL KIND OF DATE OF GRANTOR GRANTEE RECORDED PARCELS  
 INSTRUMENT NUMBER GROTON  
 A-B Q.C.D. 11-10-36 ISIAH B. FROST ST. OF VT. 19 464 11-12-36 390+50

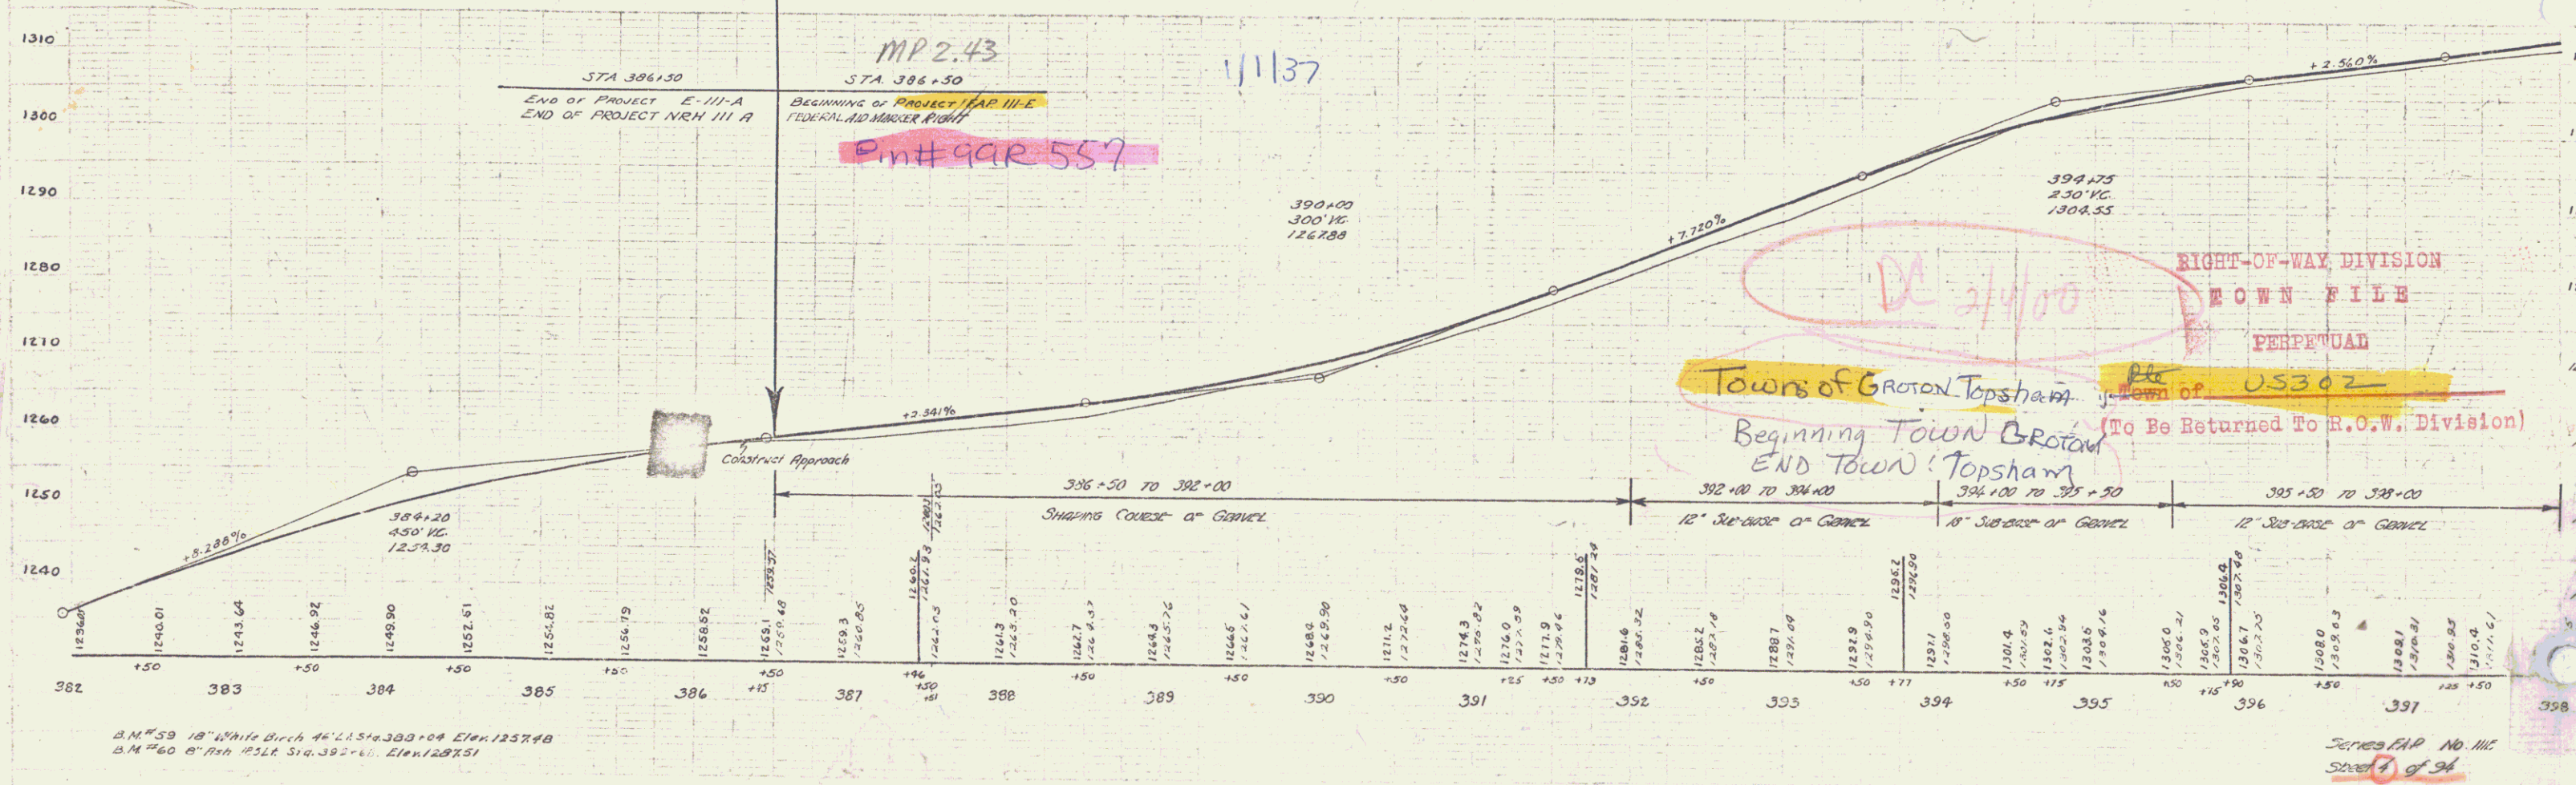

B.M. #59 18" White Birch 46' 2.5" x 300' 04" Elev. 1237.48  
 B.M. #60 8" Pine 15.5" Dia. 392+00 Elev. 1287.51

Series MAP No. 111  
 Sheet 7 of 94