


Parcel	Kind of Instrument	Date of Instrument	Grantor	Grantee	Recorded	Remarks
CUL. #1	Q.C.D.	11-10-36	ISAIAH FROST			
ABCDEF GH	W.D.	9-17-36	MERTON CARTER			
A'	Q.C.D.	9-21-37	GROTON MFG. CO.			

Grantee	Recorded	Remarks
GROTON		
ST. OF VT.	19 464	11-12-36 399+50
"	19 461	9-19-36 408+9
"	19 465	9-25-37

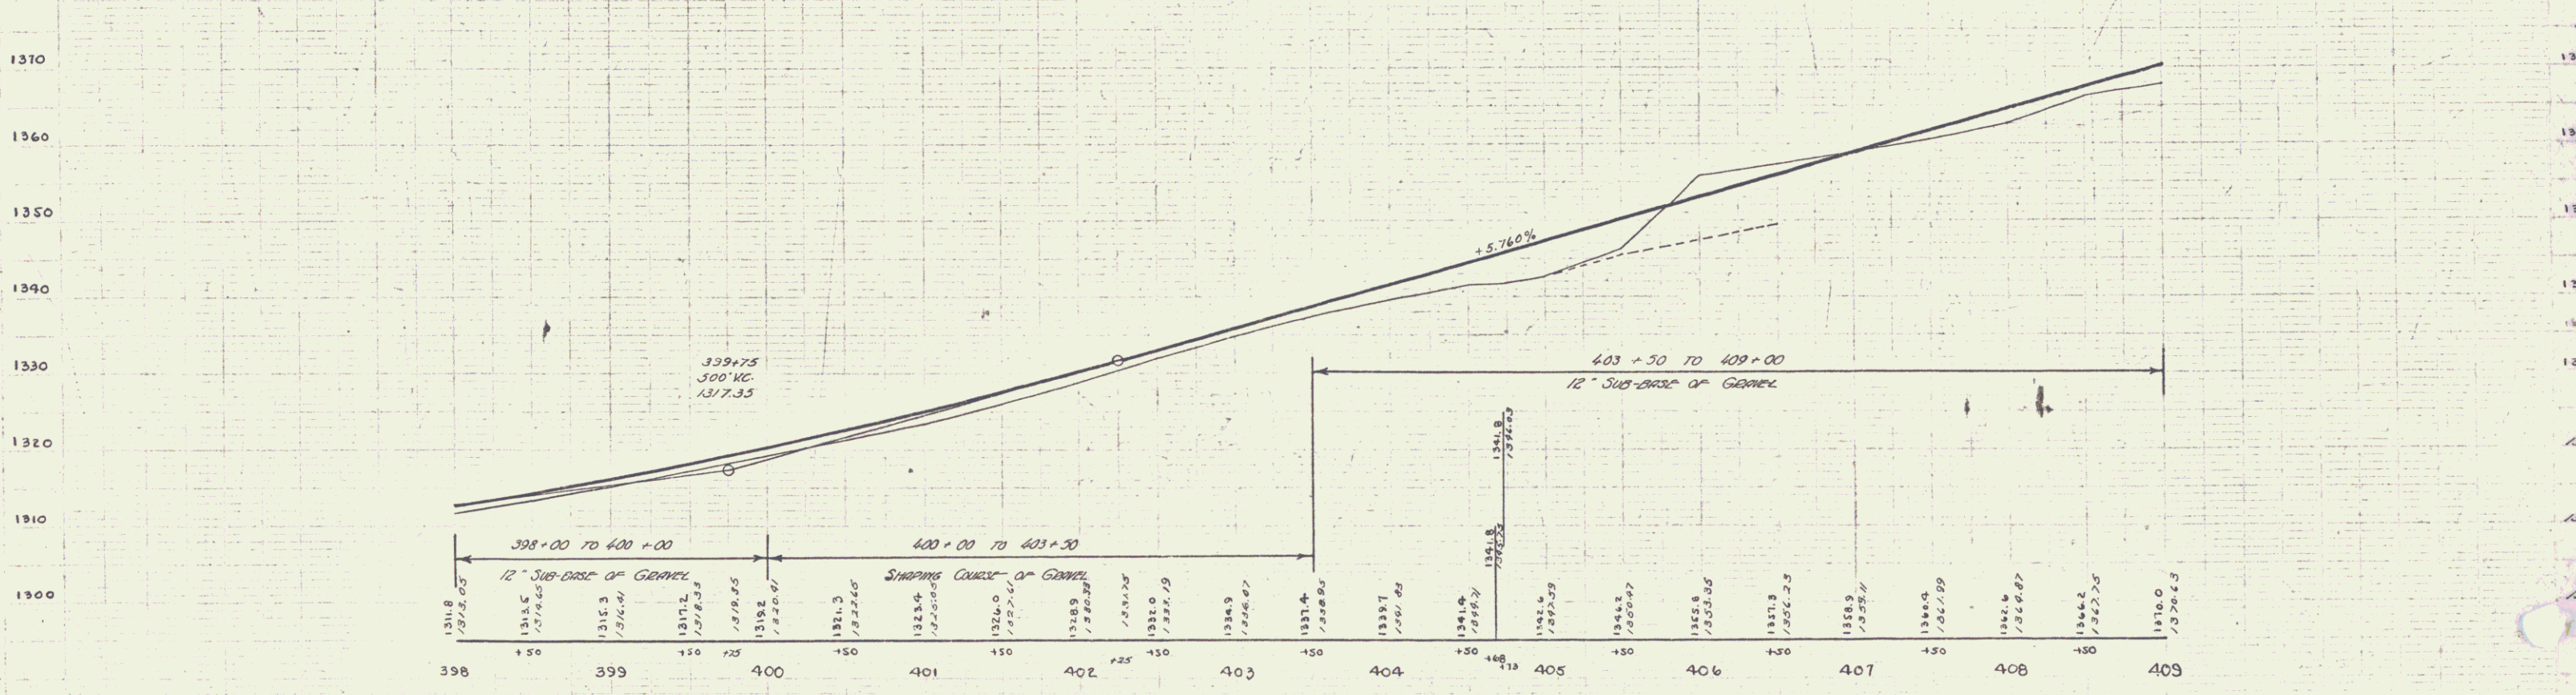

B.M. #61 15' Maple 19' RA Sta. 400+52. Elev. 1324.37

Series FAP No. 111-E
Sheet 5 of 54