


CURVE
 Δ 9°-15' R
 D 10'
 R 572.97
 T 210.9
 L 421.7
 E 3.9

PARCEL	KIND OF INSTRUMENT	DATE OF INSTRUMENT	GRANTOR	GRANTEE	RECORDED BOOK	RECORDED PAGE	RECORDED DATE	REMARKS
A B C D E F G H	W.D.	9-17-36	MERTON CARTER	STOFF	19	461	9-19-36	
A' B'	O.C.D.	9-30-36	CARRIE A. PAGE	H	19	462	10-2-36	

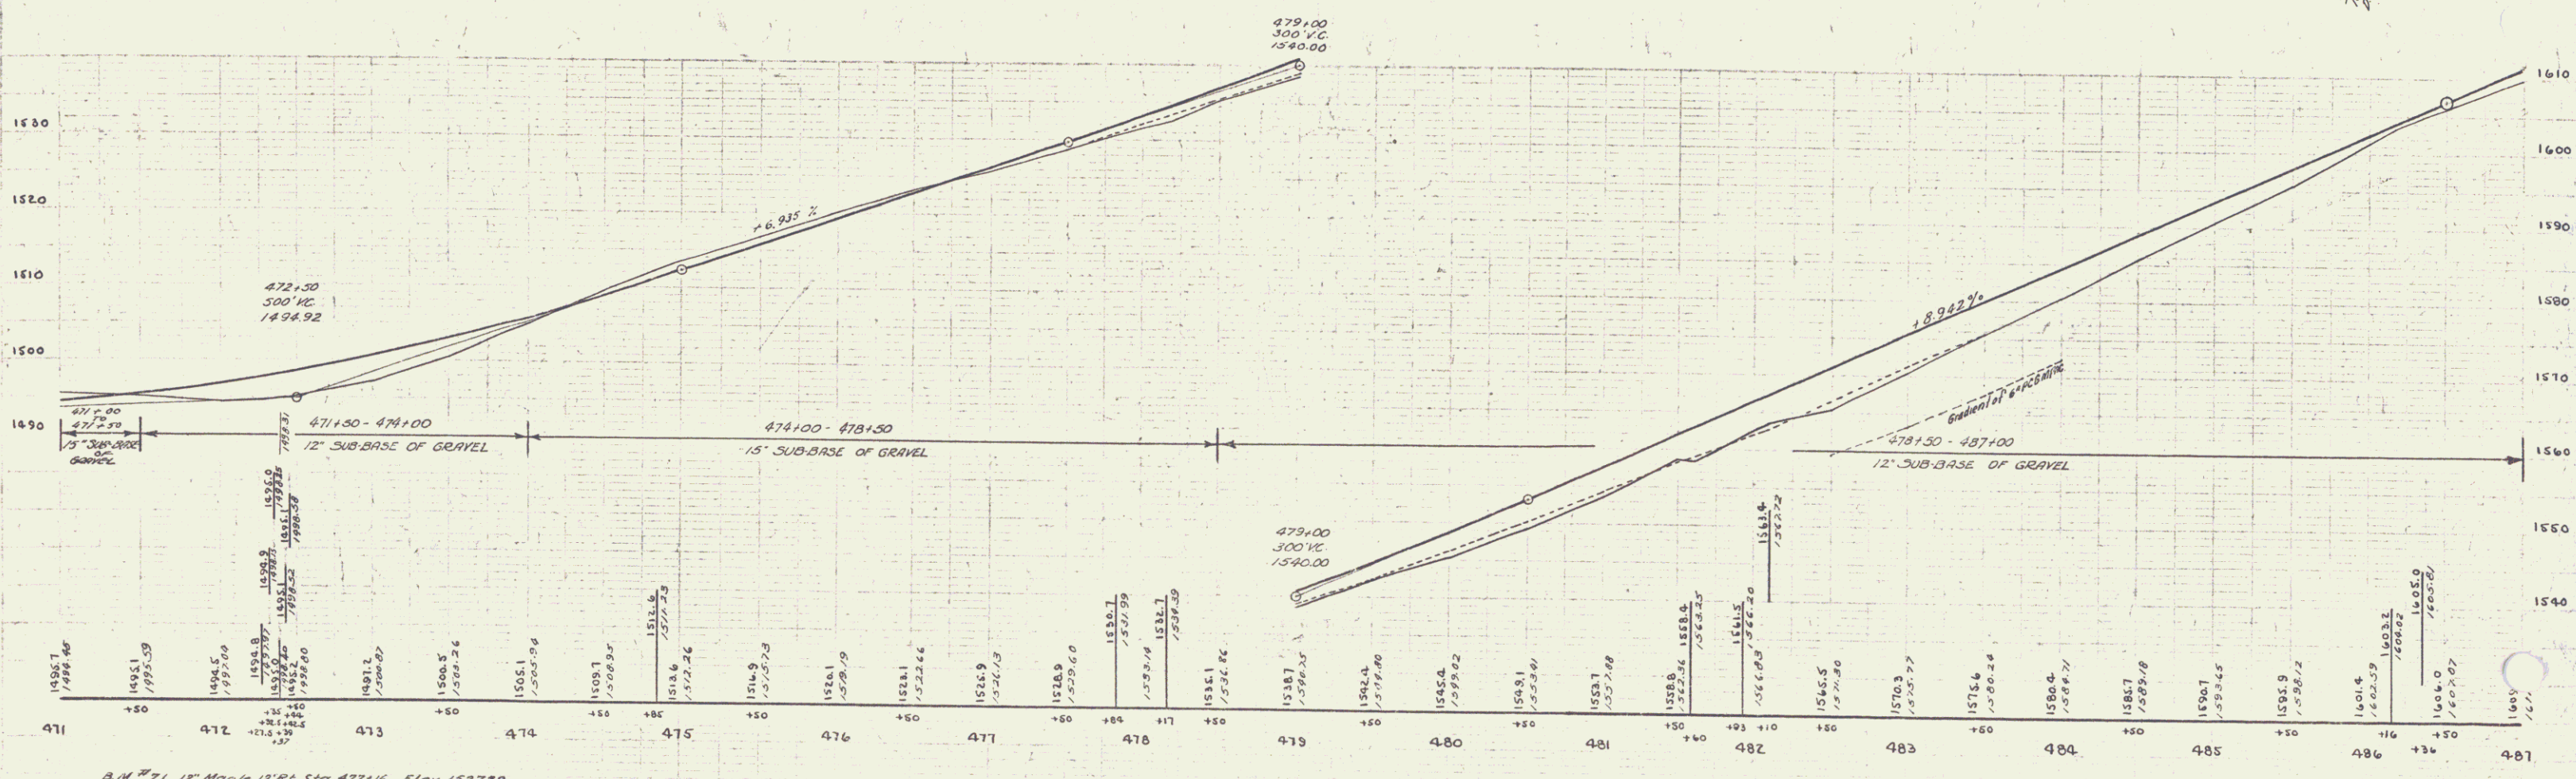

B.M. #71 12' Maple 15' RL 570 477+16 Elev. 1522.39
 B.M. #72 14' Maple 27' RL 576 484+07 Elev. 1522.75

SERIES MAP No. III-E
 Sheet 10 of 94