


Recorded Book Page
8/6/85 31 46

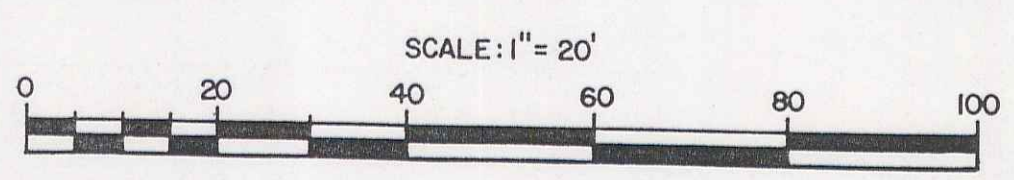

Pin 99R 558
 Project No. BMA 6662
 BMA BR#24 MP 0606
 STATE OF VERMONT
 AGENCY OF TRANSPORTATION
 TOWN OF ORANGE
Rte US 302
 APPROX. SCALE 1" = 20' DATE 4-16-85 DRAWN BY D.E.M.