


TRACED  
E. MACCHI 10/34



PARCEL	ADJACENT	DATE	OWNER	GRANTEE	RECORDED
A-B-C	Q.C.D.	2-1-35	FRED C. S. MAGOON	ST. OF VT.	488 2-14-35
A-B	Q.C.D.	2-1-35	H.C. HUTCHINS	"	488 2-14-35
A-B	Q.C.D.	1-30-35	R. C. ANN MESSIER	"	490 2-14-35

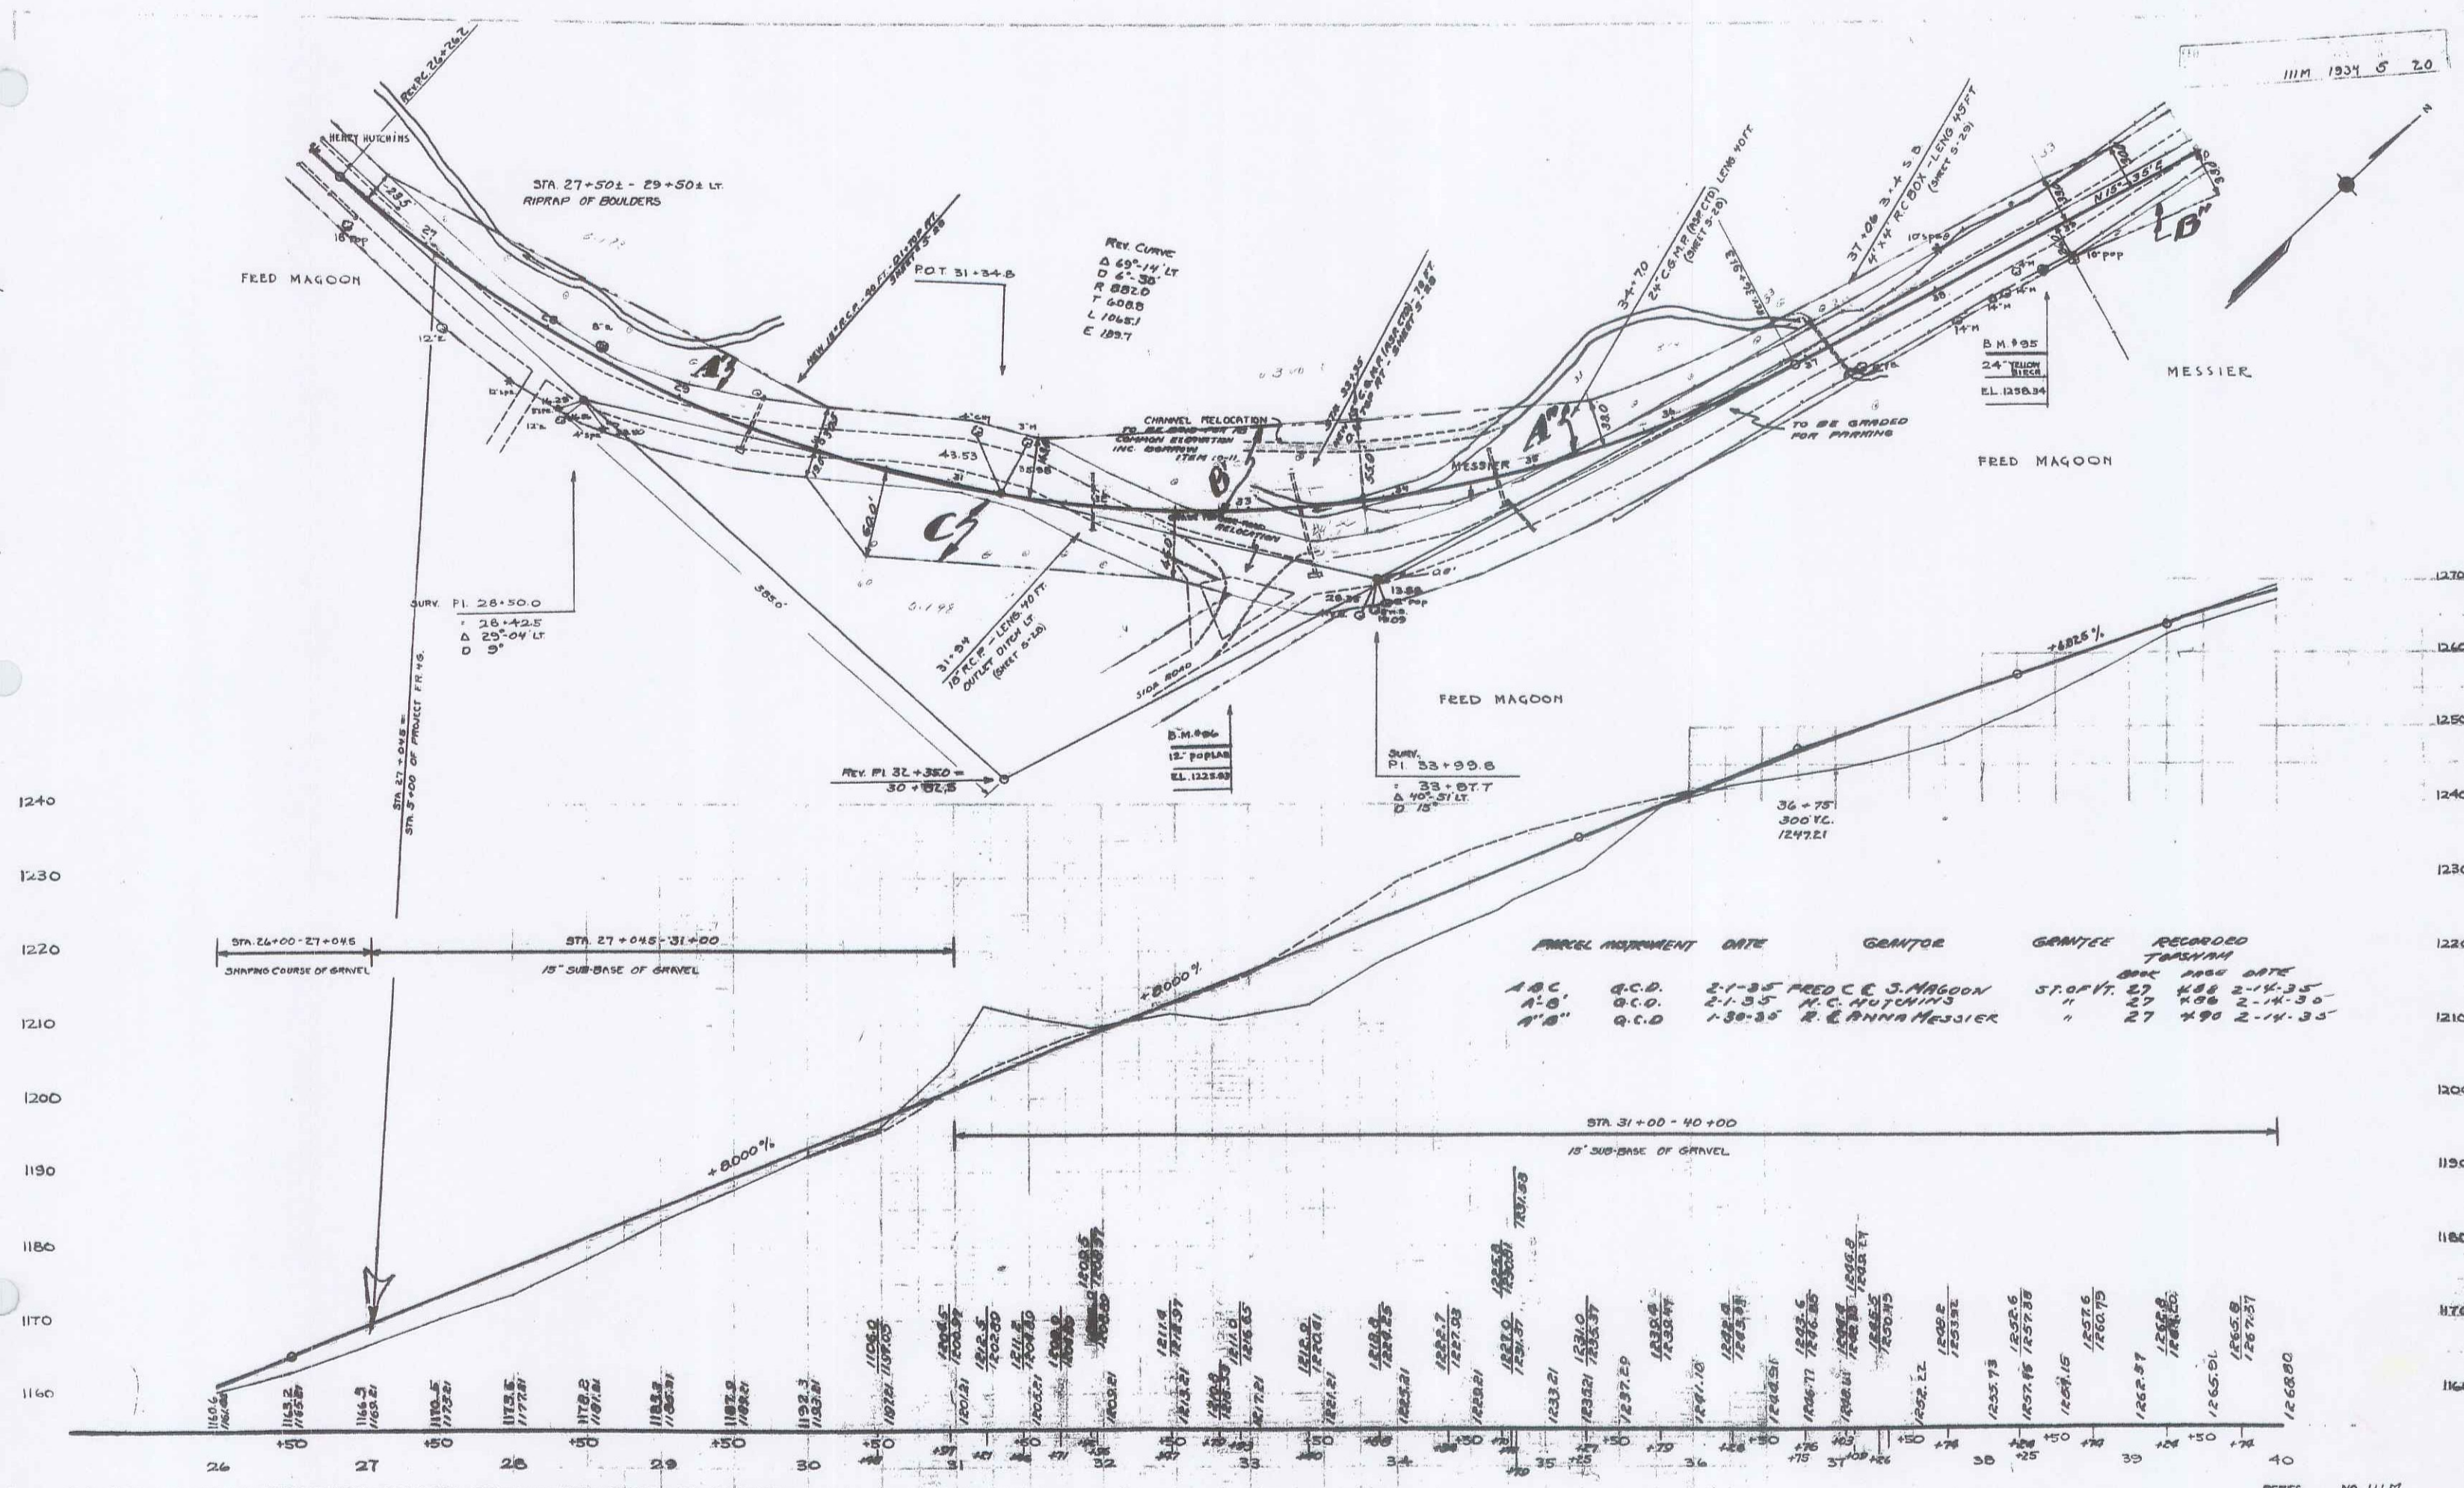