


TRACED D. MACCHI 10/34



1300
1290
1280
1270
1260

1300
1290
1280
1270
1260

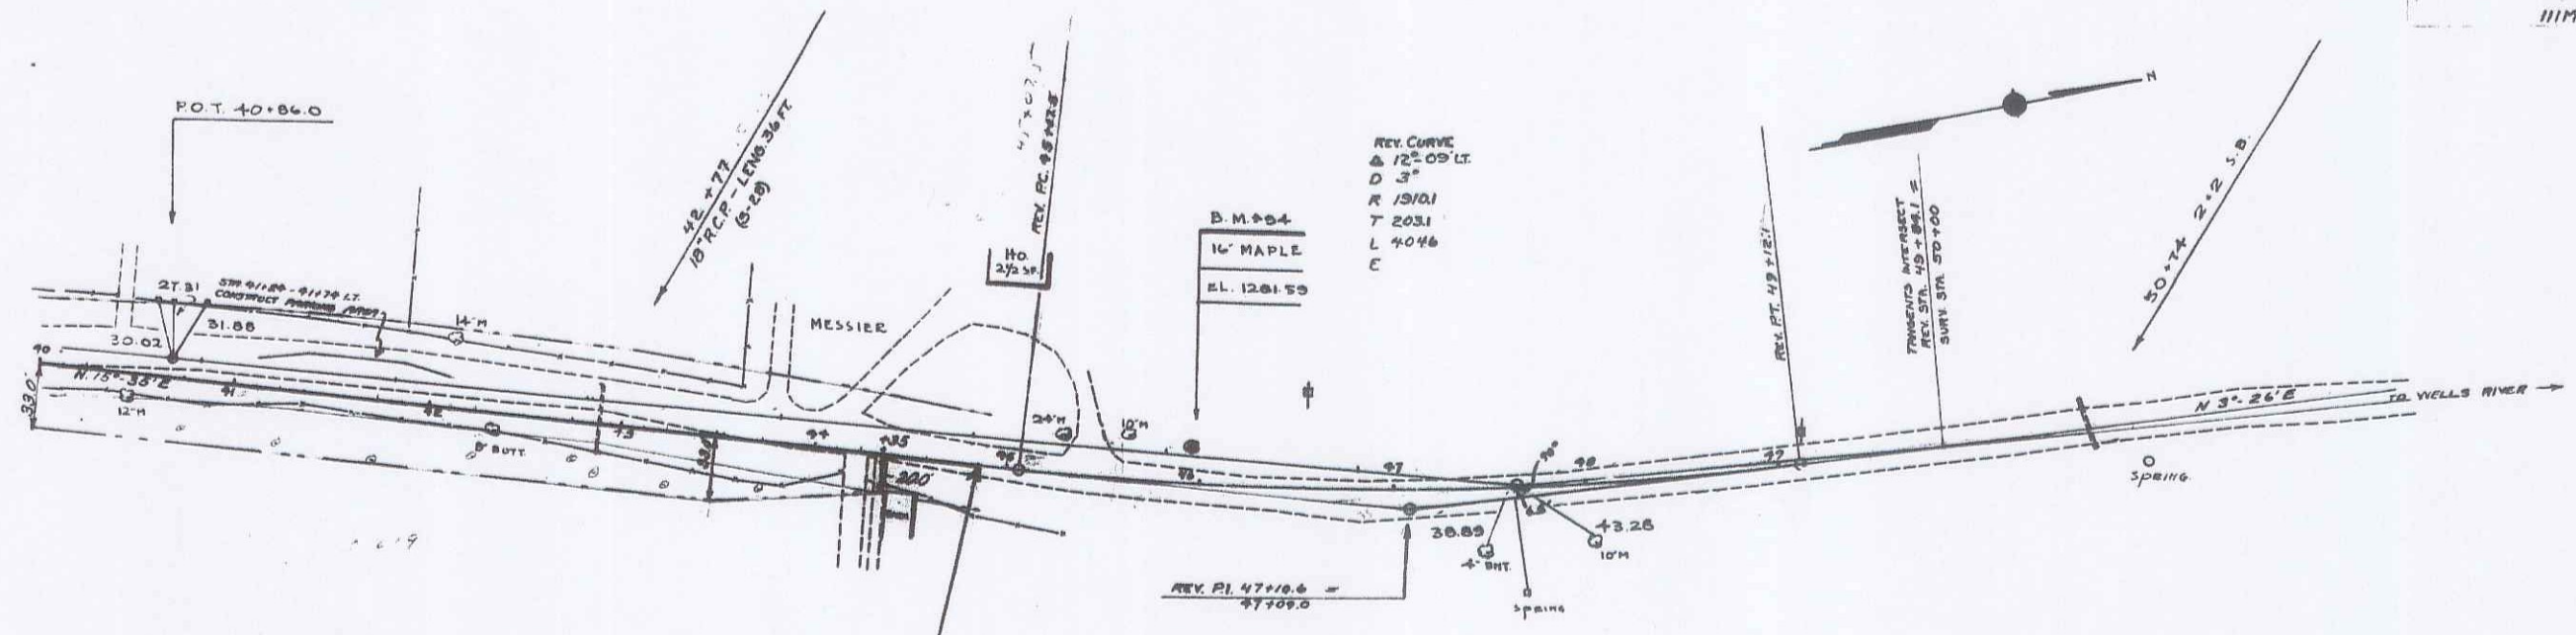

1260	1265	1270	1275	1280	1285	1290	1295	1300
40+00	40+10	40+20	40+30	40+40	40+50	40+60	40+70	40+80
1260.0	1261.0	1262.0	1263.0	1264.0	1265.0	1266.0	1267.0	1268.0
1269.0	1270.0	1271.0	1272.0	1273.0	1274.0	1275.0	1276.0	1277.0
1278.0	1279.0	1280.0	1281.0	1282.0	1283.0	1284.0	1285.0	1286.0
1287.0	1288.0	1289.0	1290.0	1291.0	1292.0	1293.0	1294.0	1295.0
1296.0	1297.0	1298.0	1299.0	1300.0				

Sheet 6 of 20

SERIES NO. 111M 4