


Curve # 3  
 26° 00' 00"  
 30  
 1910.1  
 441.0  
 866.7  
 50.2

PARCEL	KIND OF INSTRUMENT	DATE OF INSTRUMENT	GRANTOR	GRANTEE	RECORDED	REMARKS
A & B	Q.C.D.	11-12-32	MALCOLM GRAHAM	ST. OF VT.	12	PAVE DATE 6-19-11-22-32
C	W.D.	12-29-32	MARY DECK	ST. OF VT.	10	78 4-5-33 Sta 365+00
A' & B'	Q.C.D.	11-9-32	HIRAM DANIELS	ST. OF VT.	12	620 11-22-32

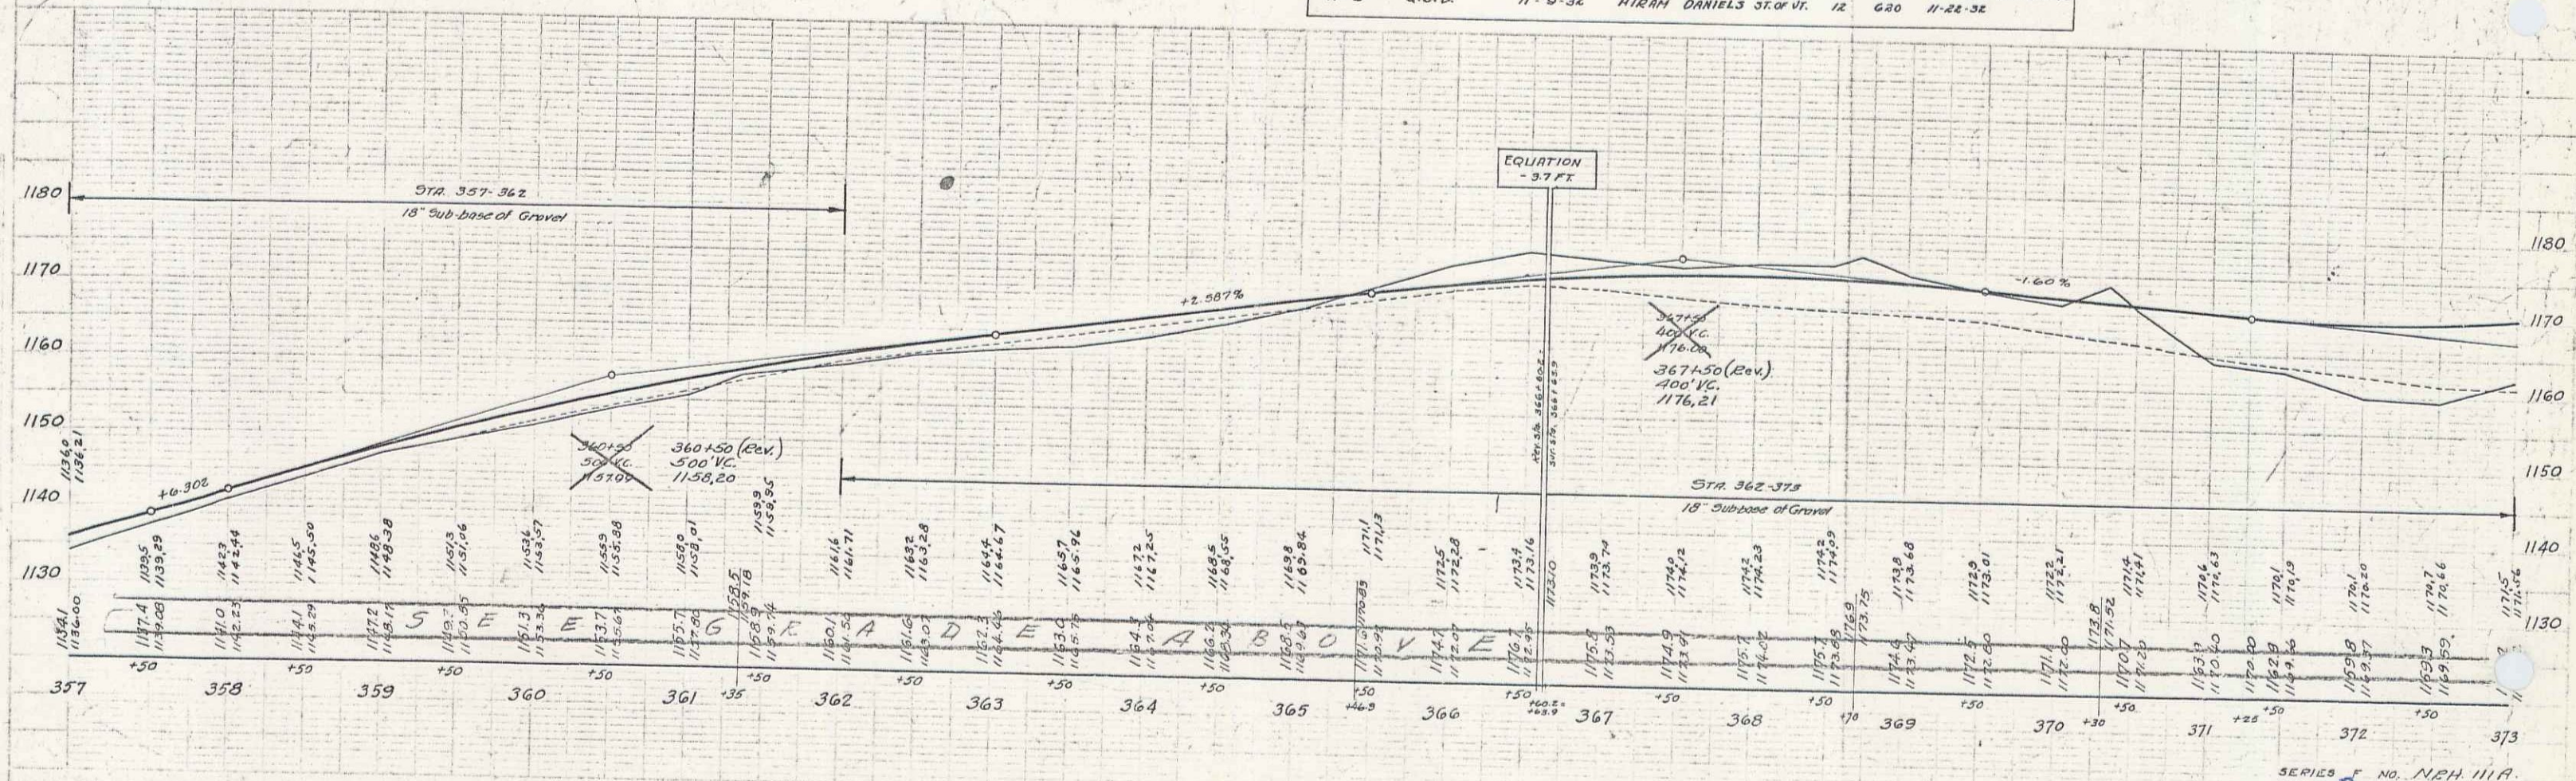

SERIES NO. N.H. 111A  
 SHEET 8 OF 35

5