


WOOD GUARD RAIL	CABLE GUARD RAIL	GUARD POSTS OF WOOD
STATION LEFT	STATION LEFT	STATION LEFT
375+25	375+25	375+25
41'	42'	41'
	228'	41'
	2	1
		1

PARCEL	KIND OF INSTRUMENT	DATE OF INSTRUMENT	GRANTOR	GRANTEE	RECORDED GROTON	REMARKS
CUL. A	Q.C.D.	11-29-32	I. B. FROST	ST. WY. 12	623	1-17-33 STA. 303+33
CUL. #3 A+B	"	11-9-32	HIRSH DANIELS	ST. OF WY. 12	620	11-22-32 STA. 377+12
A"	"	12-7-32	GROTON MFG. CO. INC.	ST. OF WY. 12	622	1-17-33 378+17

CURVE #1 & A
 A 23° 00' LT.
 D 3°
 R 1146.3
 T 236.1
 L 261.7
 E 23.7

NOTE: GRADE REVISION - JAN. 17, 1933.
 STA. 369+0 TO STA. 387+0

ORIGINAL GRADE	REVISION GRADE
-1.60% TO PI. 379+25	500' VC
ELEV. 1166.00	ELEV. 1166.00
+3.00% TO PI. 385+0	400' VC
ELEV. 1256.00	ELEV. 1256.00
+2.375% TO PI. 390+0	300' VC
ELEV. 1267.88	ELEV. 1267.88

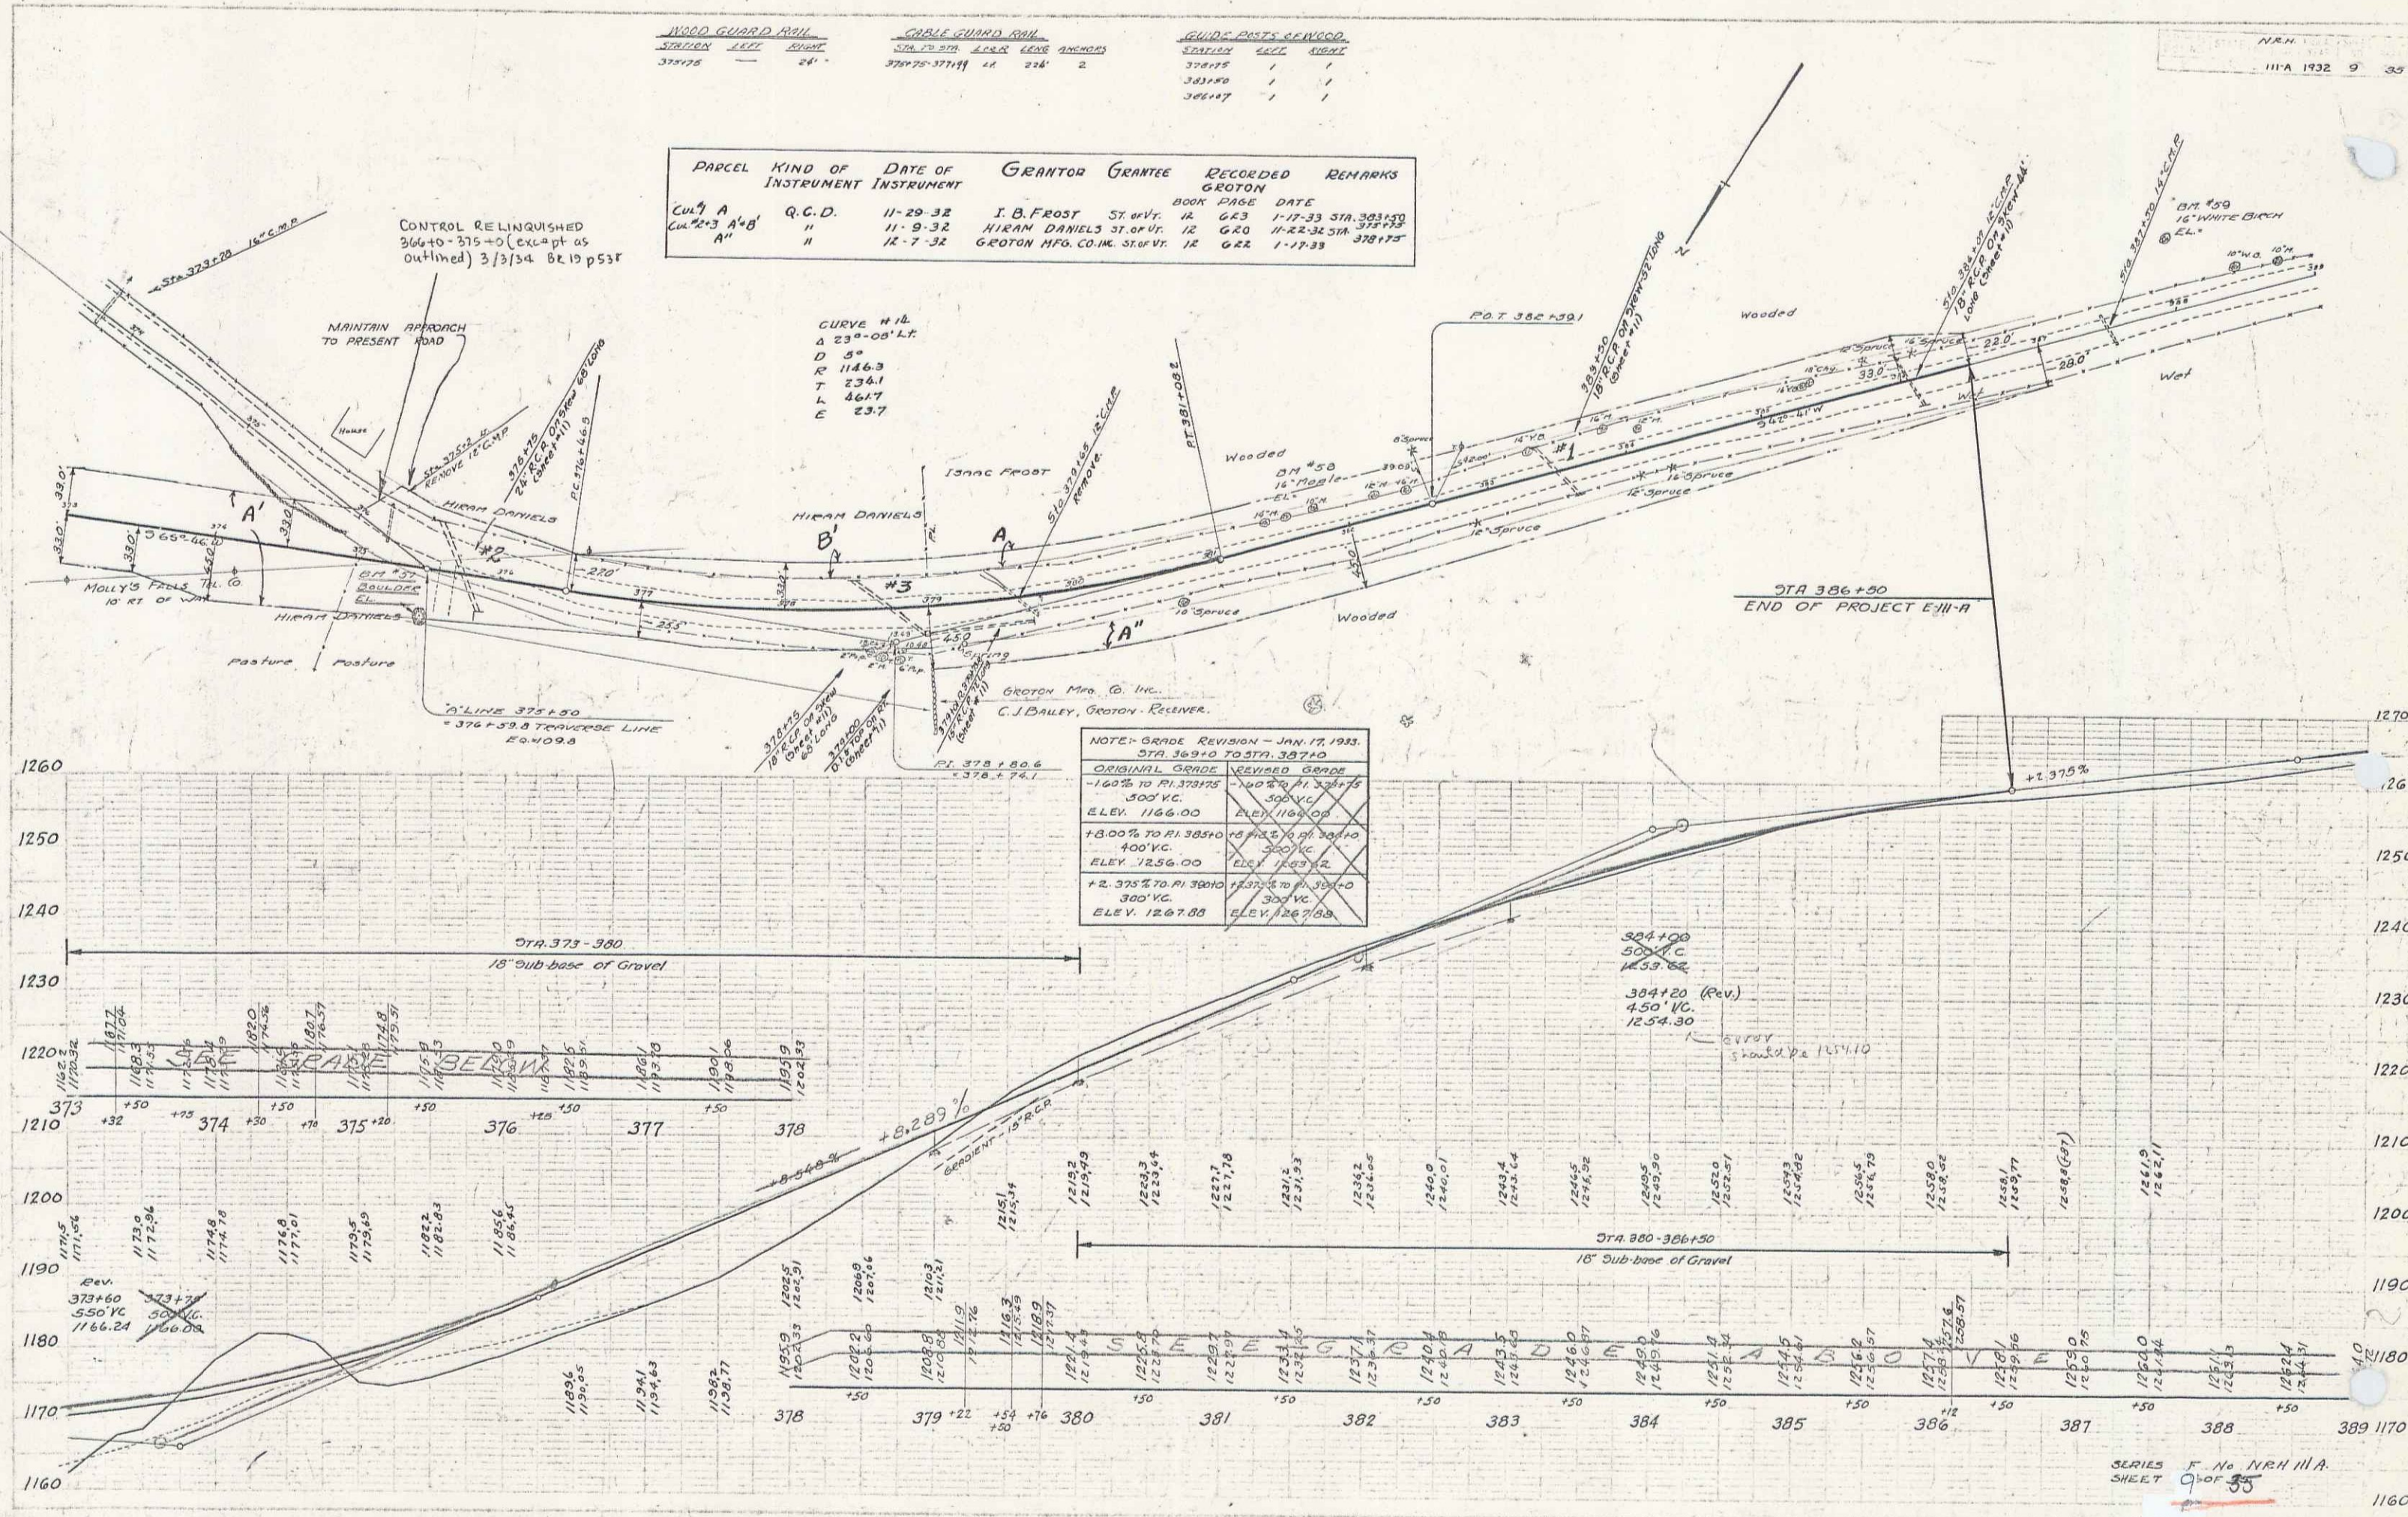

SERIES F No. 1174 IIIA
 SHEET 35
 1160