
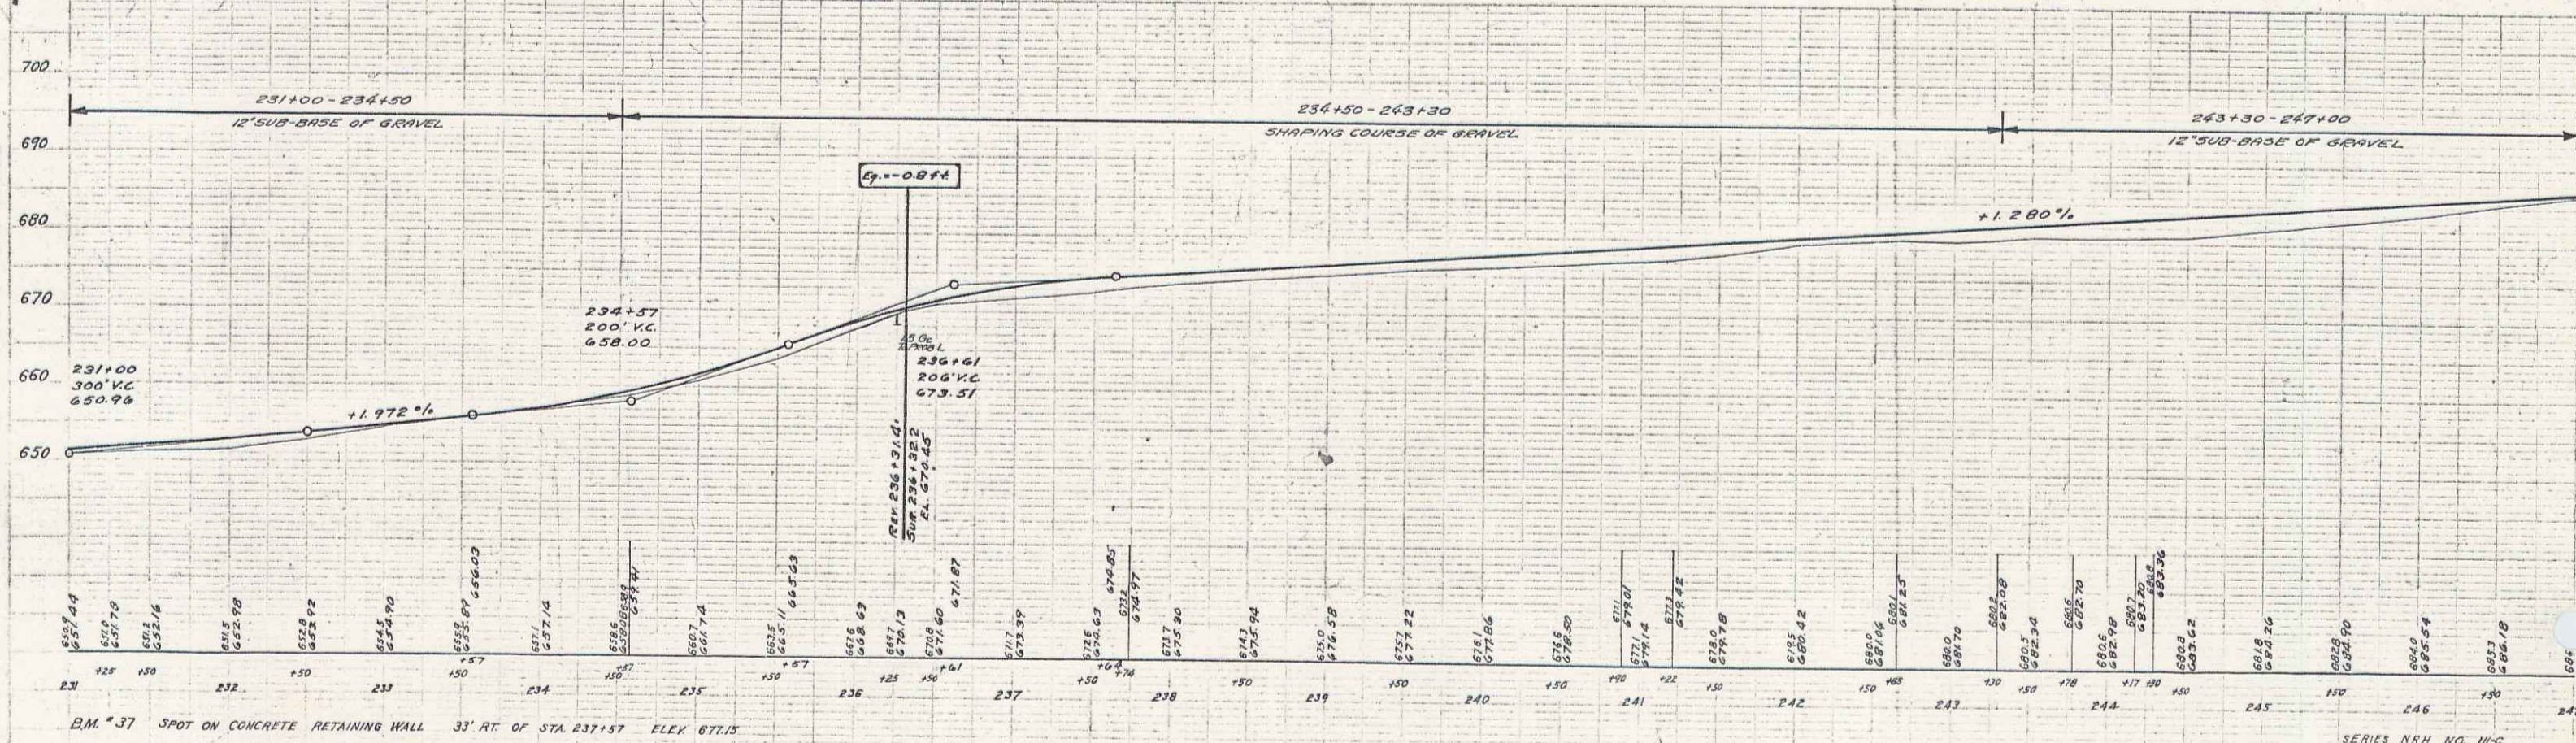


Parcel	Kind of Instrument	Date of Instrument	Grantor	Grantee	Recorded Groton	Remarks
A	O.C.D.	1-30-34	Fred Frost & Wife	Shel. M.	13 677	2-7-34
Ctrl. #1	"	1-31-34	Lee S. Blanchard	"	13 677	2-7-34

NEW HAMPSHIRE STATE
 DIST. NO. 111-C
 FISCAL YEAR 1933
 SHEET NO. 54

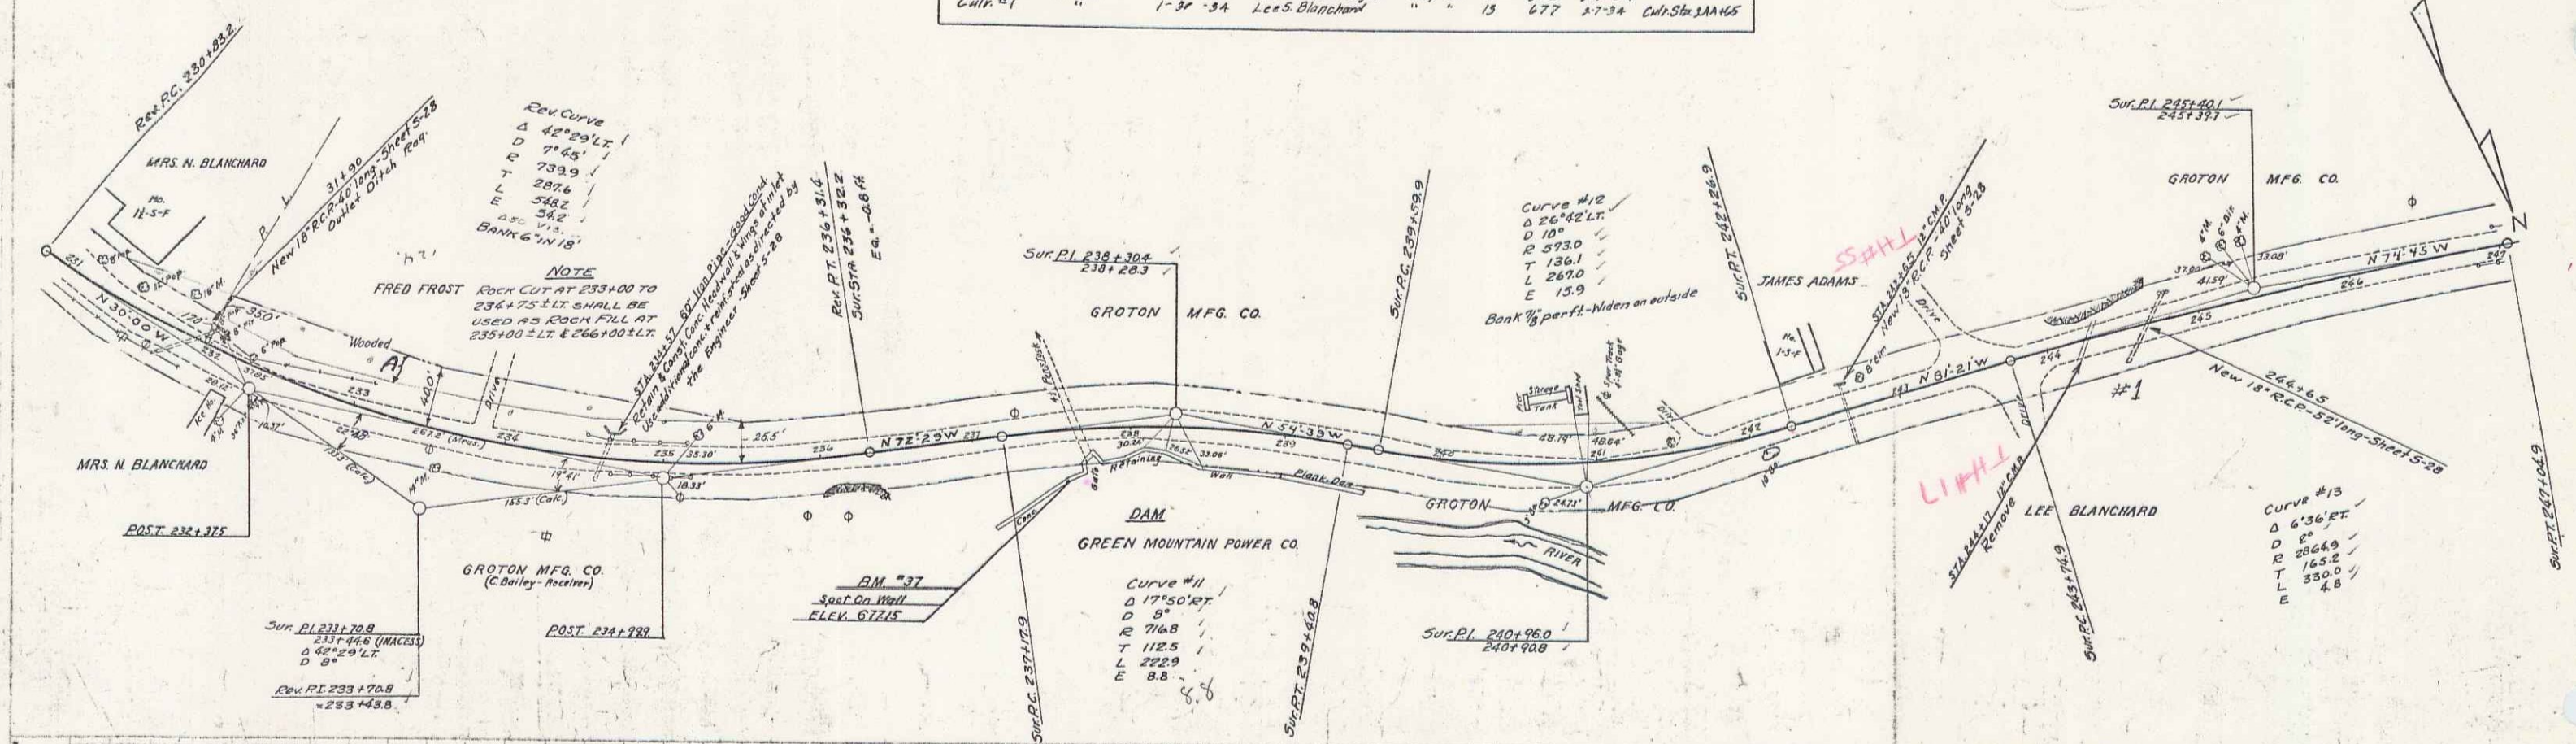

FRANZ
 MADOLSKI
 BURELOW

FRANZ
 MADOLSKI
 BURELOW

SERIES NRH NO. 111-C
 SHEET 2 OF 54

6