



OFFSETS FROM SERV. LINE 27-276			
STATION	OFFSET	STATION	OFFSET
270+50	4' LT.	274+00	2' 0" LT.
271+00	4' "	274+00	1' 5" "
271+50	3' 5" "	274+00	1' 0" "
271+75	3' 5" "	275+30	1' 0" "
272+00	3' 0" "	275+00	0' 5" "
272+50	3' 0" "	275+00	0' 1" "
273+00	3' 0" "	276+00	0
273+15	3' 0" "		
273+50	2' 5" "		

**NOTE**  
CHANNEL EXCAVATION IS TO BE USED IN THE CONSTRUCTION OF EMBANKMENT AND IS NOT TO BE WASTED.

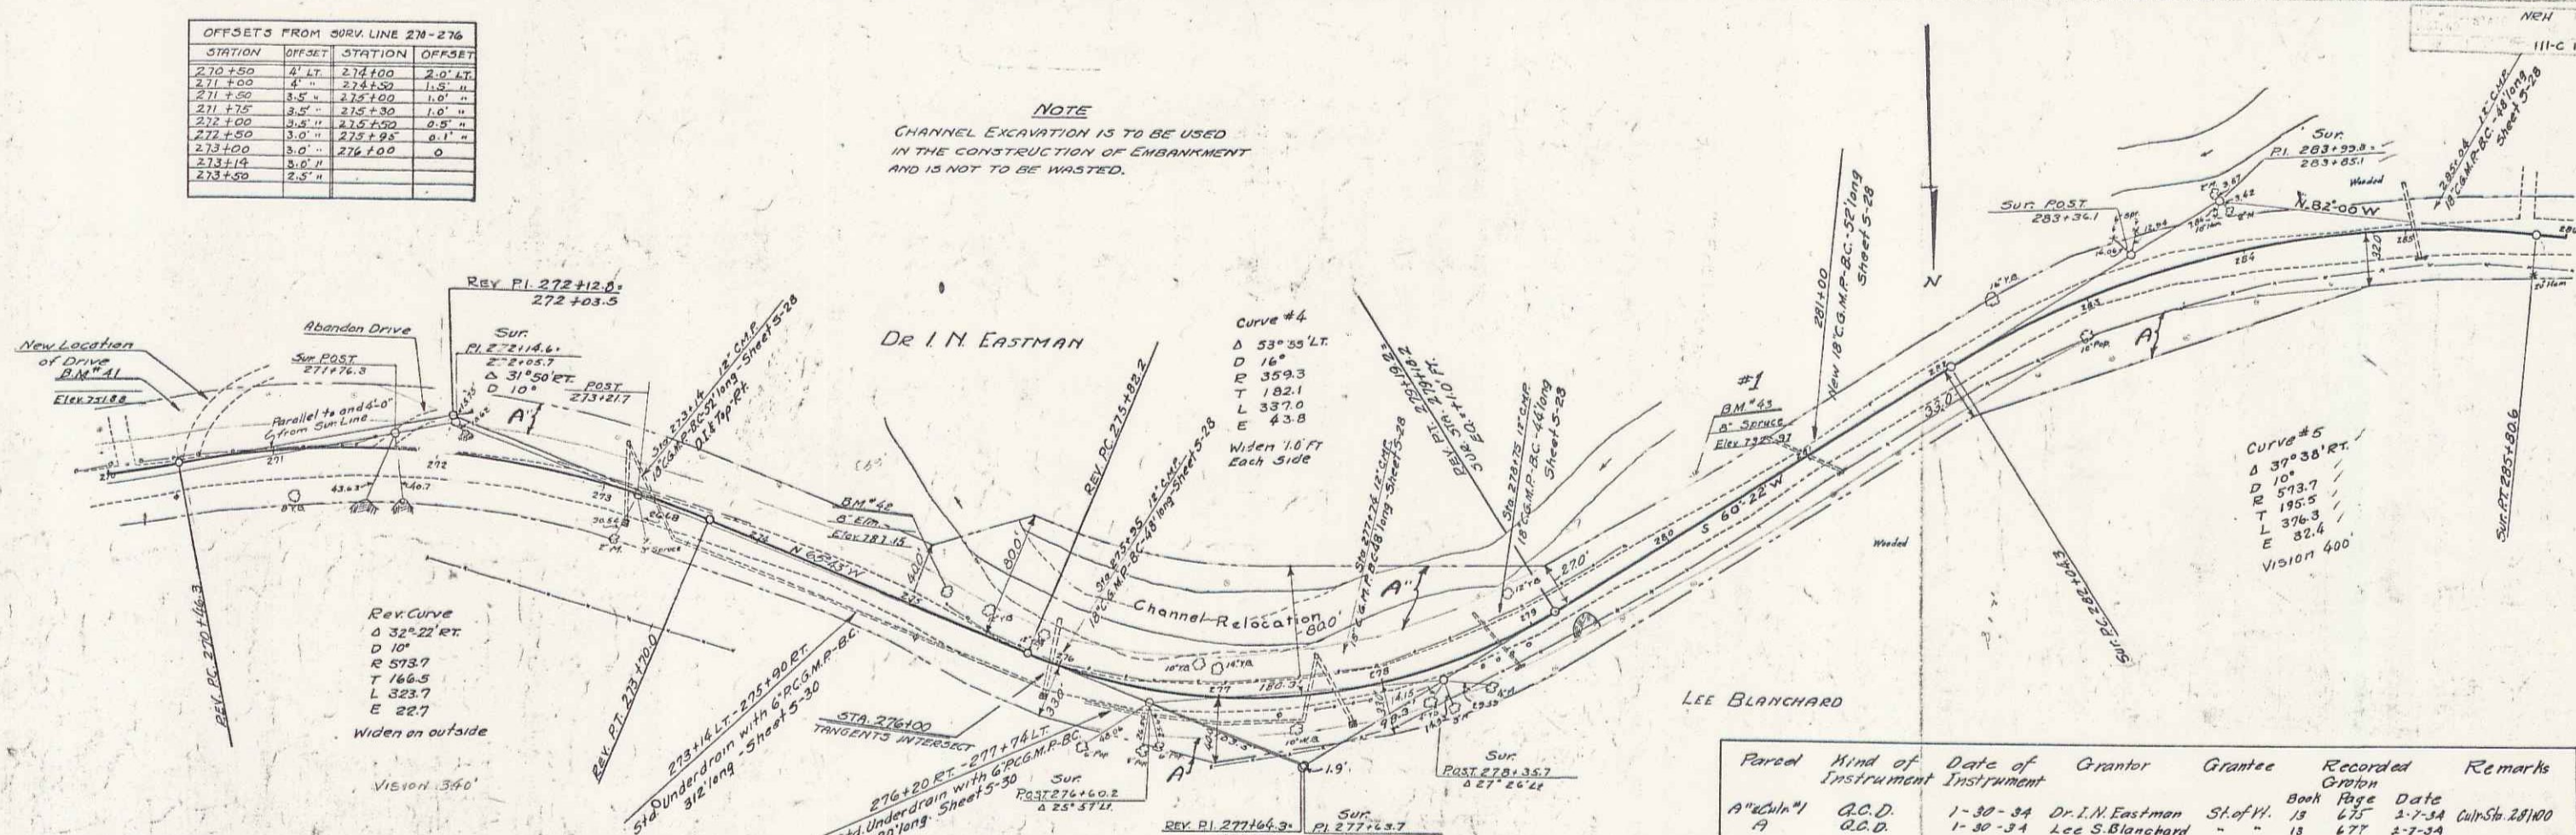

Parcel	Kind of Instrument	Date of Instrument	Grantor	Grantee	Recorded Book Page	Recorded Date	Remarks
A <sup>1</sup> & 1/2	C.C.D.	1-30-34	Dr. I. N. Eastman	St. of W.	13 651	1-7-34	Cal. St. 28100
A	C.C.D.	1-30-34	Lee S. Blanchard	"	13 677	1-7-34	

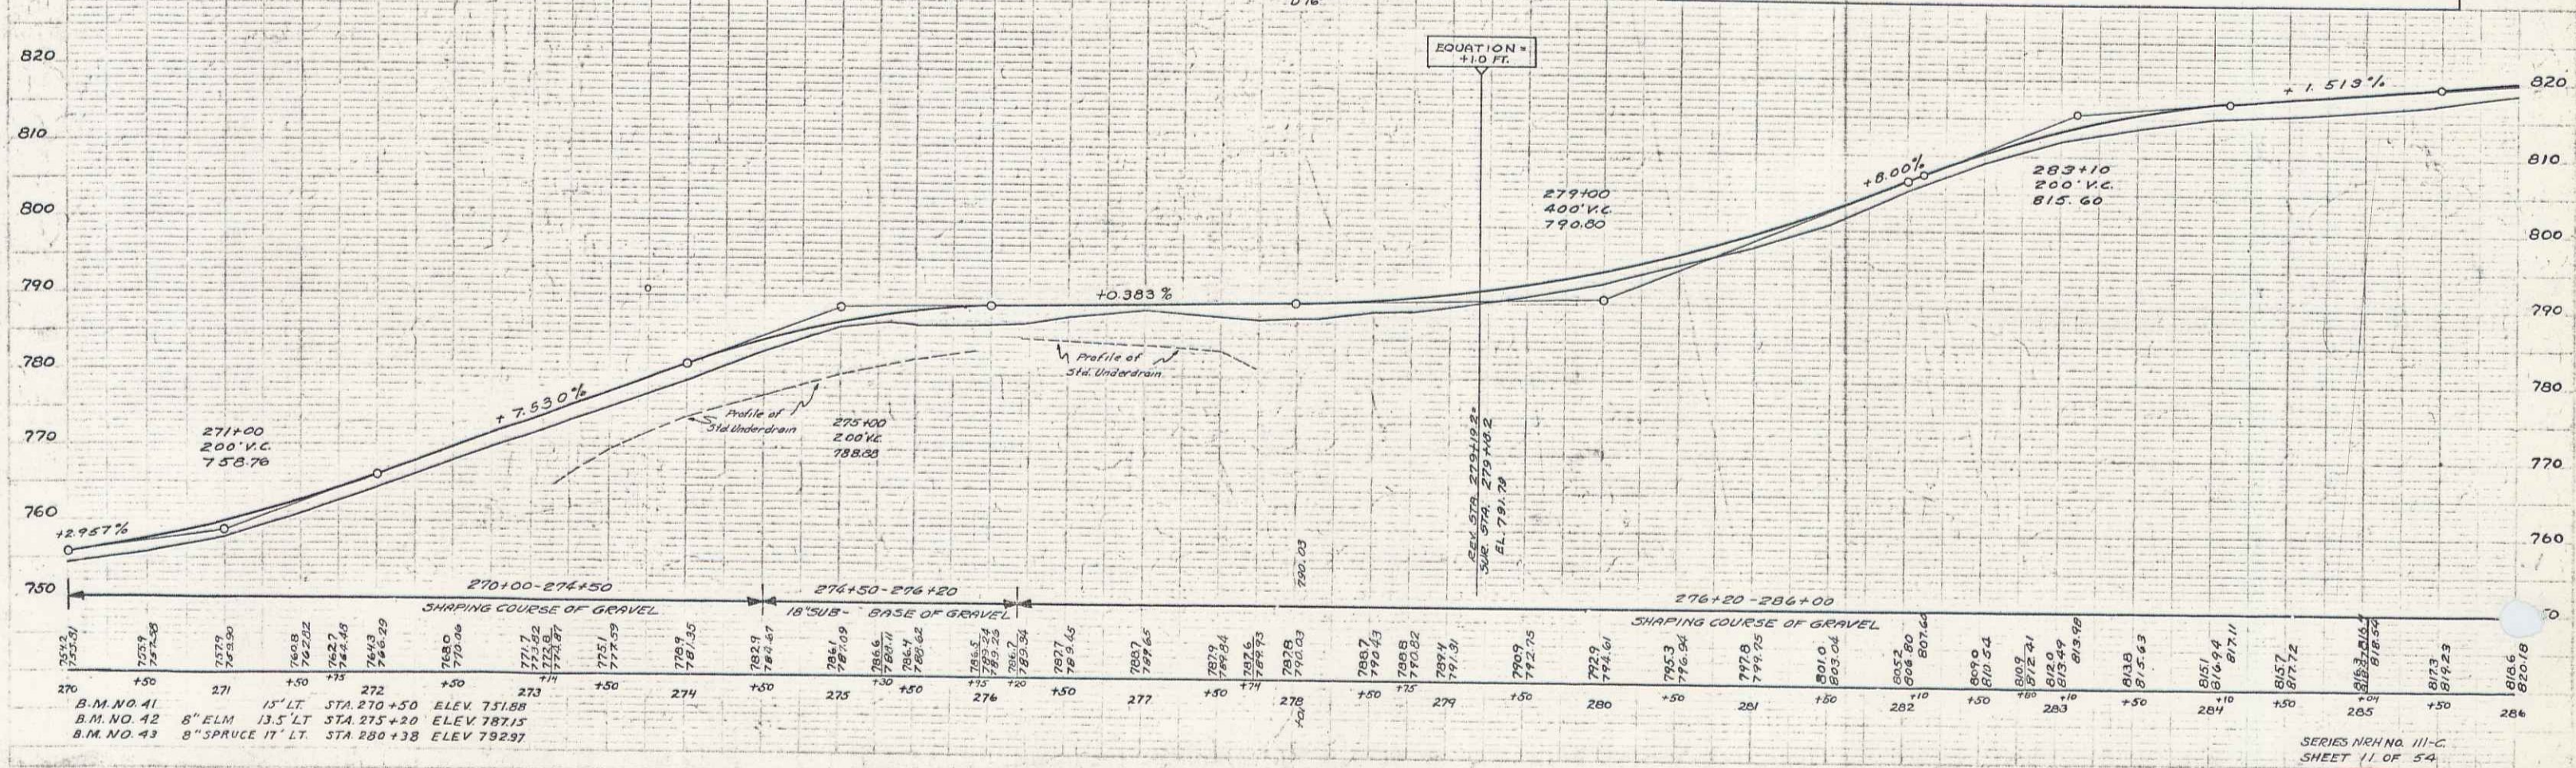

B.M. NO. 41 15' LT. STA 270+50 ELEV 751.89  
 B.M. NO. 42 6" ELM 13.5' LT. STA 275+20 ELEV 787.15  
 B.M. NO. 43 8" SPRUCE 17' LT. STA 280+38 ELEV 792.97