


Note: Second stage construction of N.R.H.-III-A is to include construction of gravel mixed-in-place surface course, gravel shoulders and guard rail. Grading, base and culverts have been constructed as first stage of Project N.R.H.-III-A by contract.

All base and culverts as noted on layouts refer to first stage construction. Guard rail notes for second stage construction are noted at top of lay out sheets.

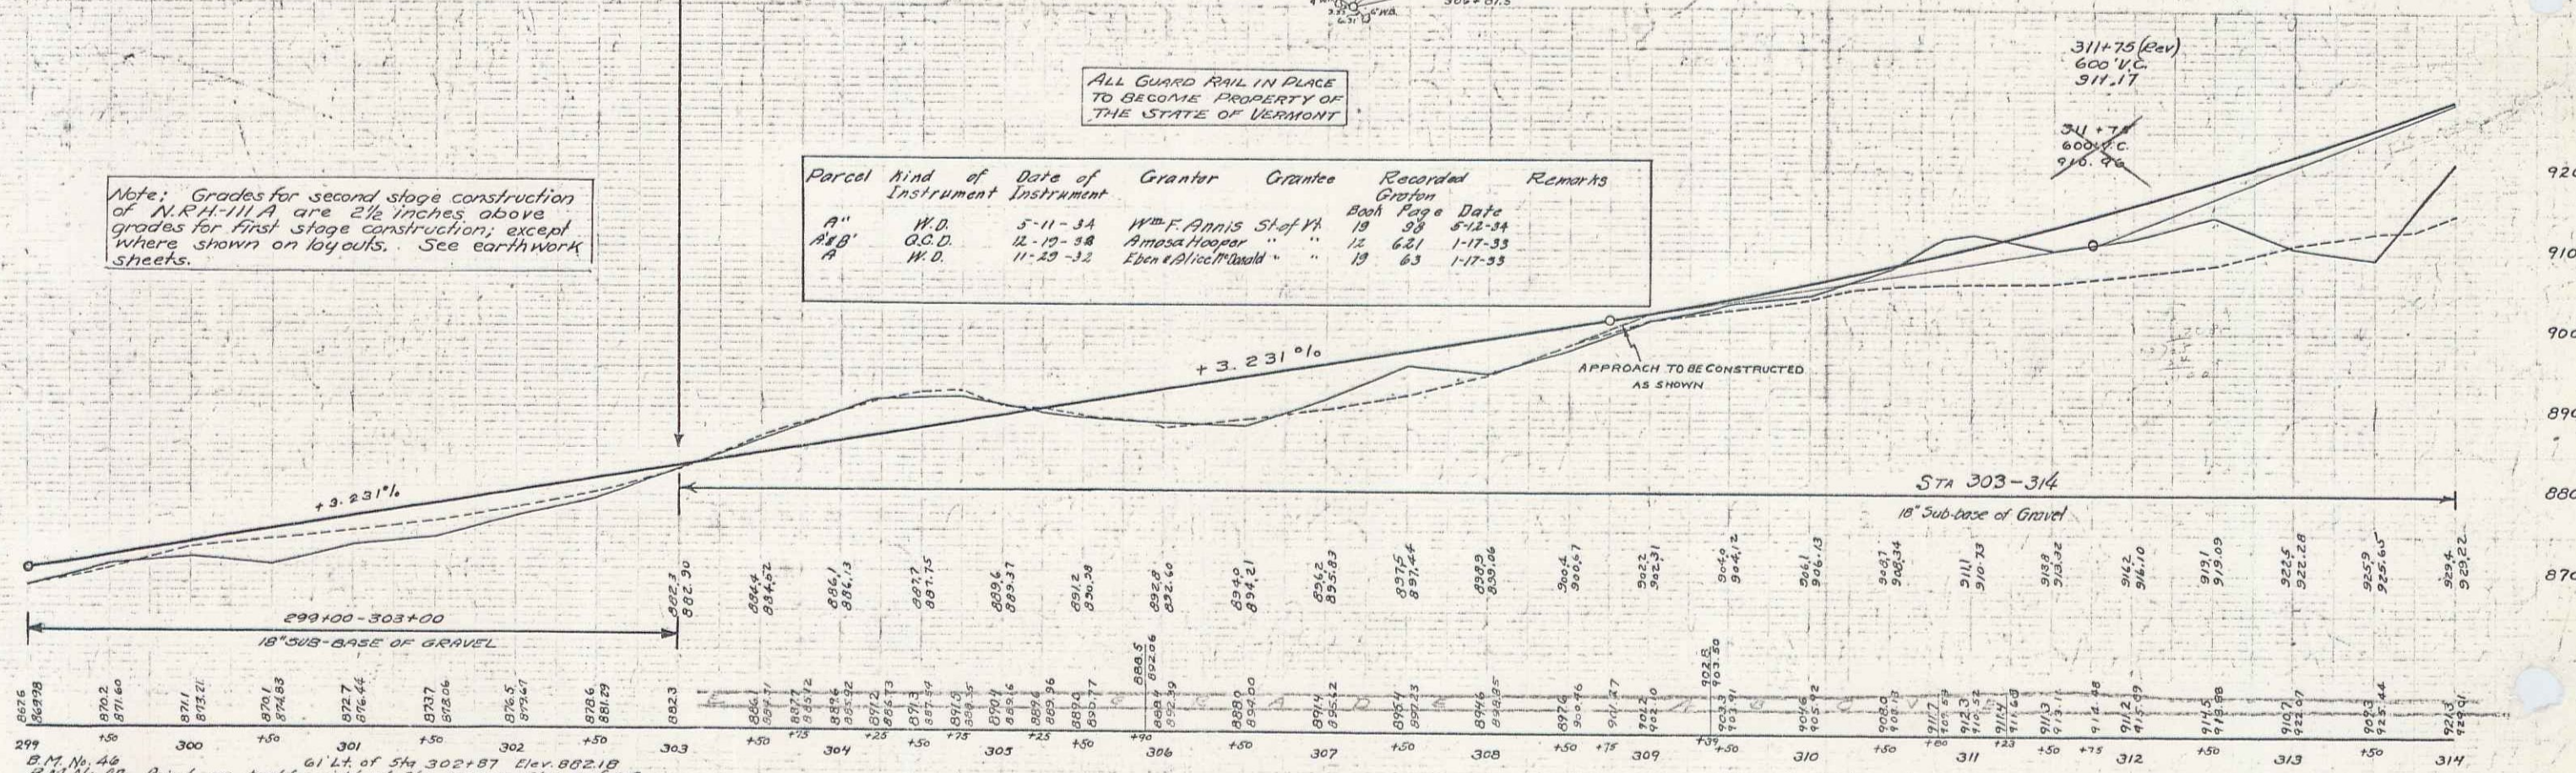

Parcel	Kind of Instrument	Date of Instrument	Grantor	Grantee	Recorded Copy	Remarks
A"	W.D.	5-11-34	W.F. Annis	Stuf Vt	Book 19 Page 33	5-12-34
A&B'	G.C.D.	12-19-38	Amasa Hooper	"	12 621	1-17-33
A	W.D.	11-29-32	Edna McDonald	"	19 63	1-17-33

B.M. No. 48
 61' Lt. of Sta 302+87 Elev. 882.18
 B.M. No. 47 Point on Boulder right of Sta. 303+00 Elev. 904.85