


Stone Curb
 9'70-10+60 ft.
 Stone Curbs to be built out
 of Granite blocks. This Curb
 is to be paid for on a Cost
 Plus Basis.

CONCRETE REINFORCED MASONRY WALL STA 10+60 TO
 15+23 RT. IS A MODIFIED DESIGN OF SKETCH
 SHOWN ON 3-30. SEE CROSS SECTIONS FOR
 HEIGHT REQUIRED. SEE 3-30 FOR CURB
 OUTER DESIGN.

Parcel	Kind of Instrument	Date of Instrument	Grantor	Grantee	Recorded	Remarks
A&C 11	G.C.D.	7-17-33	Mrs. Wm. Farquharson	St of H.	15 373	9-15-33 Ch 516 10181

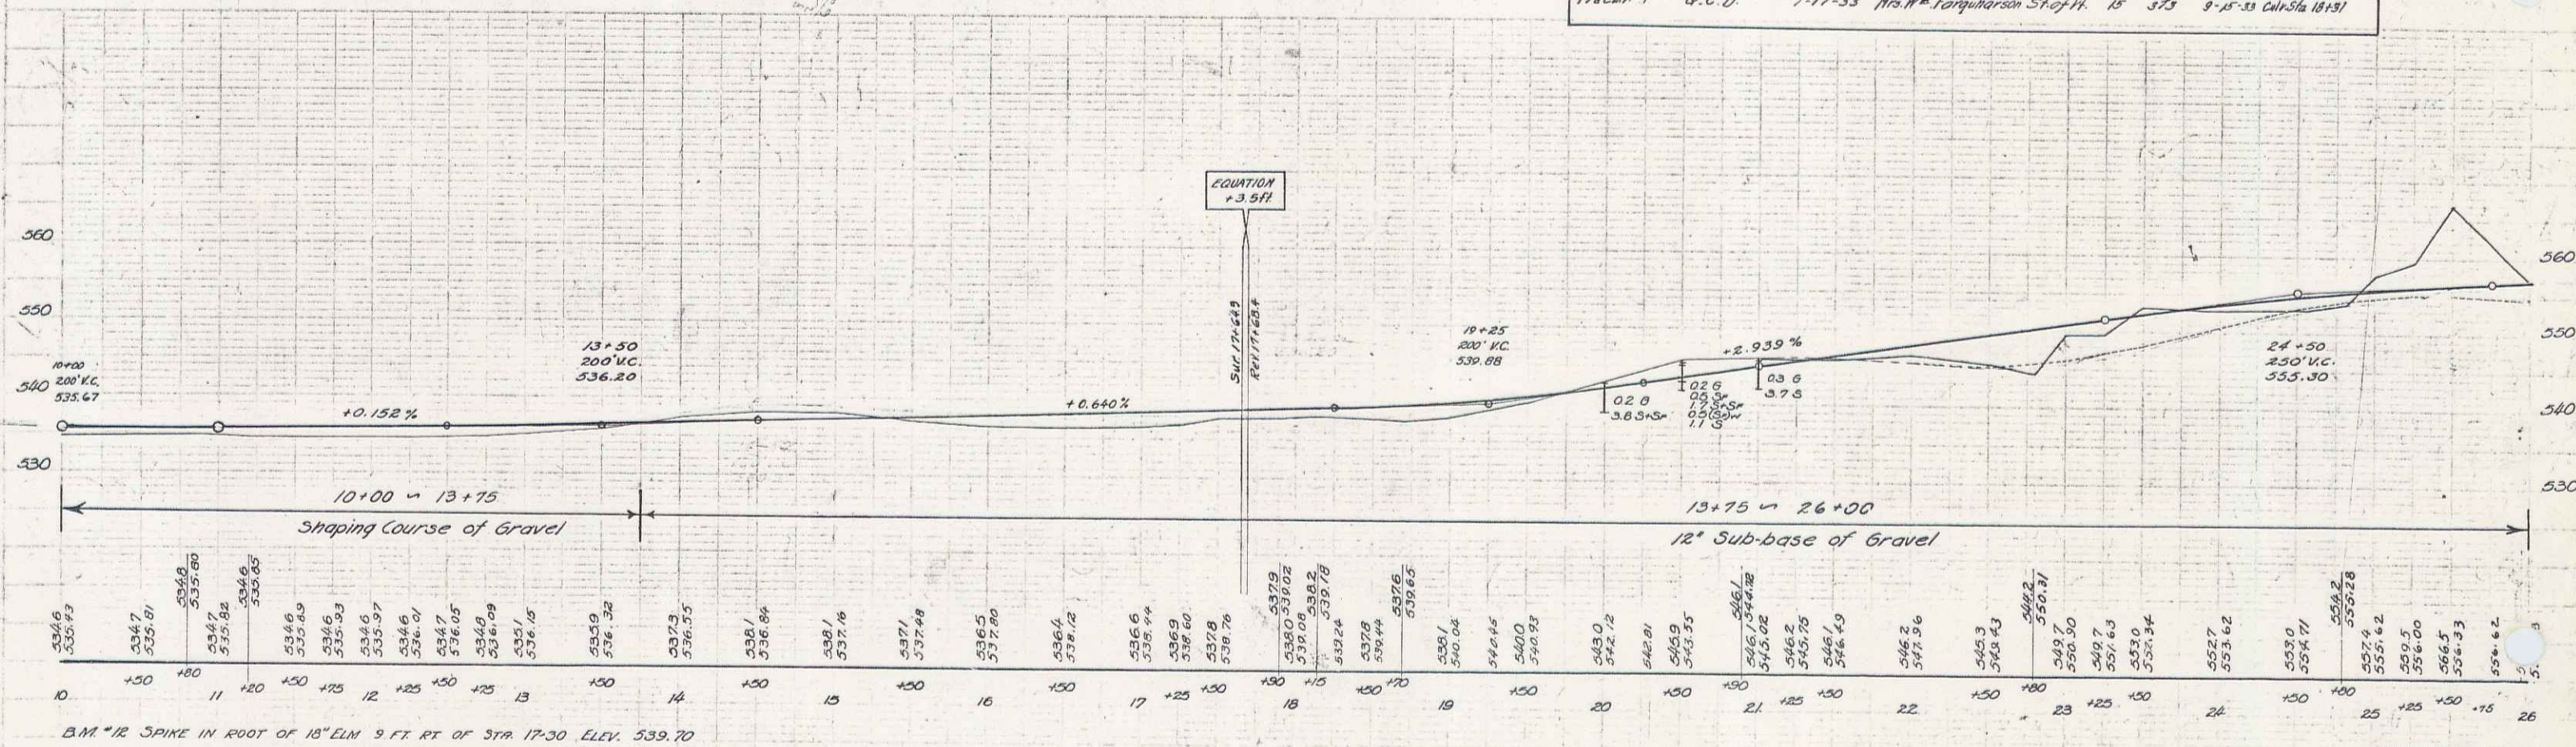

B.M. #12 SPIKE IN ROOT OF 13' ELM 9 FT. RT. OF STA 17-30. ELEV. 539.70