
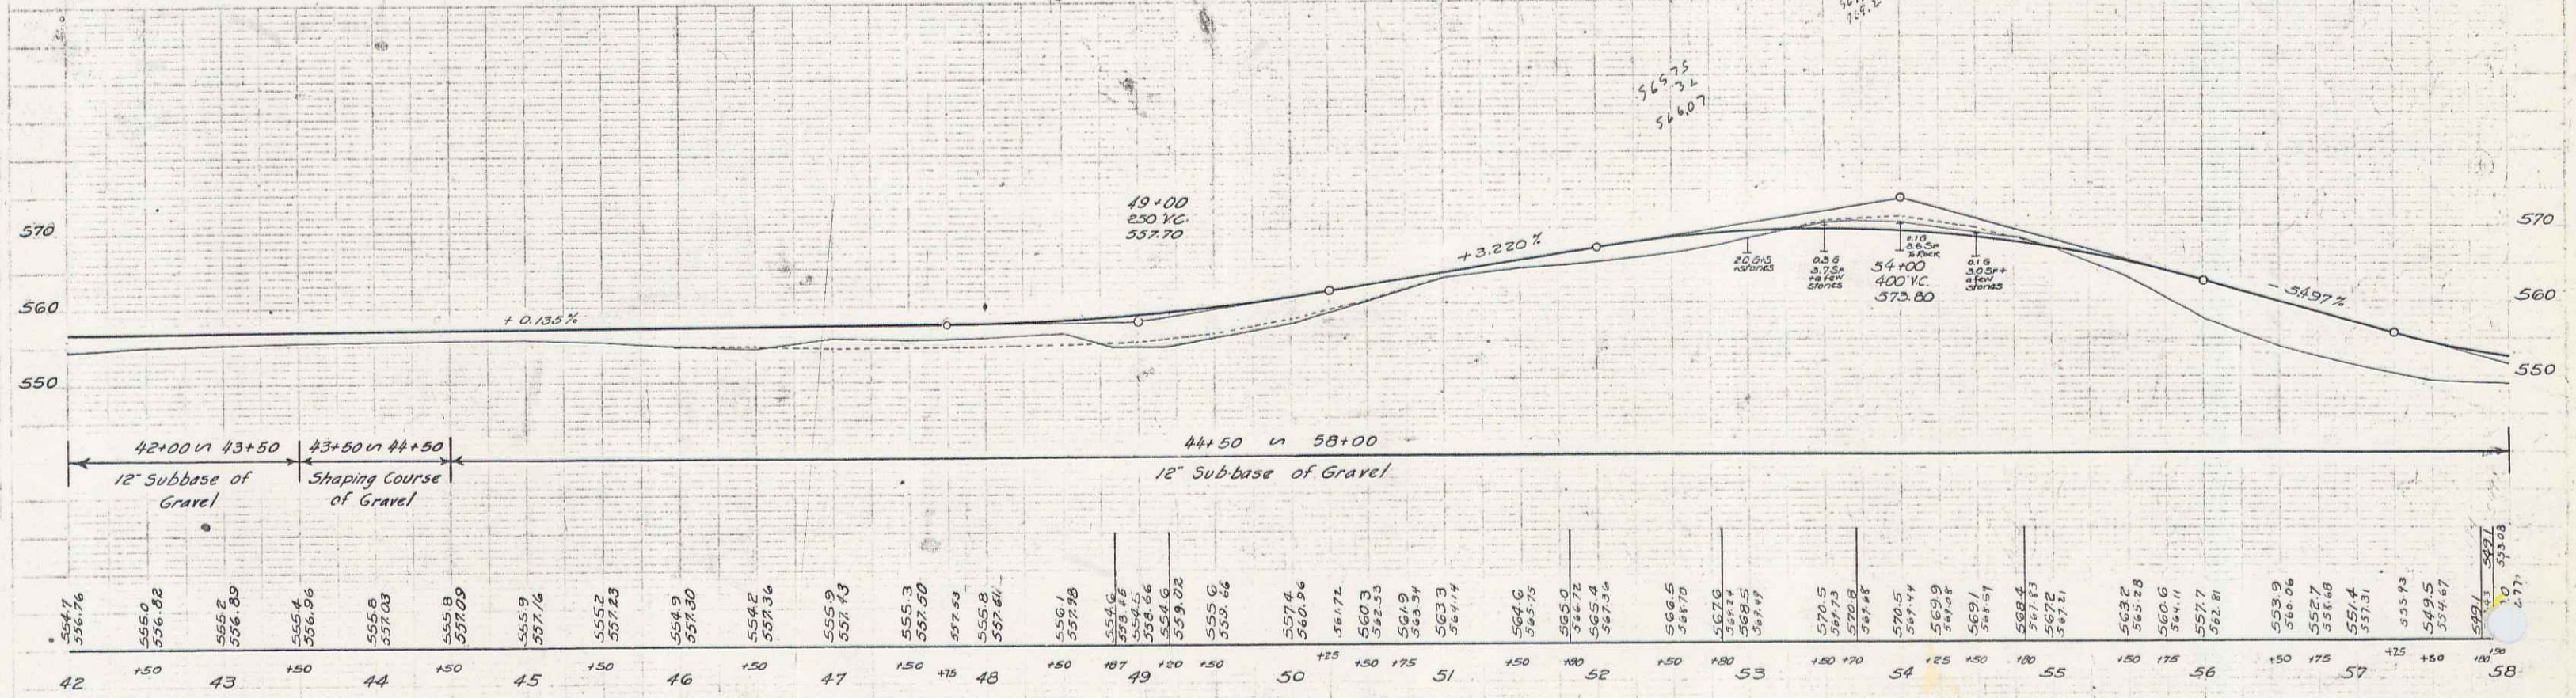


Parcel	Kind of Instrument	Date of Instrument	Grantor	Grantee	Recorded Page	Remarks
B&C	O.C.D.	7-17-33	Mrs Wm. Farquharson	St. of Pk	15	374 9-15-33
C' & C' & J	O.C.D.	7-17-33	G. P. Sanderson	"	15	375 9-15-33 Cult. Str. 51160
A	O.C.D.	7-17-33	H. L. James	"	15	376 9-15-33

FED. ROAD DIST. NO. STATE I.D. NO. TYPICAL SHEET TOTAL SHEETS
 E-11-B 1932 7 72

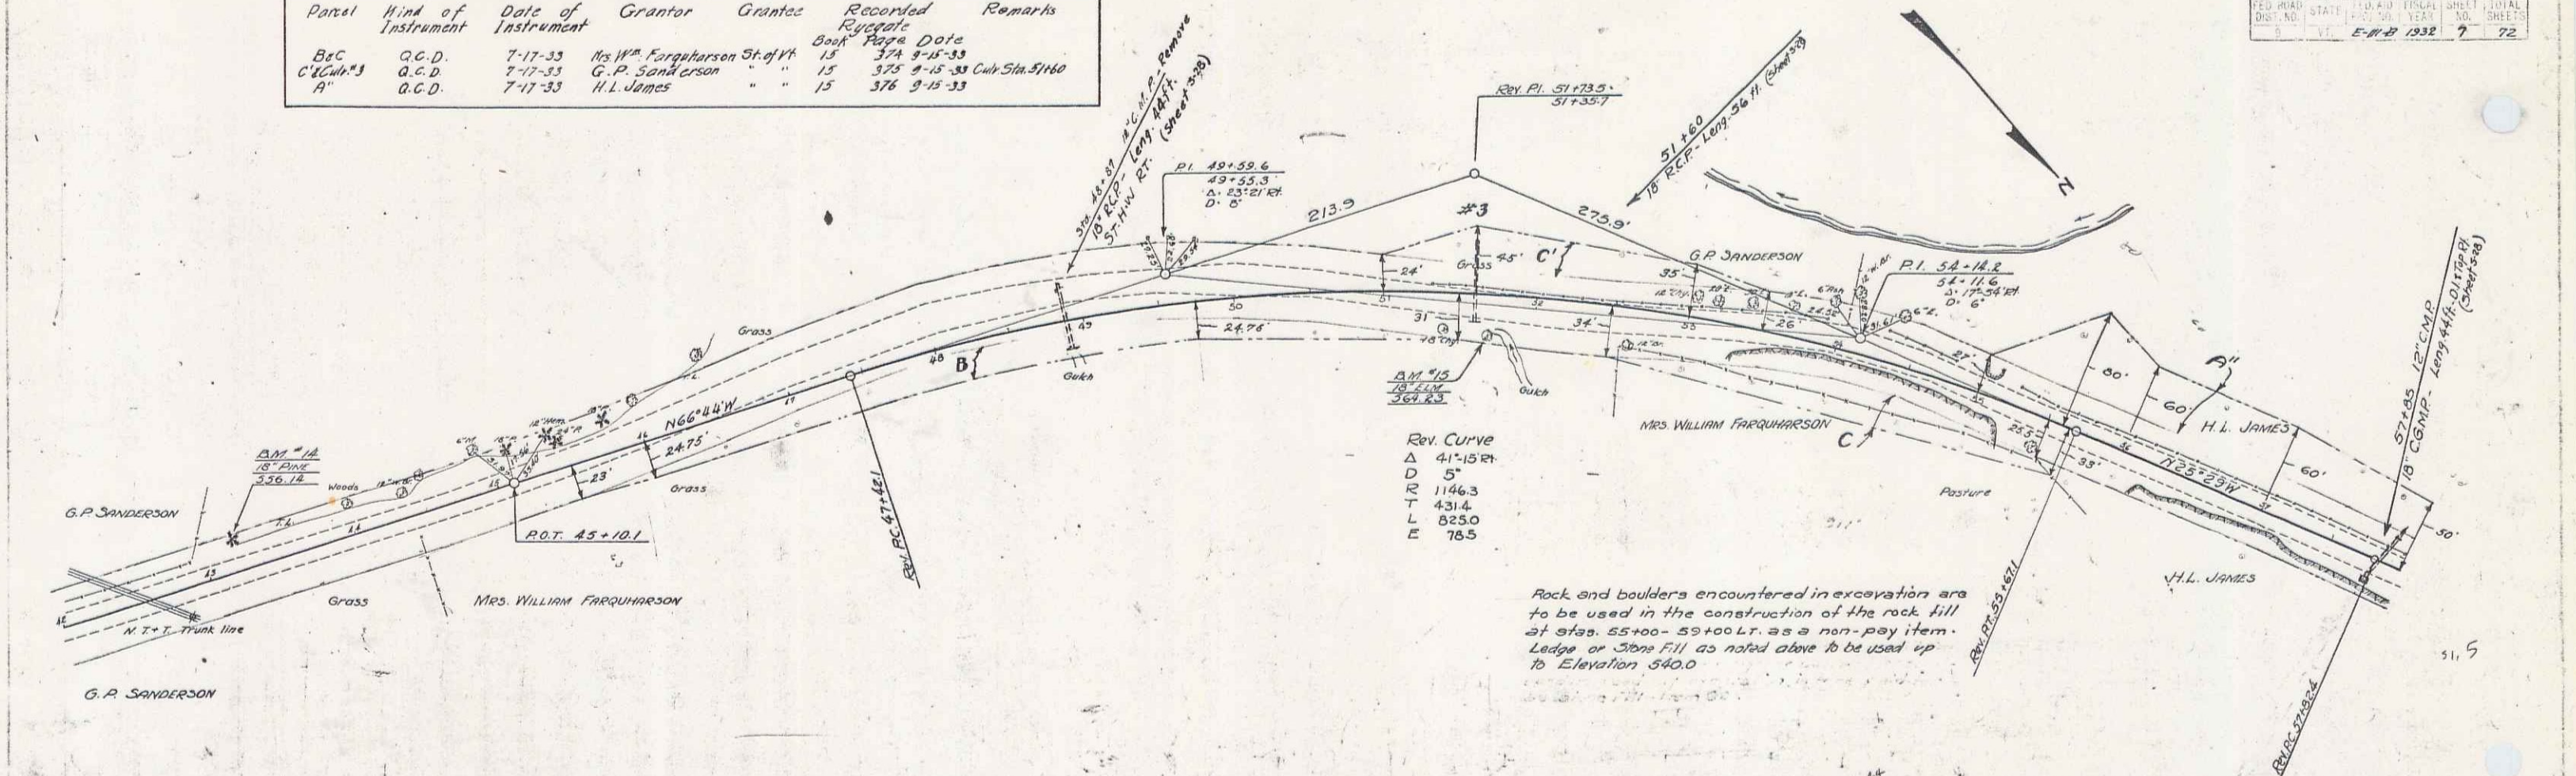

B.M. #14 SPIKE IN ROOT OF 10" PINE 17 FT. LT. OF STR. 43+22 ELEV. 556.14
 B.M. #15 " " " " 10" ELM 23 FT. RT. OF STR. 51+71 " 564.23

SERIES F. NO. E-11-B
 SHEET 7 OF 72

5