
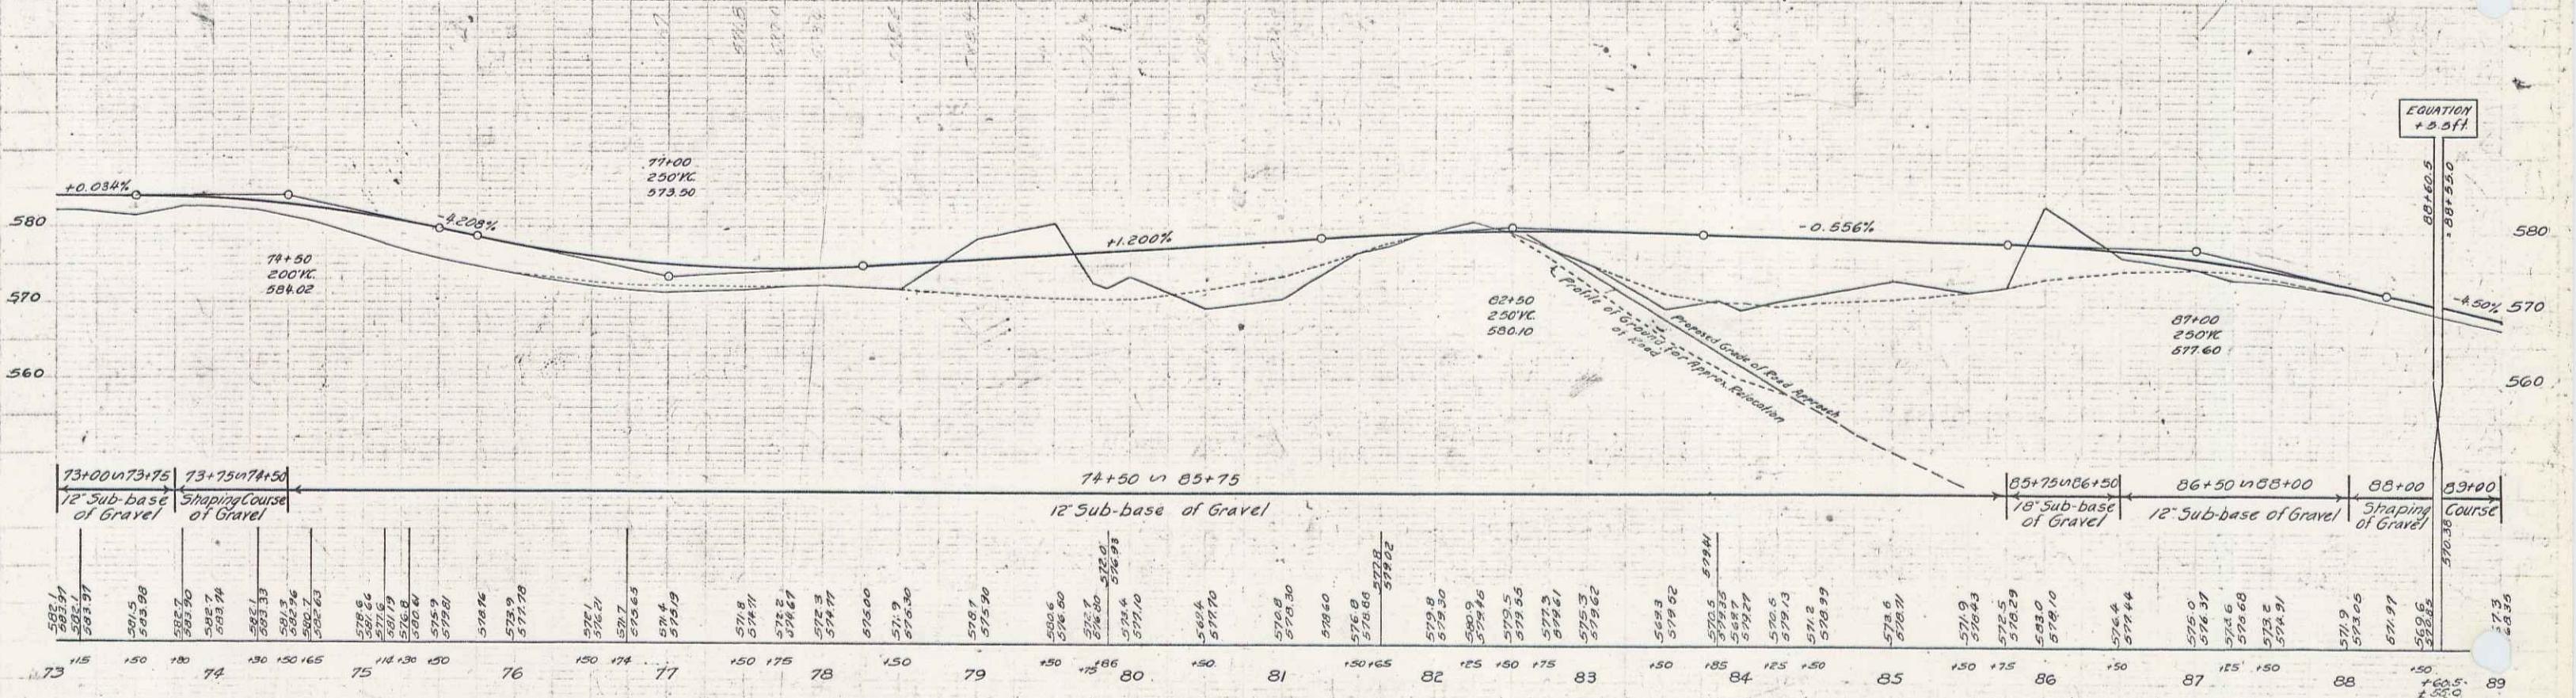


Parcel	Kind of Instrument	Date of Grant	Grantor	Grantee	Recorded	Remarks
A, B, C	O.C.D.	8-23-33	H.R. & H.T. Brown	St. of H.	15 378	8-15-33

FEDERAL ROAD DISTRICT NO. 1
 STATE OF MISSISSIPPI
 E. & E. 1933 9 72

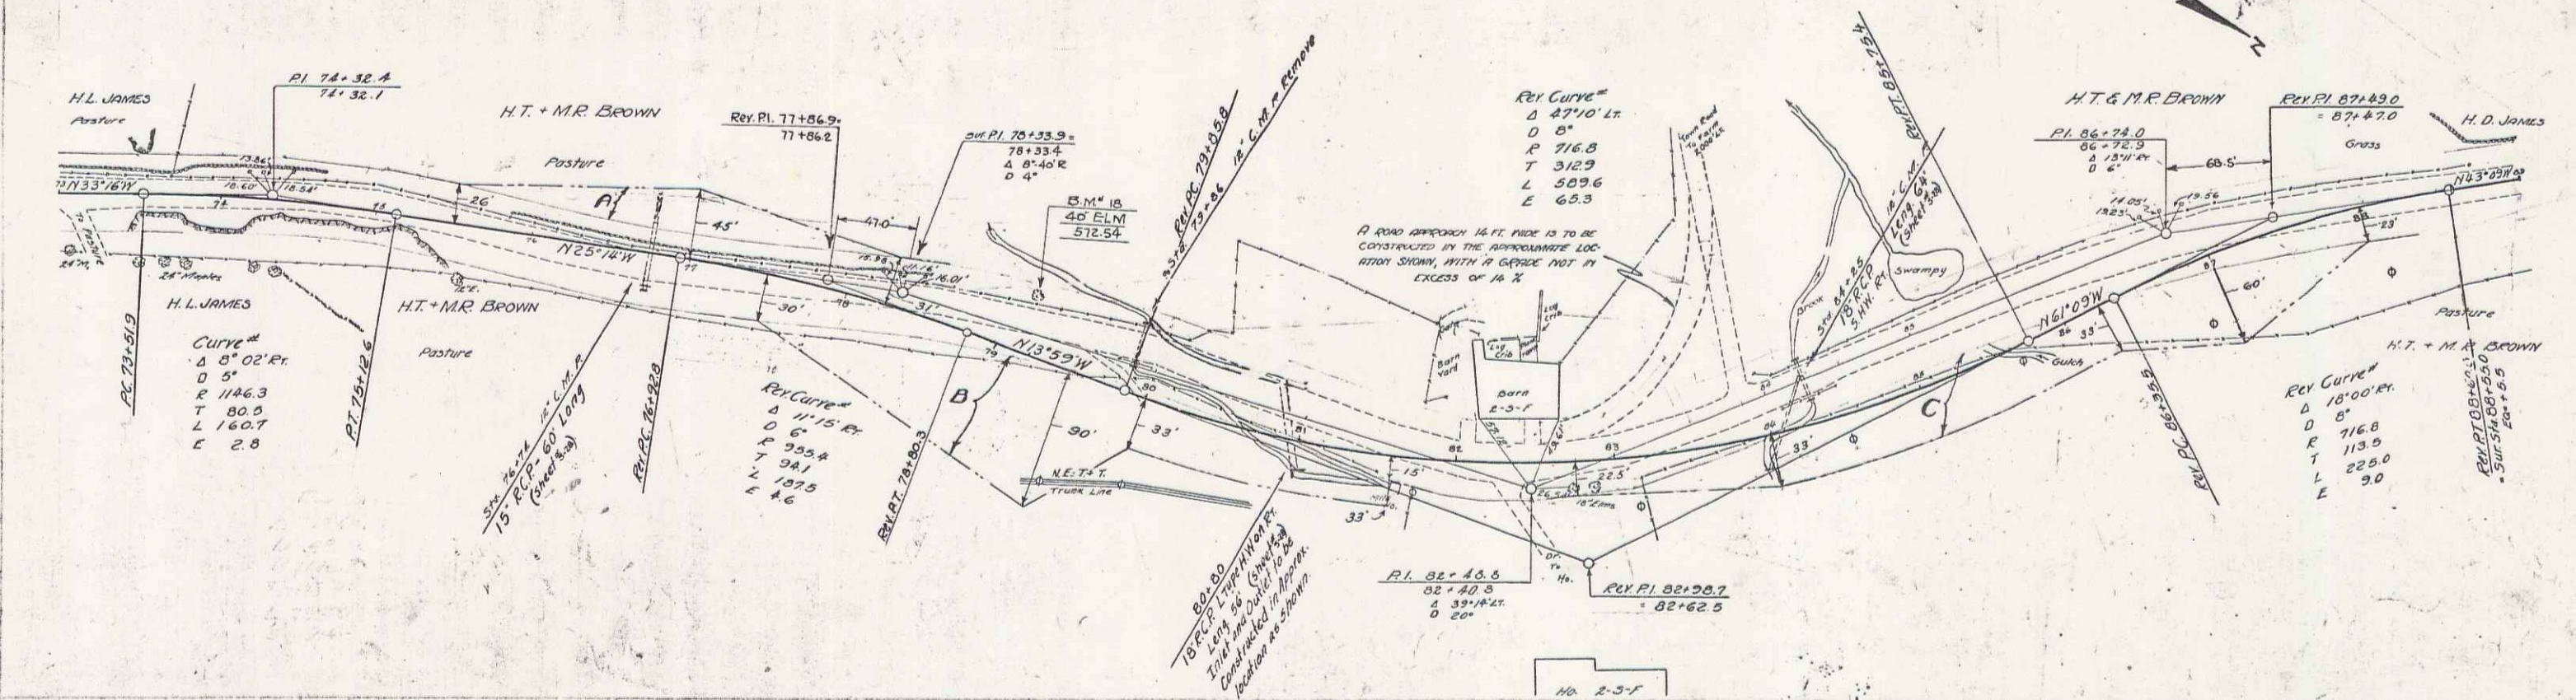

B.M. 13 SPIKE IN SIDE OF 40' ELM 34 FT. LT. OF STR. 78+30 ELEV. 572.54

EQUATION +3.5 ft
 SERIES F NO. E-111-B
 SHEET 9 OF 72