
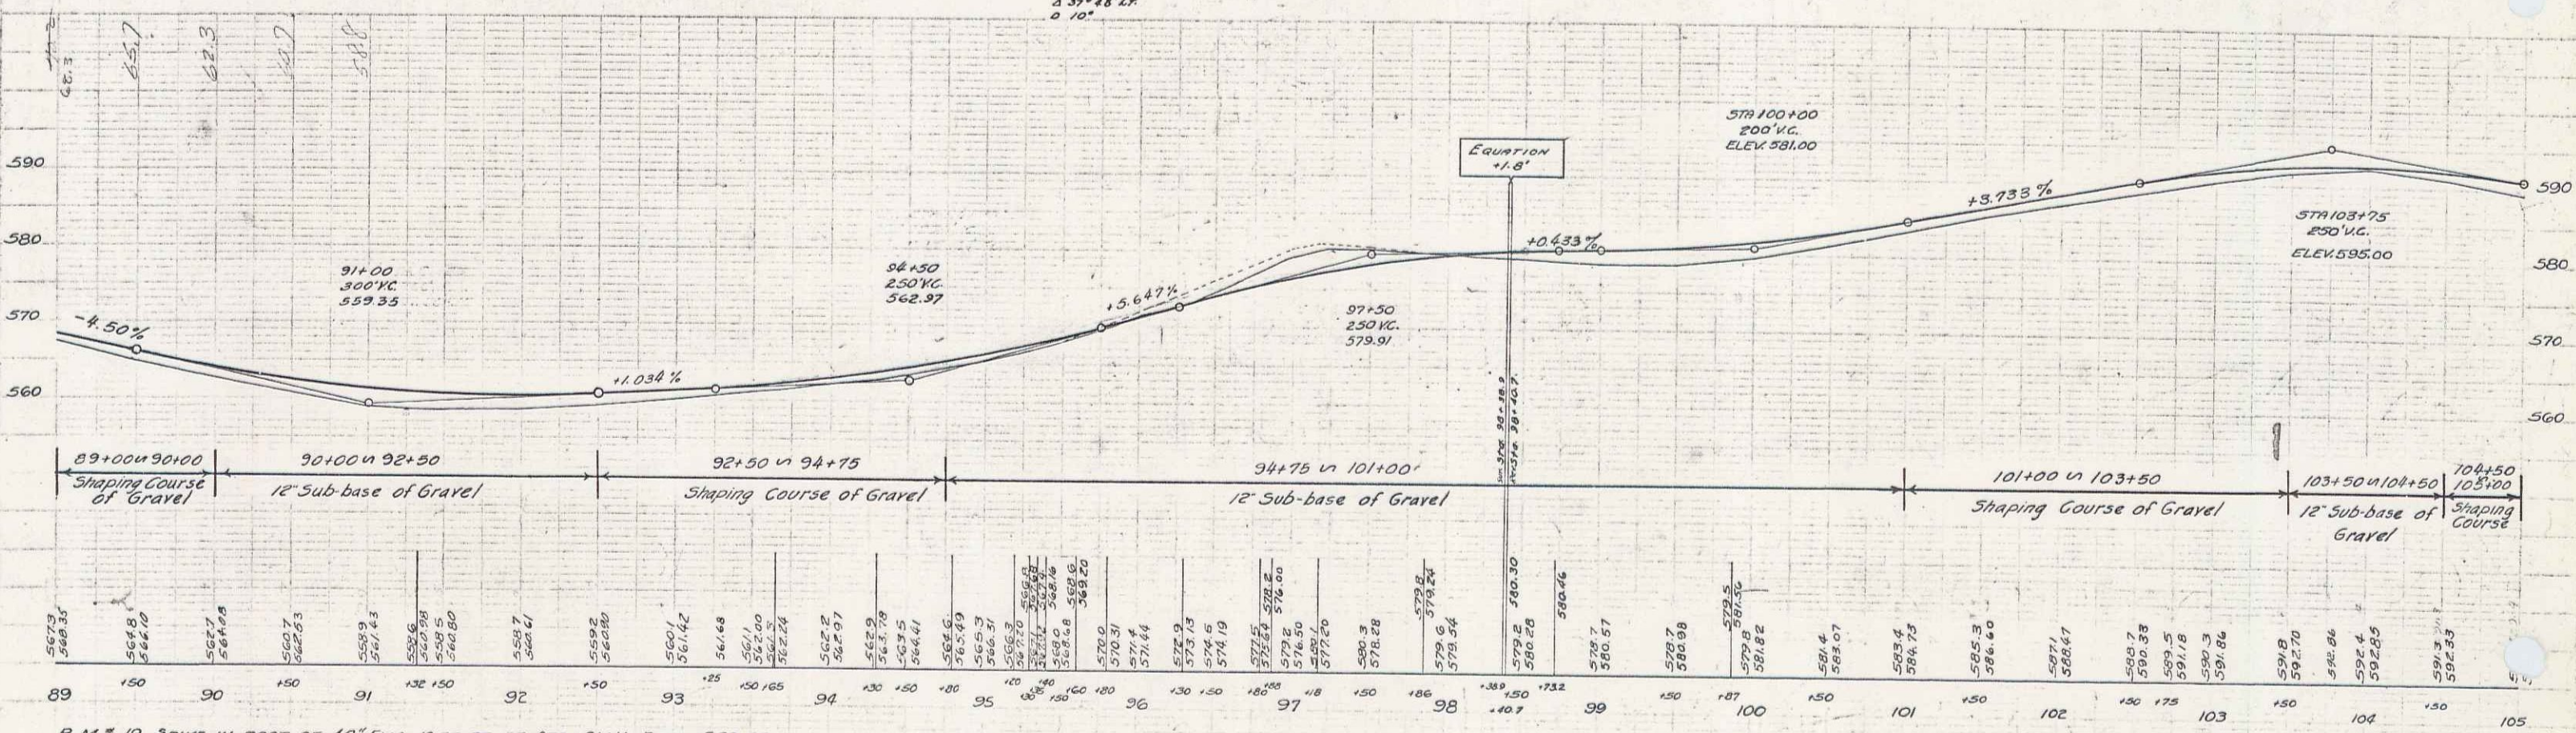


Parcel	Kind of Instrument	Date of Instrument	Grantor	Grantee	Recorded	Remarks
A1B	G.C.D.	7-17-33	John French	St. of V.	13 531.2	7-16-33
A'	G.C.D.	7-17-33	H. D. James	St. of V.	15 577	8-15-33 Ryegate

DIST. NO. 10
 SHEETS 72
 E-11-B 1933 10 72

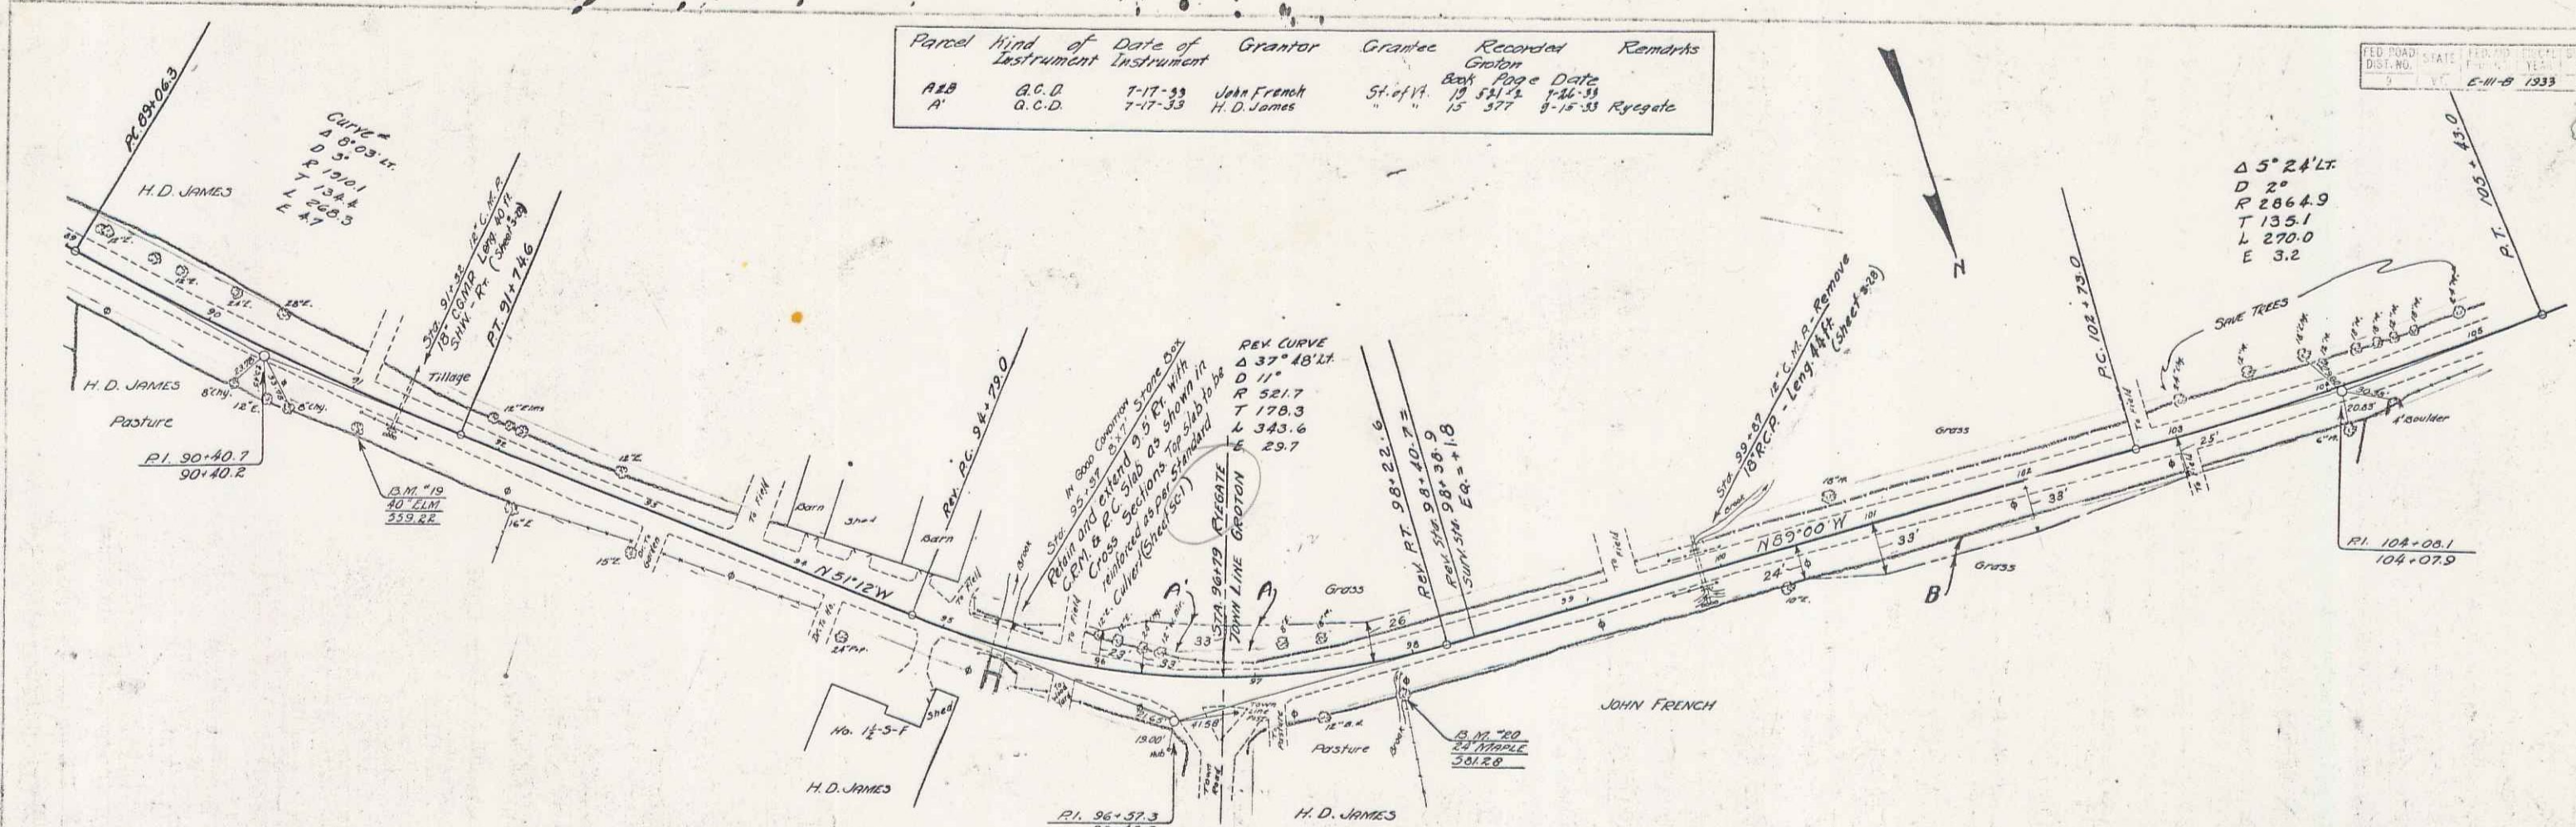

B.M. 19 SPIKE IN ROOT OF 40' ELM 18 FT. RT. OF STA. 91+11 ELEV. 559.22
 B.M. 20 " " " 24' MAPLE 21 " " " 97+80 " 581.28

SERIES NO. E-11-B
 SHEET 10 OF 72

8