

INDEX OF SHEETS

SHEET NO. 1	TITLE PAGE
2	TYPICAL CROSS SECTION OF IMPROVEMENT, 13' BIT. CONC. PAVT. ITEM 361-B MOD.
3-4	QUANTITY SHEETS (ITEMS)
5	QUANTITY SHEET (DRAINAGE)
6-9	EARTHWORK SHEETS
10-23	PLAN AND PROFILE SHEETS
24	BRIDGE, PRELIMINARY INFORMATION SHEET
25	BRIDGE, QUANTITY SHEET (ITEMS)
26	BRIDGE, BORING LOG
27	BRIDGE, PLAN AND ELEVATION
28	BRIDGE, FRAMING PLAN, STONE FILL AND CHANNEL DETAILS
29	BRIDGE, ABUTMENT NO. 1
30	BRIDGE, ABUTMENT NO. 2
31	BRIDGE, DETAILS OF PIERS #1 AND #2
32	BRIDGE, DETAILS OF APPROACH SLAB #1
33	BRIDGE, DETAILS OF APPROACH SLAB #2
34	BRIDGE, NEWFORMING STEEL SCHEDULE
35-39	BRIDGE, CHANNEL CROSS SECTION
40	BRIDGE, SB-50-60, SHEET 1
41	BRIDGE, SB-50-60, SHEET 2
42	BRIDGE, SB-30-60
43	BRIDGE, SB-30-60
44	BRIDGE, SB-22-60
45	BRIDGE, SB-D-60
46	4'-6" (CORNLING AND BLASTING OF SOLID ROCK SUBGRADE)
47	B-1 (BRANKING TABLES)
48	B-5 (TYPICAL SLOPE GRADINGS)
49	C-1 (CURBS-BITUMINOUS CONCRETE SIDEWALK)
50	D-2 (UNDERDRAIN)
51	D-3 (GUTTER)
52	D-4 (FISHING BASINS)
53	D-8 (CROP INLETS)
54	D-9 (DROP INLET TOP WITH CONC. CURB)
55	D-11 (DROP INLET GRATE)
56	D-13 (CONC. CATCH BASIN)
57	E-1 (BARRICADES, SIGNS AND LIGHTS)
58	E-31 (CONSTRUCTION IDENTIFICATION SIGNS)
59	G-3 (THREE CABLE GUARD RAIL WITH STEEL POSTS)
60	G-4 (STEEL MARKER POSTS)
61	J-1 (PROJECT MARKERS)
62	DETAILS 18" X 10" C.G.M.P.P.A. - STA. 809+00
63	DETAILS 18" X 10" C.G.M.P.P.A. - STA. 891+28
64-145	CROSS SECTIONS
9 A-D	INDEX OF SHEETS USED IN FINALS
9 A-D	FINAL EARTHWORK SHEETS
9 A-F	FINAL DRAWINGS - BRIDGE
9 A-T	FINAL SHEETS
134-148	BORROW PIT SECTIONS
139-144	CHANNEL SECTION SHEETS

POOR ORIGINAL COPY

STATE OF VERMONT
DEPARTMENT OF HIGHWAYS

PROPOSED IMPROVEMENT

FEDERAL PROJECT

TOWNS OF RYEGATE-NEWBURY

COUNTIES OF CALEDONIA AND ORANGE

U. S. ROUTE 302

BARRE - WELLS RIVER ROAD

BEGINNING AT A POINT 12,072.1 FEET NORTHWESTERLY OF THE RYEGATE-NEWBURY TOWN LINE AND EXTENDING SOUTH-EASTERLY 13,203.1 FEET.


LENGTH OF ROADWAY 13,071.1 FEET = 2.475 MILES
LENGTH OF BRIDGE 132.0 FEET = 0.025 MILES
LENGTH OF PROJECT 13,203.1 FEET = 2.500 MILES

ADT (1957)	790 - 980
ADT (1960)	1275 - 1600
DHV	195 - 230
D	55%
T	15%
MPH	50

RIGHT-OF-WAY DIVISION
TOWN FILE

PERPETUAL

Route
Town of US 302
(To Be Returned To R.O.W. Division)

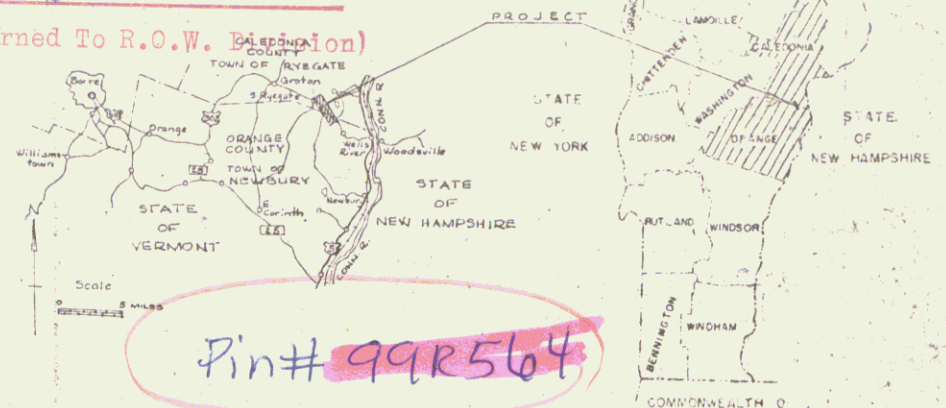

Pin# 99R564

PROJECT NAME & NUMBER TYPE PAVEMENT AREA
RYEGATE-NEWBURY F 026-1(1) 11" BIT. CONCRETE 35,219 S.Y.

RECORD PLANS

MATERIALS
SUBBASE OF GRAVEL - EASTMAN PIT, SOUTH RYEGATE, VERMONT
SUBBASE OF SAND - EASTMAN & LEETZ PIT, S. RYEGATE, VT.
SUBBASE OF CRUSHED ROCK - CALEDONIA SAND & GRAVEL CO.
CONCRETE - D & D CONCRETE, MONTPELIER, VERMONT
REINF. STEEL - REPUBLIC STEEL CORP., BOSTON, MASS.
STRUCTURAL STEEL - VERMONT STRUCTURAL STEEL CORP.
TAR - W.T.CO. WORCESTER, MASS.
ASPHALT - HUMBLE OIL CO., EVERETT, MASS.
TAR EMULSION - BORDEN CHEMICAL CO. NEW YORK, N.Y.
PEA STONE & STONE GRITS - KELLY CONST. CO., BARRE, VT.
BITUMINOUS CONCRETE - LAMPIKE, W. LEBANON, N.H.
R.C.P.P.F. - HUME PIPE OF NEW ENGLAND - WINSOR, VT.
A.C.C.G. METAL PIPE, ELBOWS & C.C.M.P. PIPE ARCH
NEW ENGLAND METAL CULVERT, WHITE RIVER JUNCTION, VT.
BRIDGE RAIL - VERMONT STRUCTURAL STEEL, BURLINGTON, VT.
THREE CABLE GUARD RAIL, STEEL GUIDE & MARKER POSTS & TUBER CURB - SIEGRISWOLD, WILLISTON, VT.
TREES, SHRUBS & VINES - PUTNEY NURSERY, PUTNEY, VERMONT

MP 0.222

END PROJECT F 026-1(1) 901+00.0'
BEGIN PROJECT F 026-1(4) (1959)

CONTRACTOR: SVRUS, CONSTRUCTION CO., INC.
TORRINGTON, CONN.
RESIDENT ENGINEER: JOHN WOOD
IN CHARGE: RUSSELL, JR. & RUSSELL
PROJECT ENGINEER: A.G. SPIDLE & R.R. RUSSELL, JR.
DATE: DEC. 26, 1963
DATE: FEB. 21, 1964
DATE: AUG. 20, 1965
DATE: AUG. 20, 1965

- CONVENTIONAL SIGNS
- ROW
 - COUNTY LINE
 - TOWN LINE
 - FENCE LINE
 - STONE WALL
 - UNFENCED PROPERTY
 - GUARD RAIL
 - TRAVELED WAY
 - RAILROAD
 - RETAINING WALL
 - DENER LINE
 - SURVEY LINE
 - CULVERT
 - URD WEEP
 - TROLLEY GLE
 - POWER POLE
 - TELEPHONE POLE
 - TREES

RYEGATE-NEWBURY F 026-1(1)
CONTRACTOR: SVRUS, CONSTRUCTION CO., INC.
TORRINGTON, CONN.
RESIDENT ENGINEER: JOHN WOOD
IN CHARGE: RUSSELL, JR. & RUSSELL
PROJECT ENGINEER: A.G. SPIDLE & R.R. RUSSELL, JR.
DATE: DEC. 26, 1963
DATE: FEB. 21, 1964
DATE: AUG. 20, 1965
DATE: AUG. 20, 1965

RYEGATE-NEWBURY F 026-1(1)
CONTRACTOR: SVRUS, CONSTRUCTION CO., INC.
TORRINGTON, CONN.
RESIDENT ENGINEER: JOHN WOOD
IN CHARGE: RUSSELL, JR. & RUSSELL
PROJECT ENGINEER: A