




ACQUIRED FROM CHARLES E. & ELIZABETH GIBSON AS
PARCEL 11B BY W.D. RECORDED 11/9/53 IN BK. 26 PG. 466

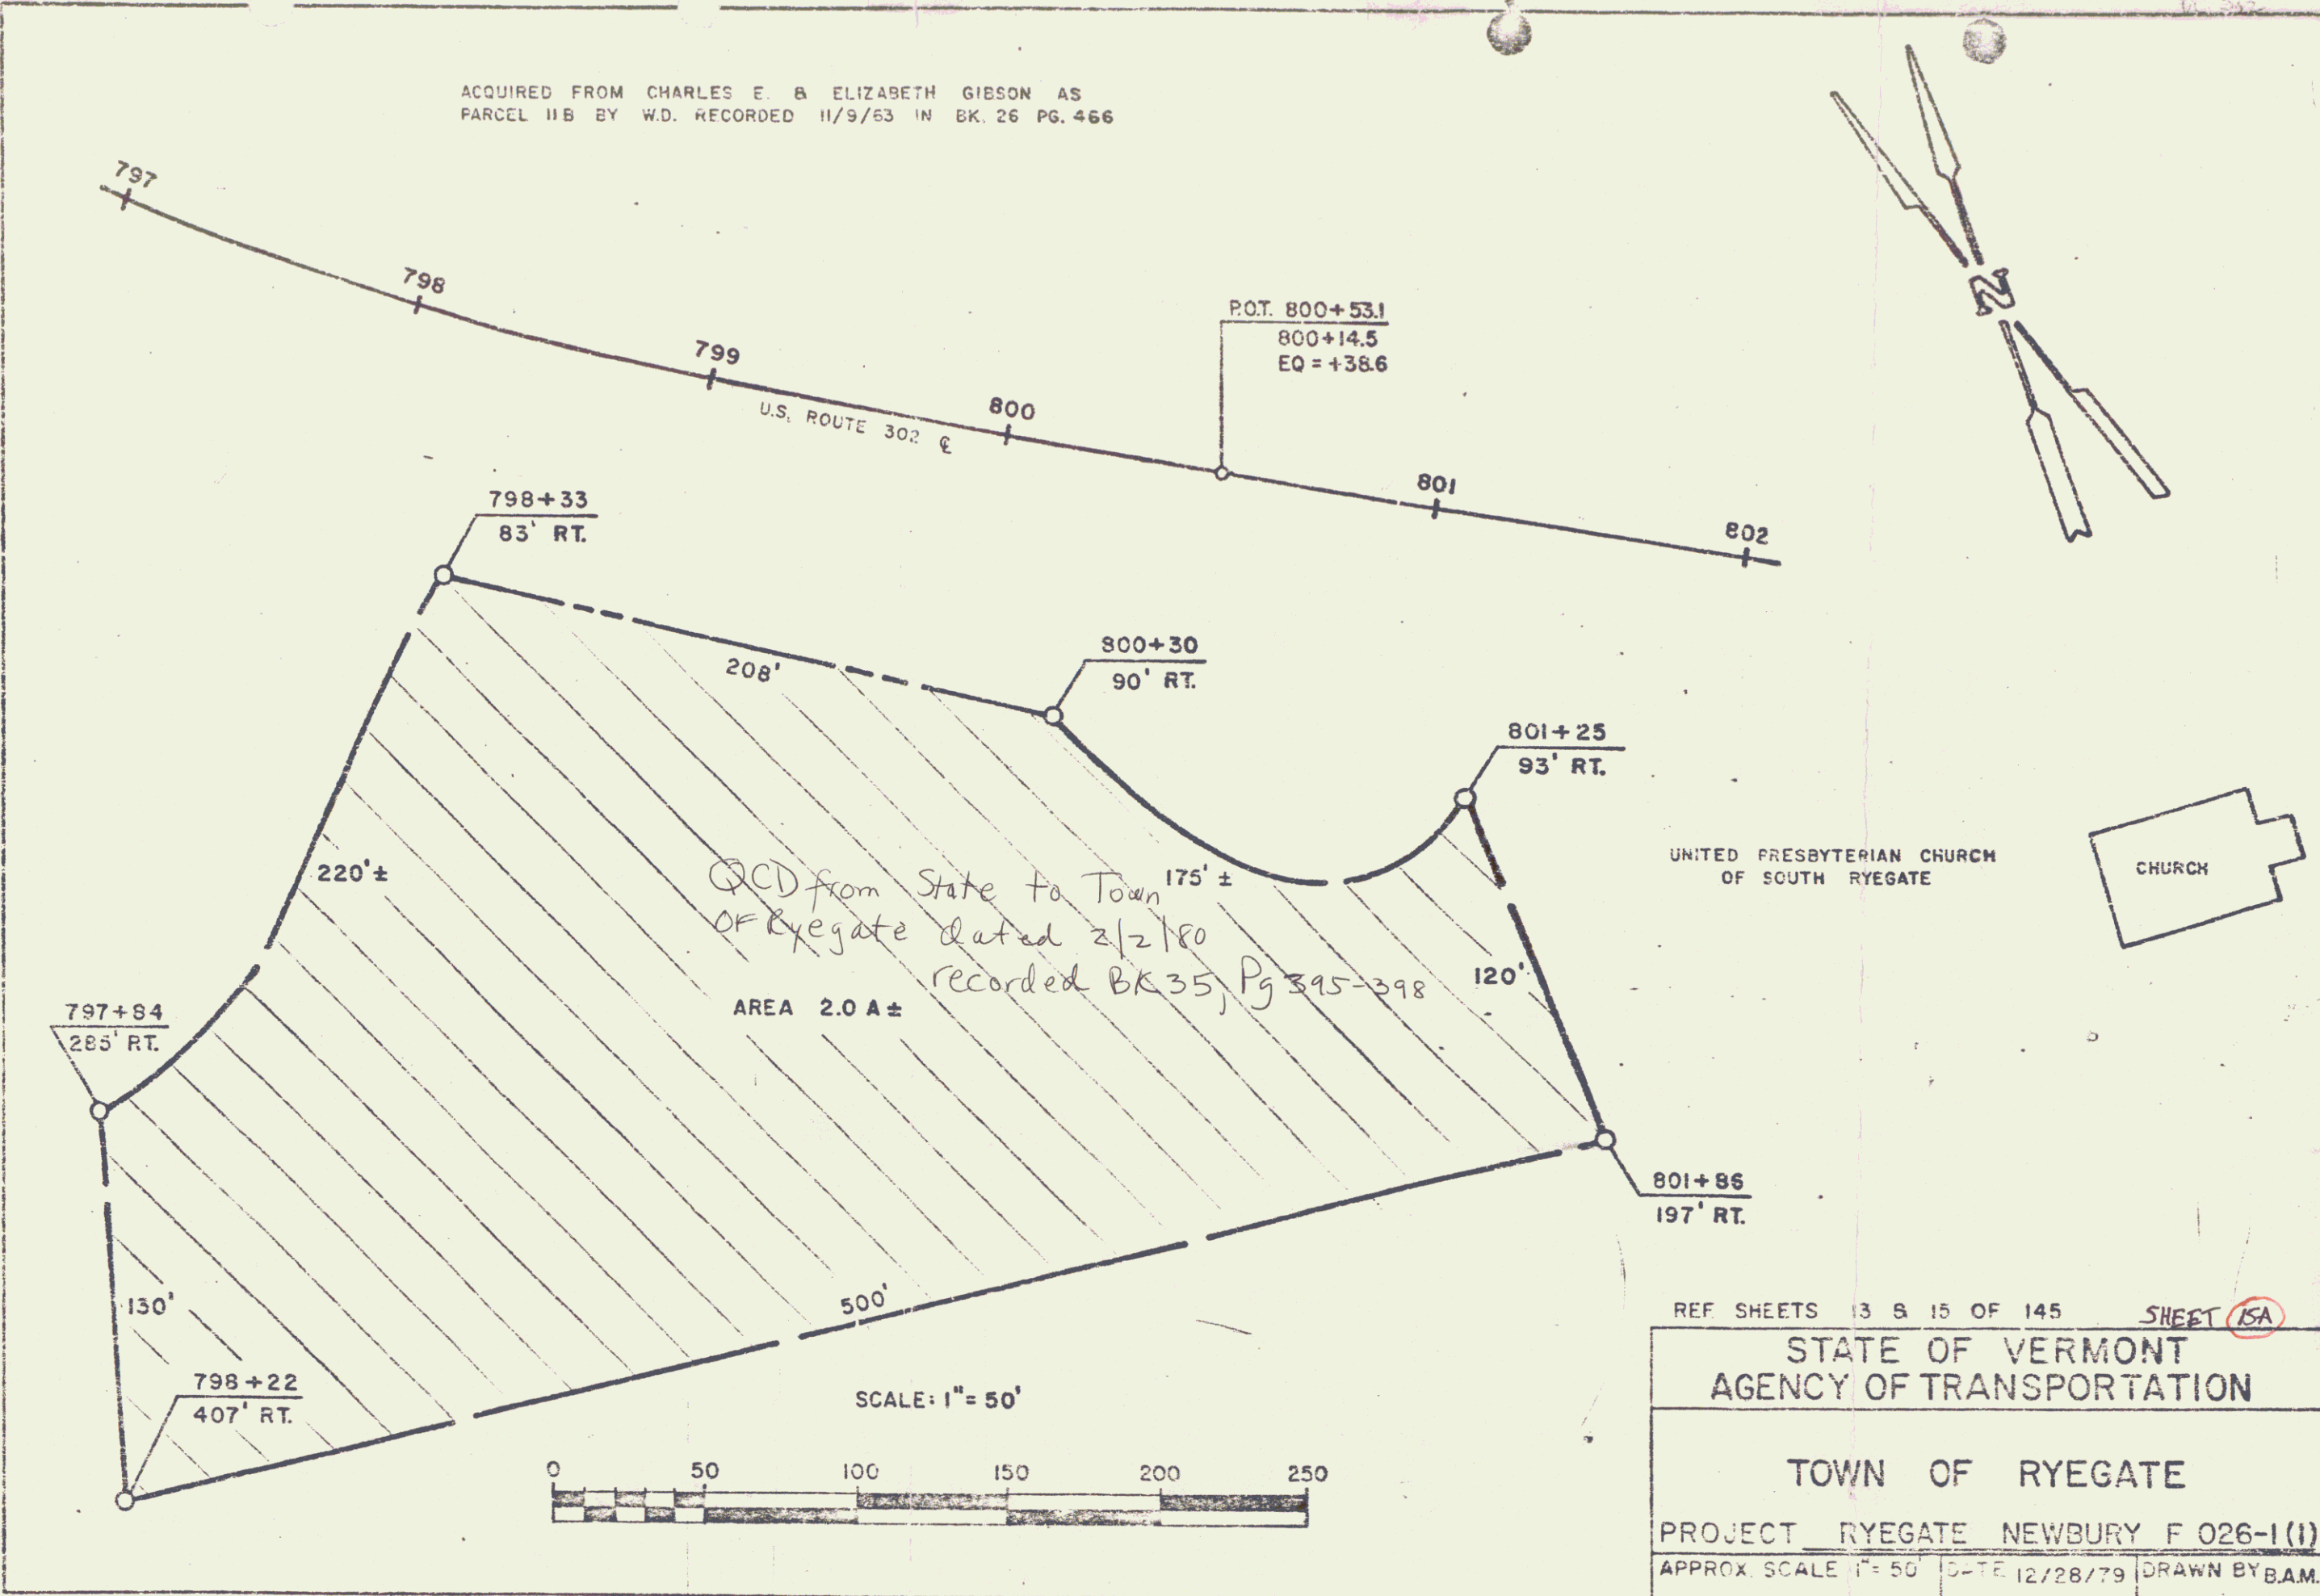

UNITED PRESBYTERIAN CHURCH
OF SOUTH RYEGATE

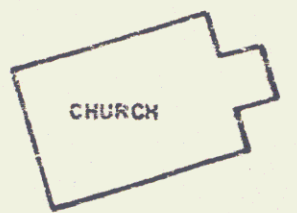

REF SHEETS 13 & 15 OF 145 SHEET 15A
STATE OF VERMONT
AGENCY OF TRANSPORTATION
TOWN OF RYEGATE
PROJECT RYEGATE NEWBURY F 026-1(1)
APPROX. SCALE 1" = 50' DATE 12/28/79 DRAWN BY B.A.M.

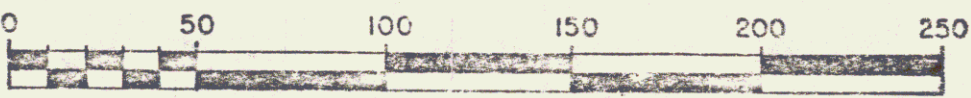

SCALE: 1" = 50'

1316