

TREATED TIMBER CURB
849+50 - 852+00 LT.
850+50 - 858+67 RT.

Drilling & Blasting of
Solid Rock Subgrade
848+00 ~ 849-20

THREE CABLE GUARD-RAIL w/STEEL POSTS
844+00 - 850+00 LT.
850+00 - 858+67 RT.

Steel Guide Posts
860+00 - 861+40

REMOVAL & DISPOSAL OF PRESENT GUARD RAIL
858+73 - 859+11 LT.
862+00 - 864+15 LT.

B.M. #19
S.I.R. 15' Bir.
U.S. Elev. 754.86

B.M. 12-B
S.I.T. 18' Elm
U.S. Elev. 693.99

B.M. #11
S.E. Abut.
U.S. Elev. 697.52

B.M. #1-E
S.I.T. 0' Item
U.S. Elev. 724.84

P.O.T. 848+50


B.M. 13-A
S.I.T. 12' bol.
U.S. Elev. 757.48

PARCEL: 15A
STATIONS: 840+14 RT. - 866+28 RT.
TAKING: 11.3 A±

PARCEL: 15 A,B,C,D,E
GRANTOR: H. DARIUS & PAULINE F. JAMES
STATIONS: 840+14 RT. - 890+30 LT.
TAKING: 14.7 A±
REMAINDER: 150.3 A±
RIGHTS: DRAINAGE - STA 849+63 ± LT.
STA 851+00 ± LT.
STA 854+30 ± RT.
STA 858+69 ± RT.

TITLE TAKEN: COND. 12/5/61
RECORDED: RYEGATE BK. 26 PG. 274-283 12/9/61

REVISED DATA
A 93°17'30" Rt.
D 5'45'
R 996.9
T 1055.4
L 1622.5
E 155.0
Bank 1" per ft.

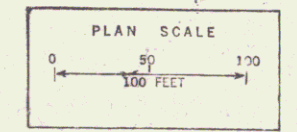

RYEGATE-NEWBURY
PROJ. F-026-1(1)
Sheet 19 of 145 Sheets