
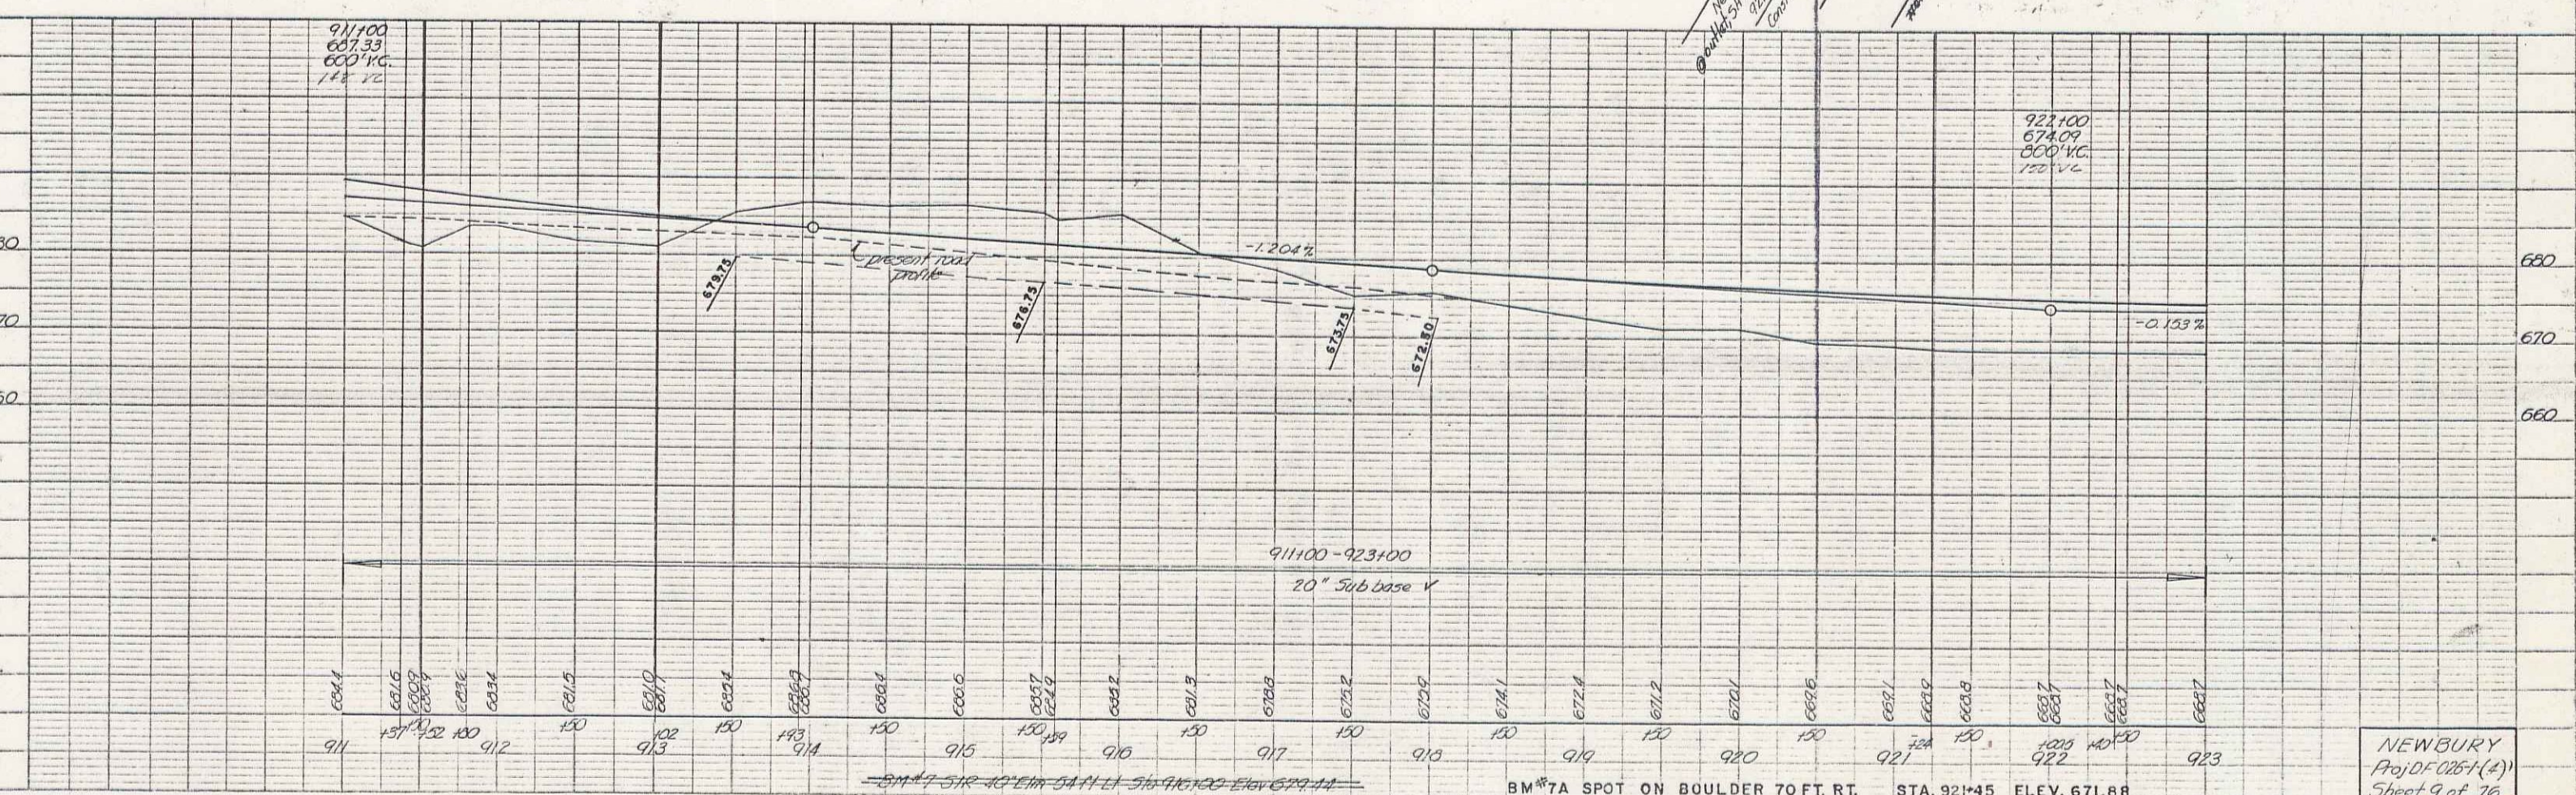


SHEET NO. 9
 DATE: 11/23/58
 DRAWN BY: G. S. DUNN
 CHECKED BY: G. S. DUNN
 PROJECT: NEWBURY
 SHEET: 9 OF 16

SHEET NO. 9
 DATE: 11/23/58
 DRAWN BY: G. S. DUNN
 CHECKED BY: G. S. DUNN
 PROJECT: NEWBURY
 SHEET: 9 OF 16

EXCAV OF DISCONTINUED ROADWAY
 SURFACE
 912+00 LI - 917+00 LI V

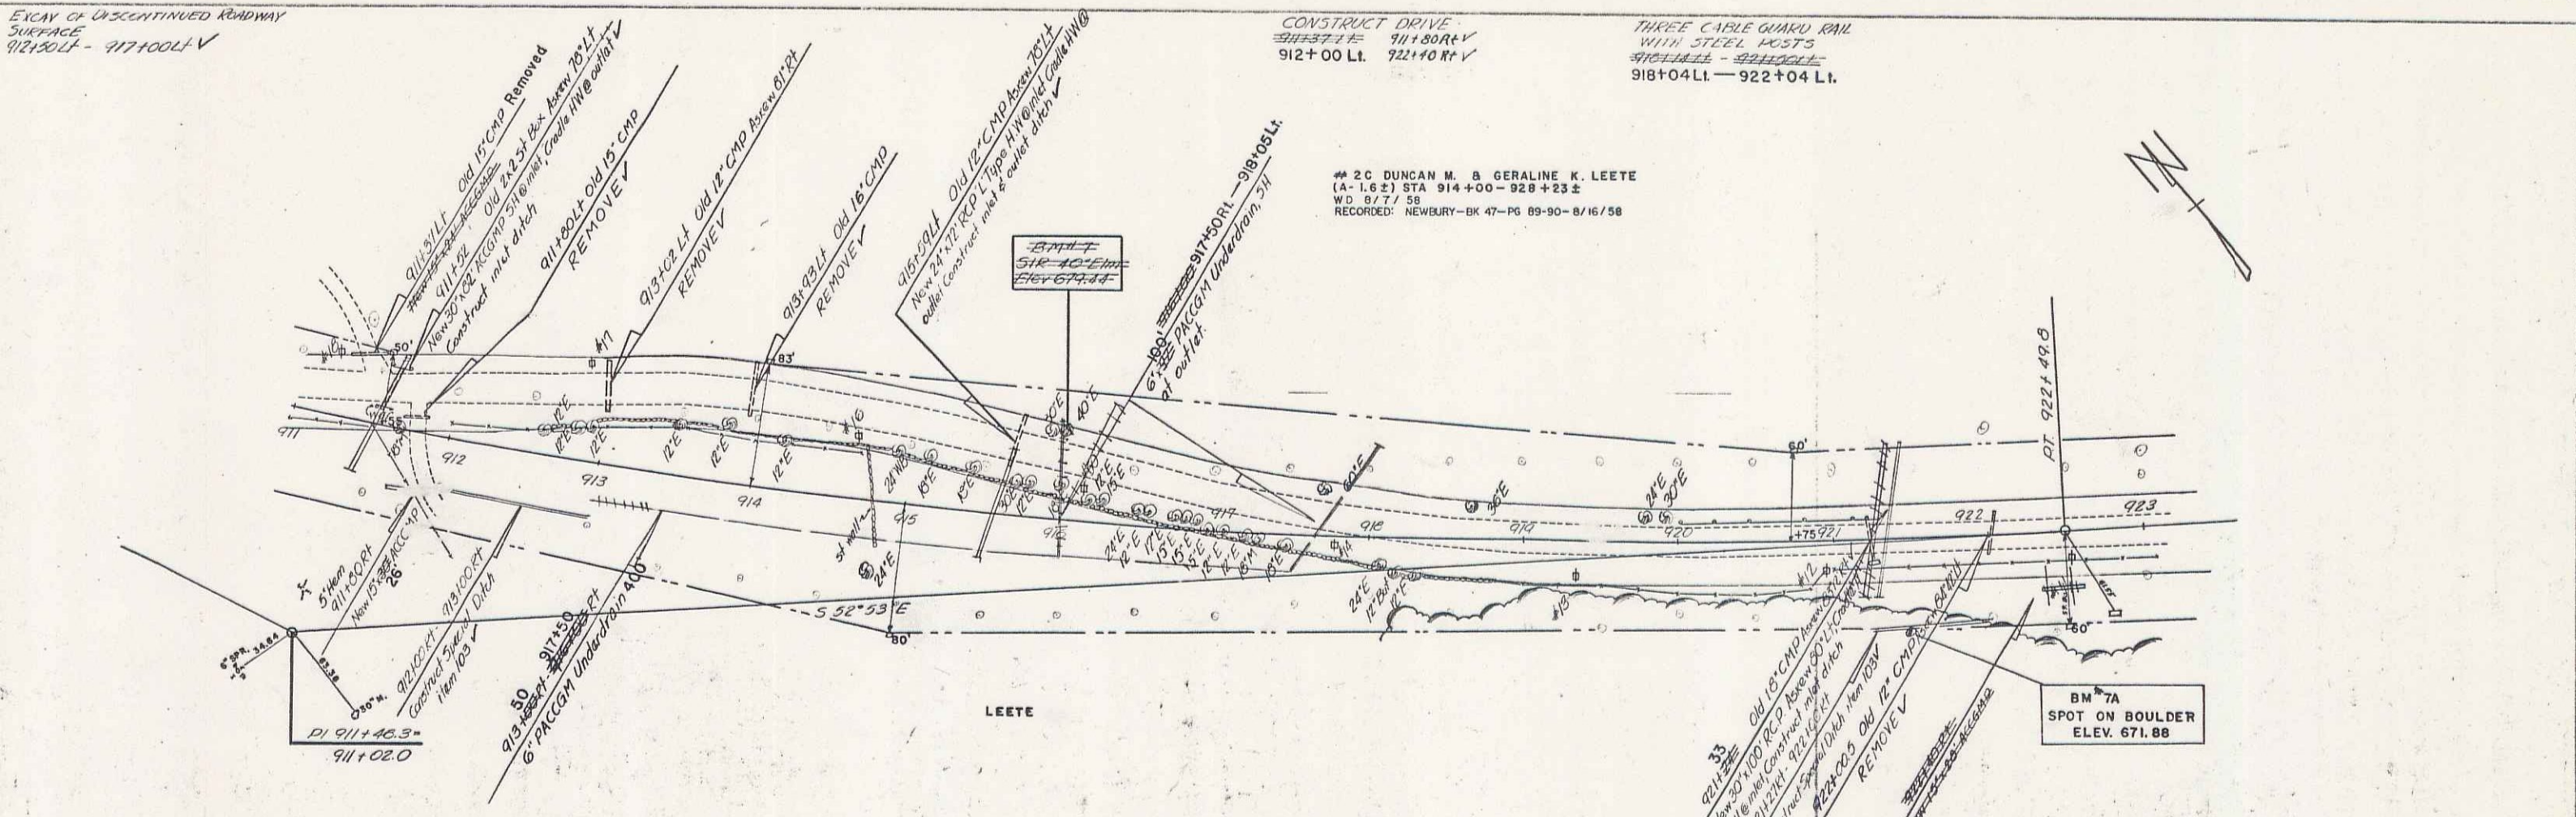

NEWBURY
 Proj. 0251(2)
 Sheet 9 of 16

Printed in U.S.A.
 Co. 28570001 Drawing Co.

PLATE 1 PLAN PROFILE & P. IN STANDARD
 ENGINEERING CO. DRAWING

Printed in U.S.A.
 Co. 28570001 Drawing Co.