
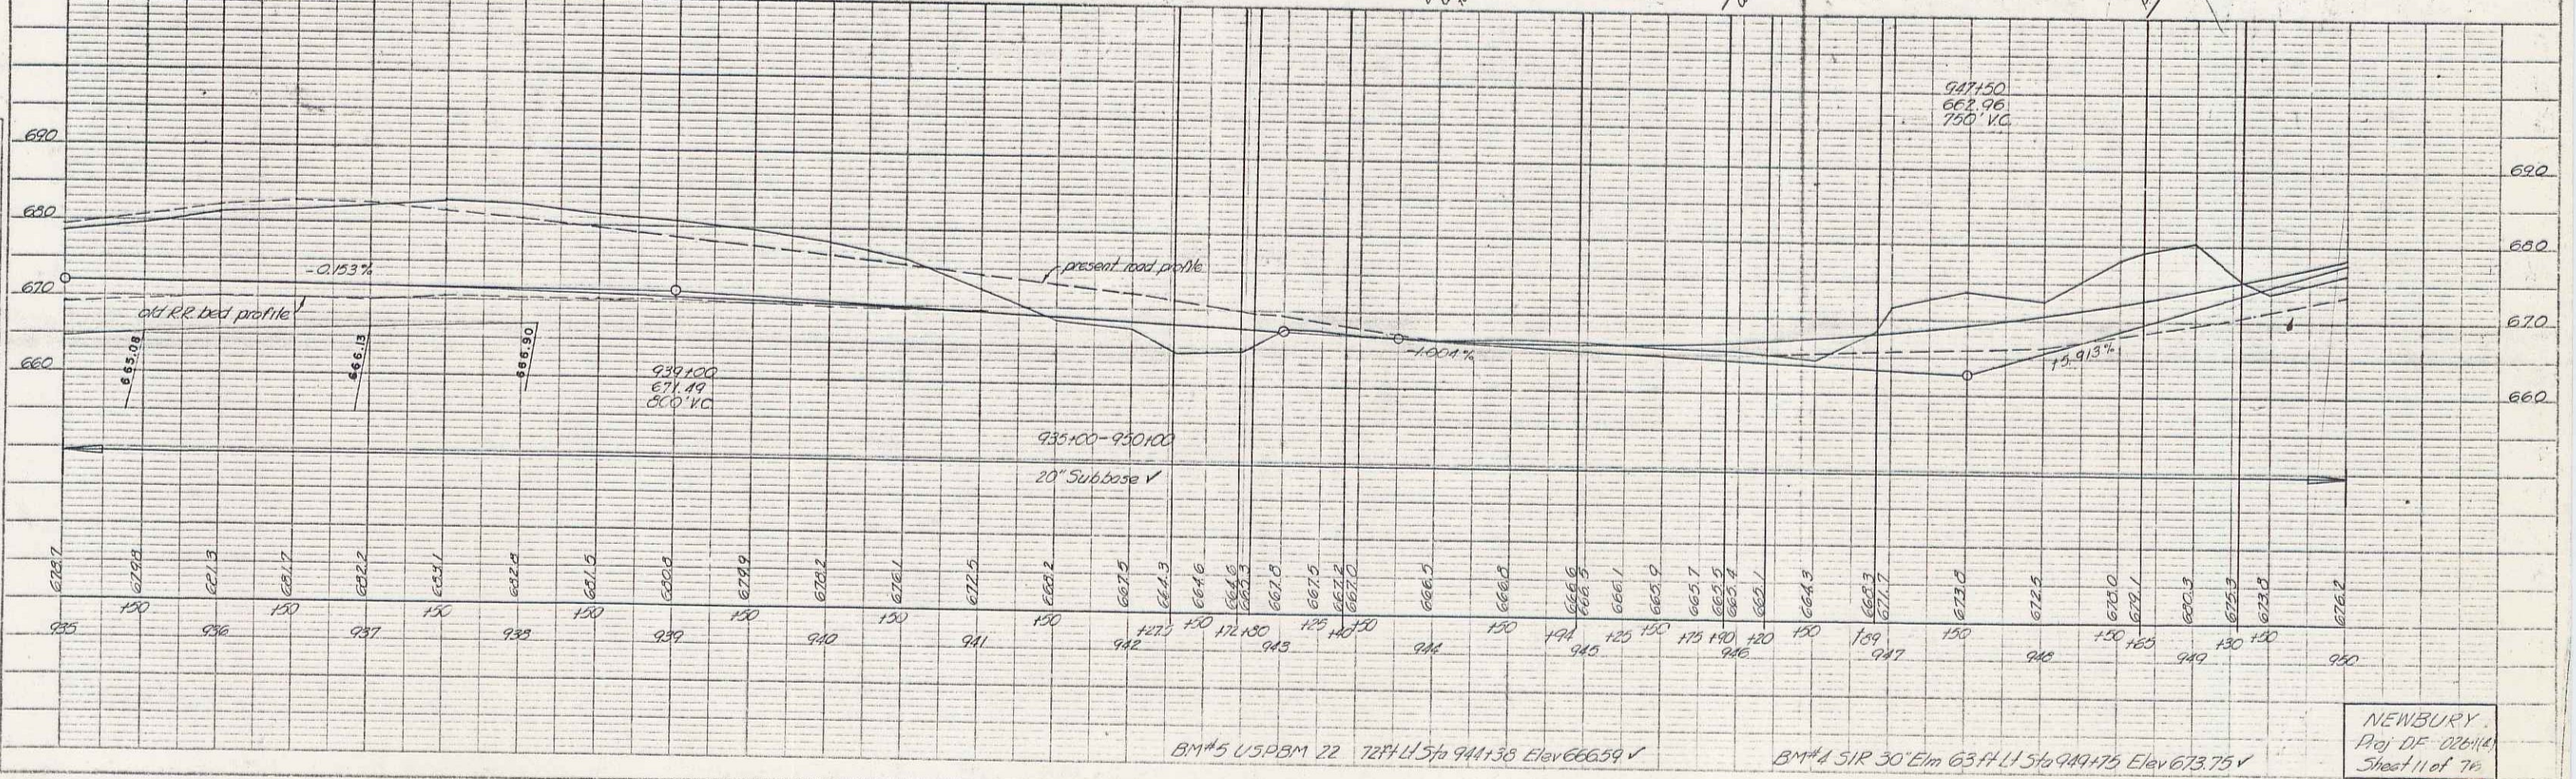


PLAN
 DRAWING NO. 100
 DATE 10/25/58
 PROJECT NEWBURY
 SHEET 11 OF 11
 DRAWN BY G. J. DUNN
 CHECKED BY J. W. BROWN
 TITLE CONSTRUCTION

PROFILE
 DRAWING NO. 100
 DATE 10/25/58
 PROJECT NEWBURY
 SHEET 11 OF 11
 DRAWN BY G. J. DUNN
 CHECKED BY J. W. BROWN
 TITLE CONSTRUCTION

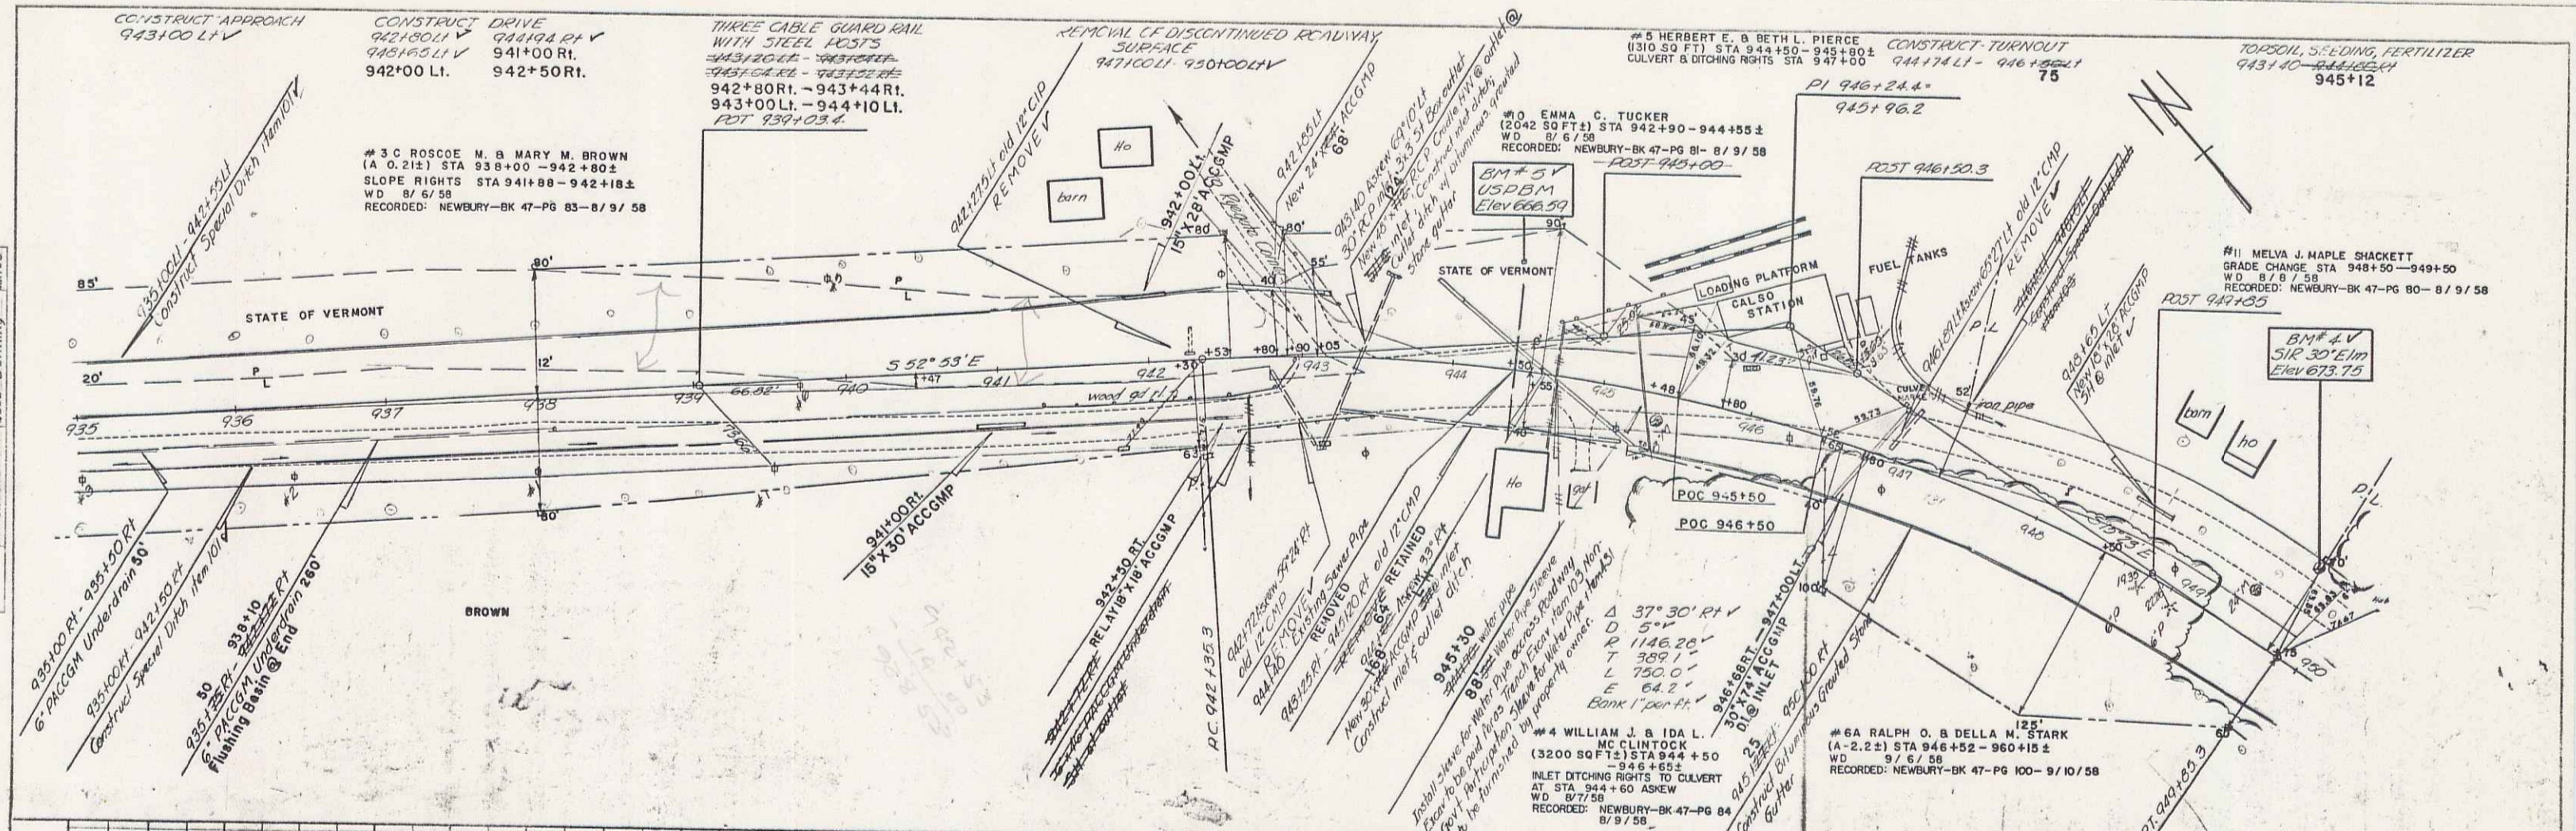

BM#5 USPB 22 72 FT LI 5th 944+35 Elev 666.59 ✓
 BM#4 SIR 30 Elm 63 FT LI 5th 944+75 Elev 673.75 ✓
 NEWBURY
 Proj DF-020114
 Sheet 11 of 11

PLAIN PROFILES & STANDARDS
 1958 EDITION (REVISED 1964)