


PLAN
 DATE: 11/23/58
 DRAWN BY: G. S. Dunning
 CHECKED BY: G. S. Dunning
 PROJECT: 11/23/58

PROFILE
 DATE: 11/23/58
 DRAWN BY: G. S. Dunning
 CHECKED BY: G. S. Dunning
 PROJECT: 11/23/58

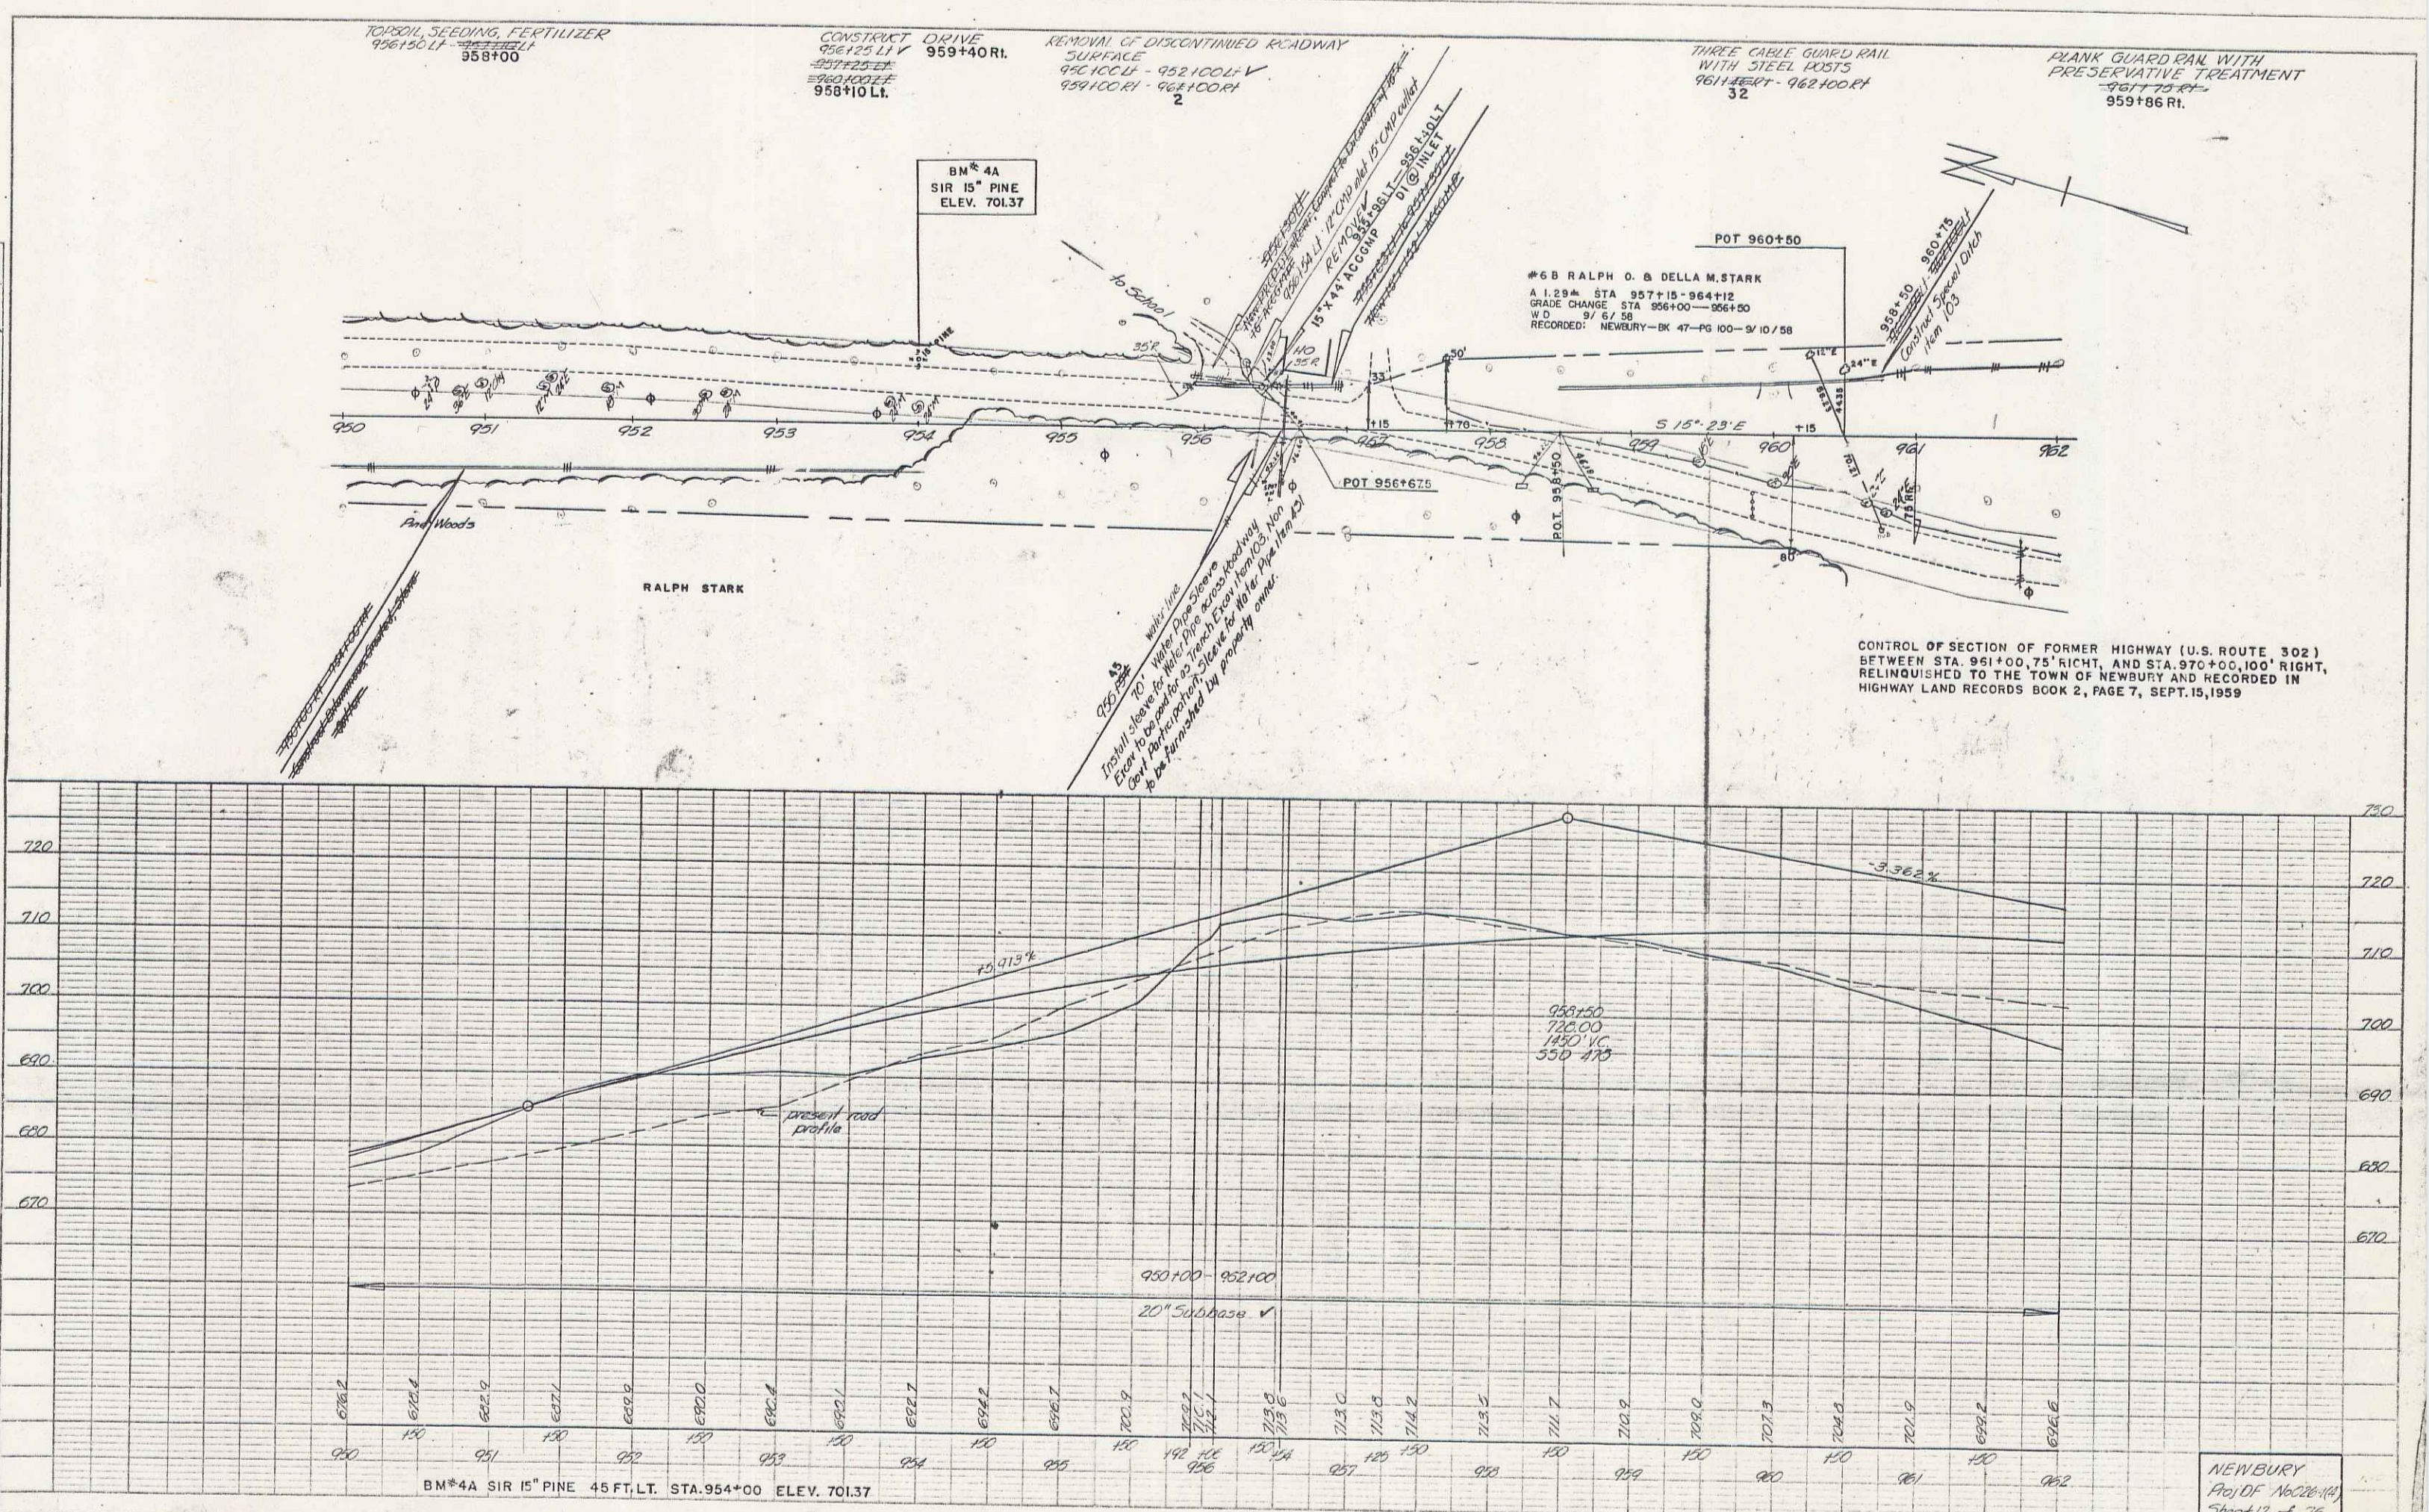

NEWBURY
 Proj. No. 228-148
 Sheet 12 of 76

Printed in U.S.A.
 OR ART WEIGHT Trading Co.

PLATE 1 PLAN, PROFILE & P. & M. RECORDS
 SCALE: PLAN - 1" = 40' PROFILE - 1" = 10'