


PLAN
 DRAWN BY: [Signature]
 CHECKED BY: [Signature]
 DATE: 10/25/20

PROFILE
 DRAWN BY: [Signature]
 CHECKED BY: [Signature]
 DATE: 10/25/20

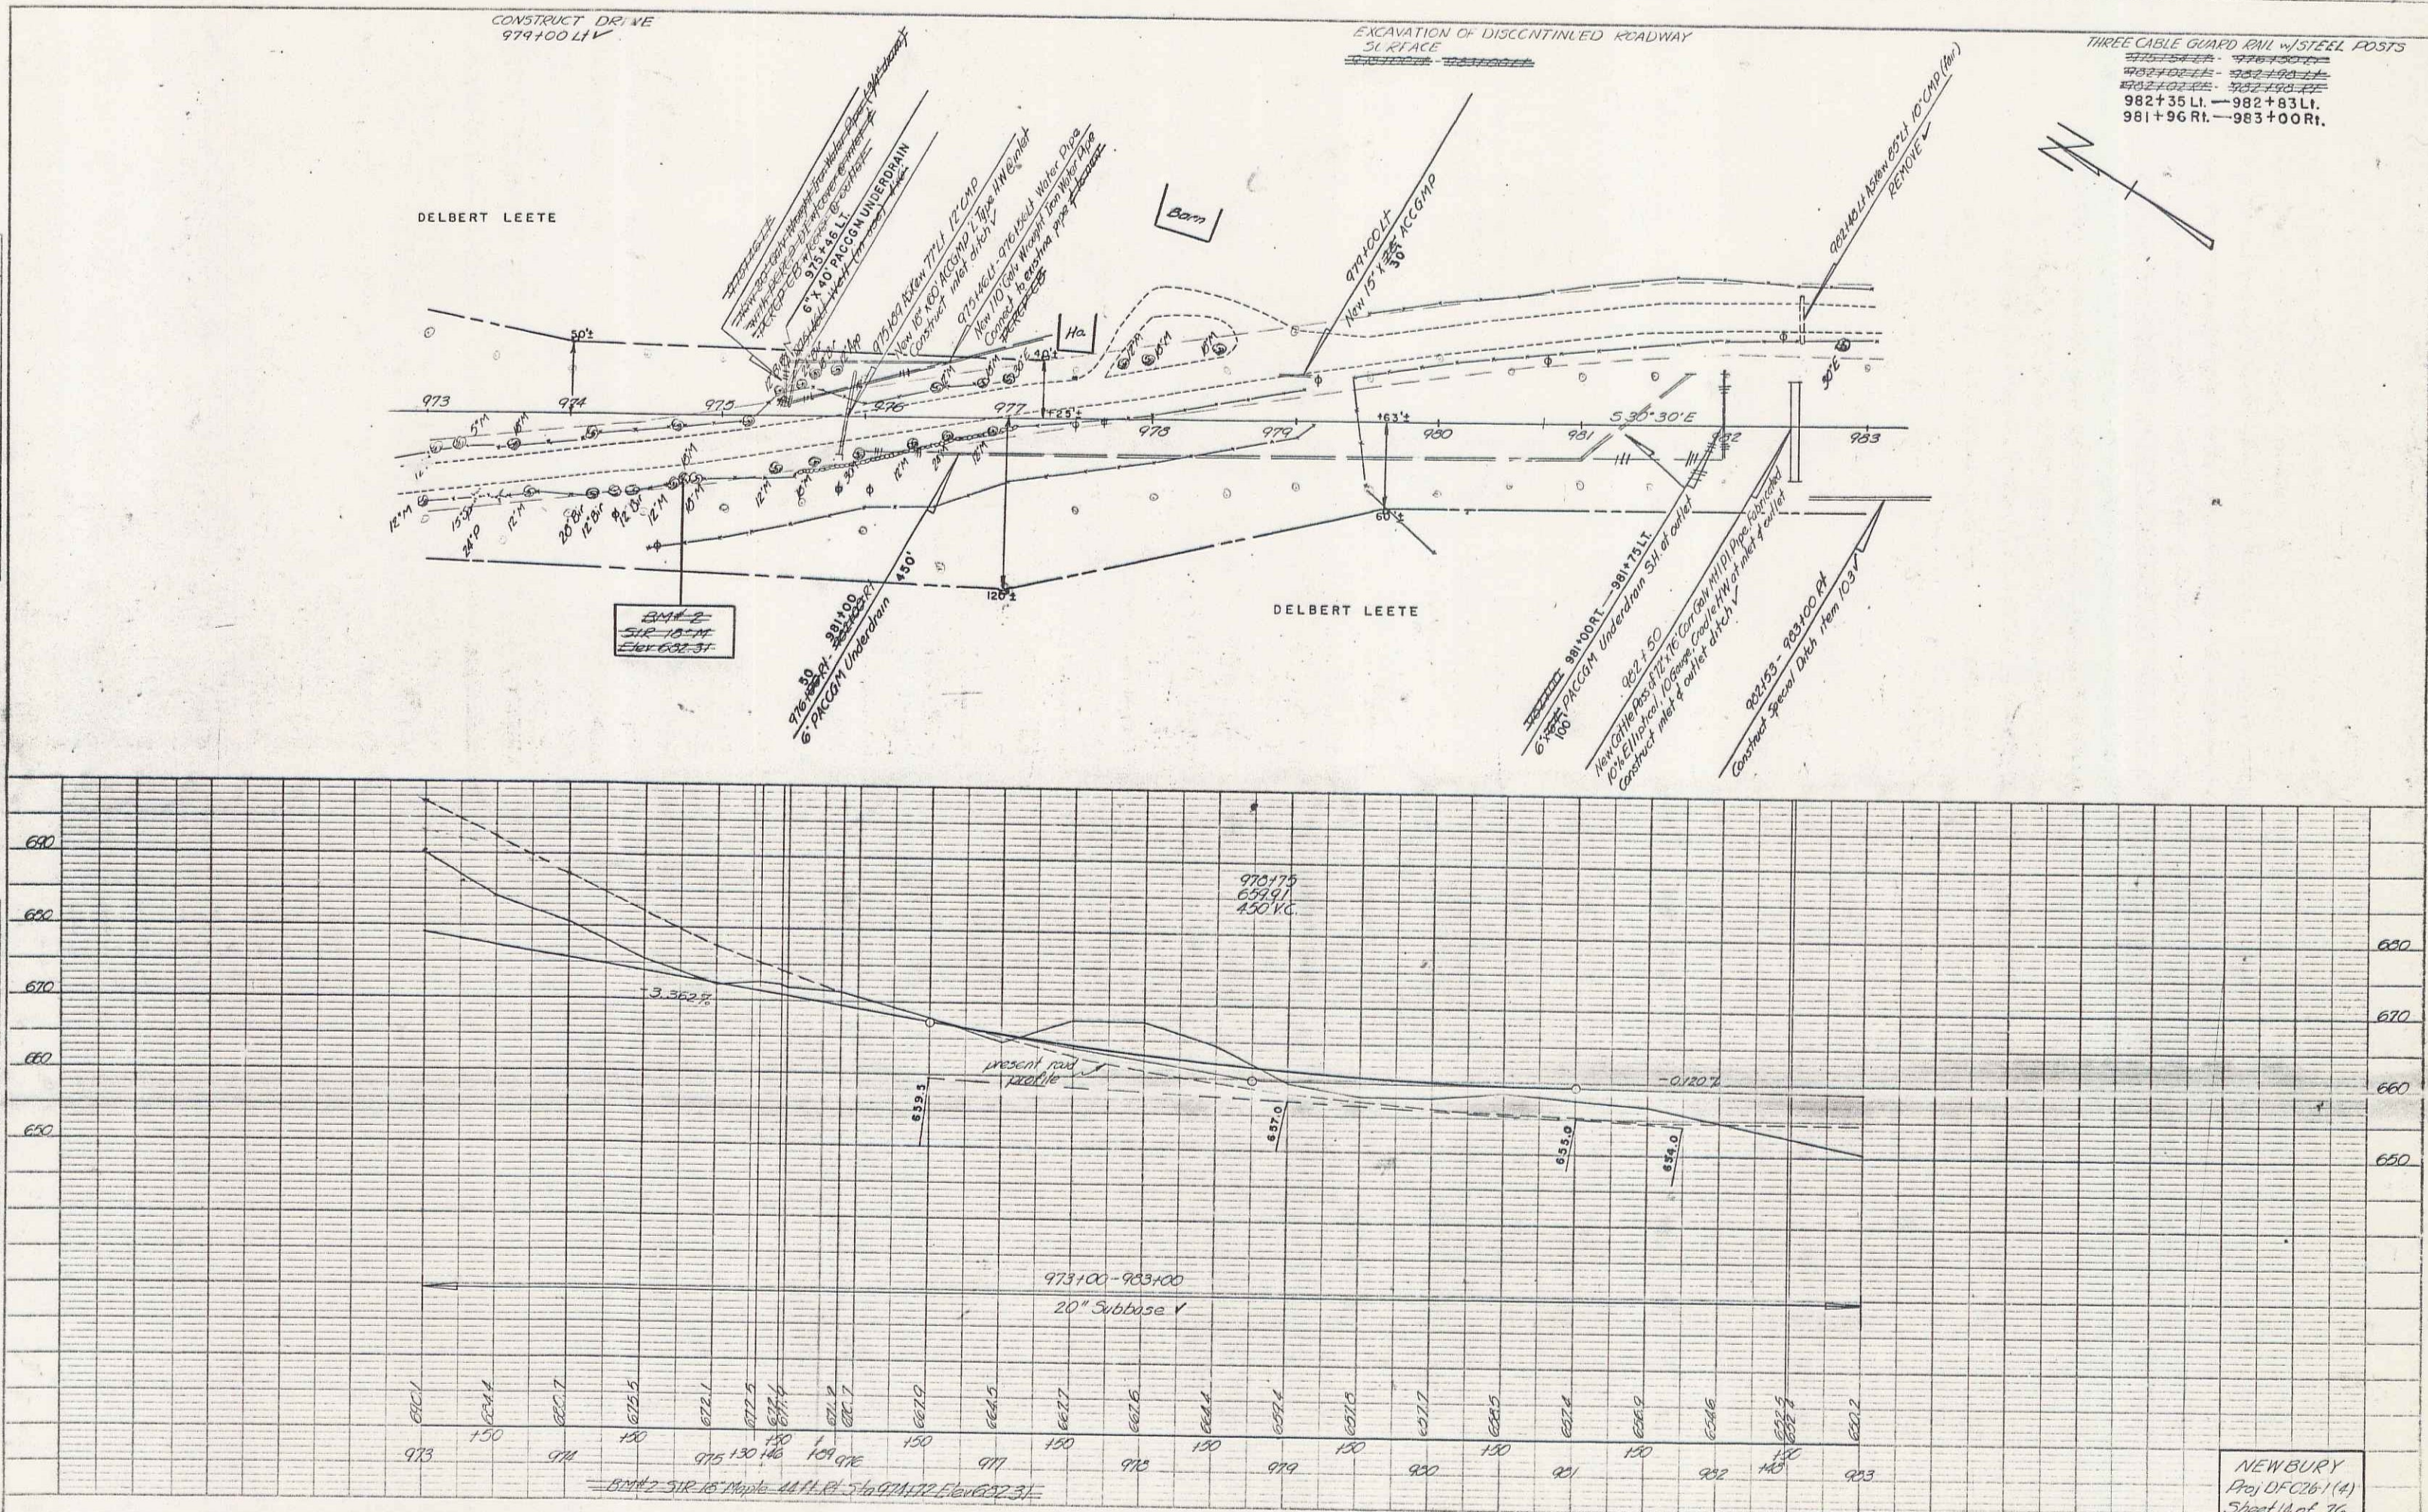

PAPER NO. 214
 DRAWING NO. 100

PLATE 1 PLAN PROFILE 20" SUBWAY
 DATE: 10/25/20

NEWBURY
 Proj DFC26-1 (4)
 Sheet 14 of 16