
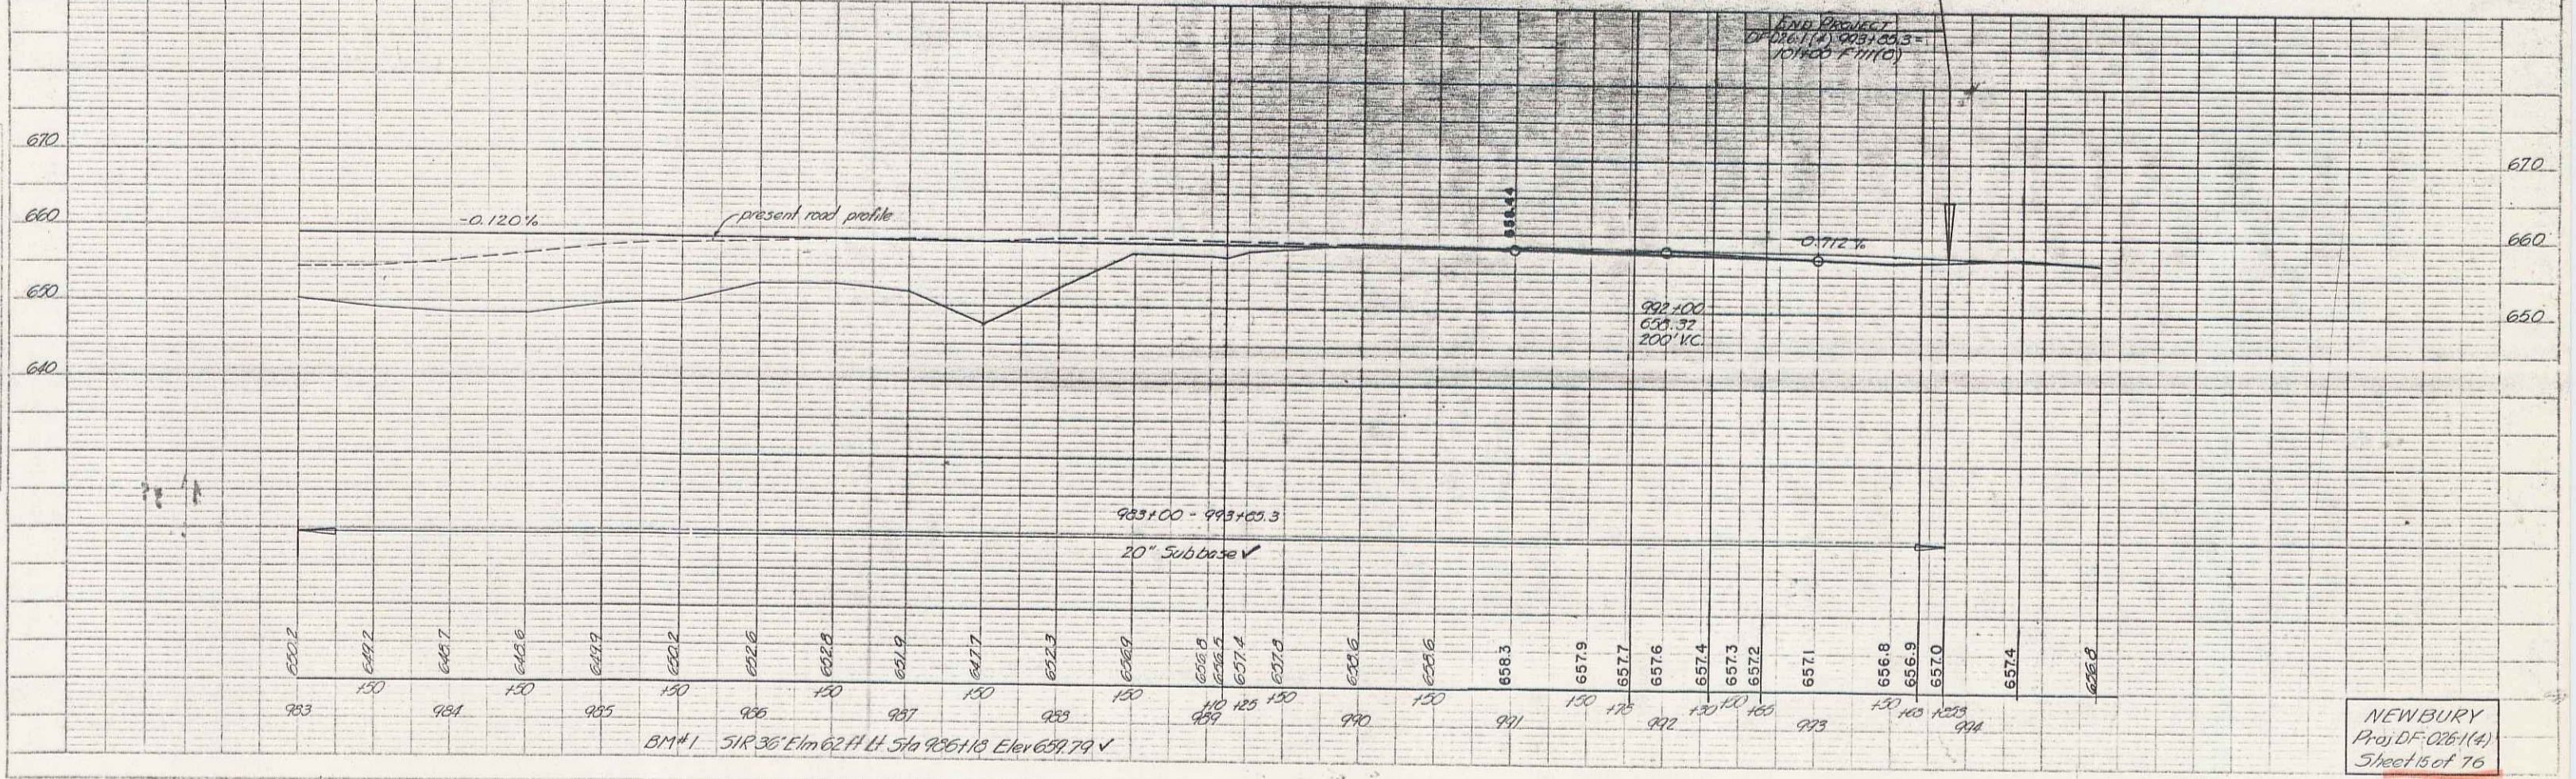


Checked by: [Signature]  
 Date: [Date]  
 Drawn by: [Signature]  
 Date: [Date]

Checked by: [Signature]  
 Date: [Date]  
 Drawn by: [Signature]  
 Date: [Date]

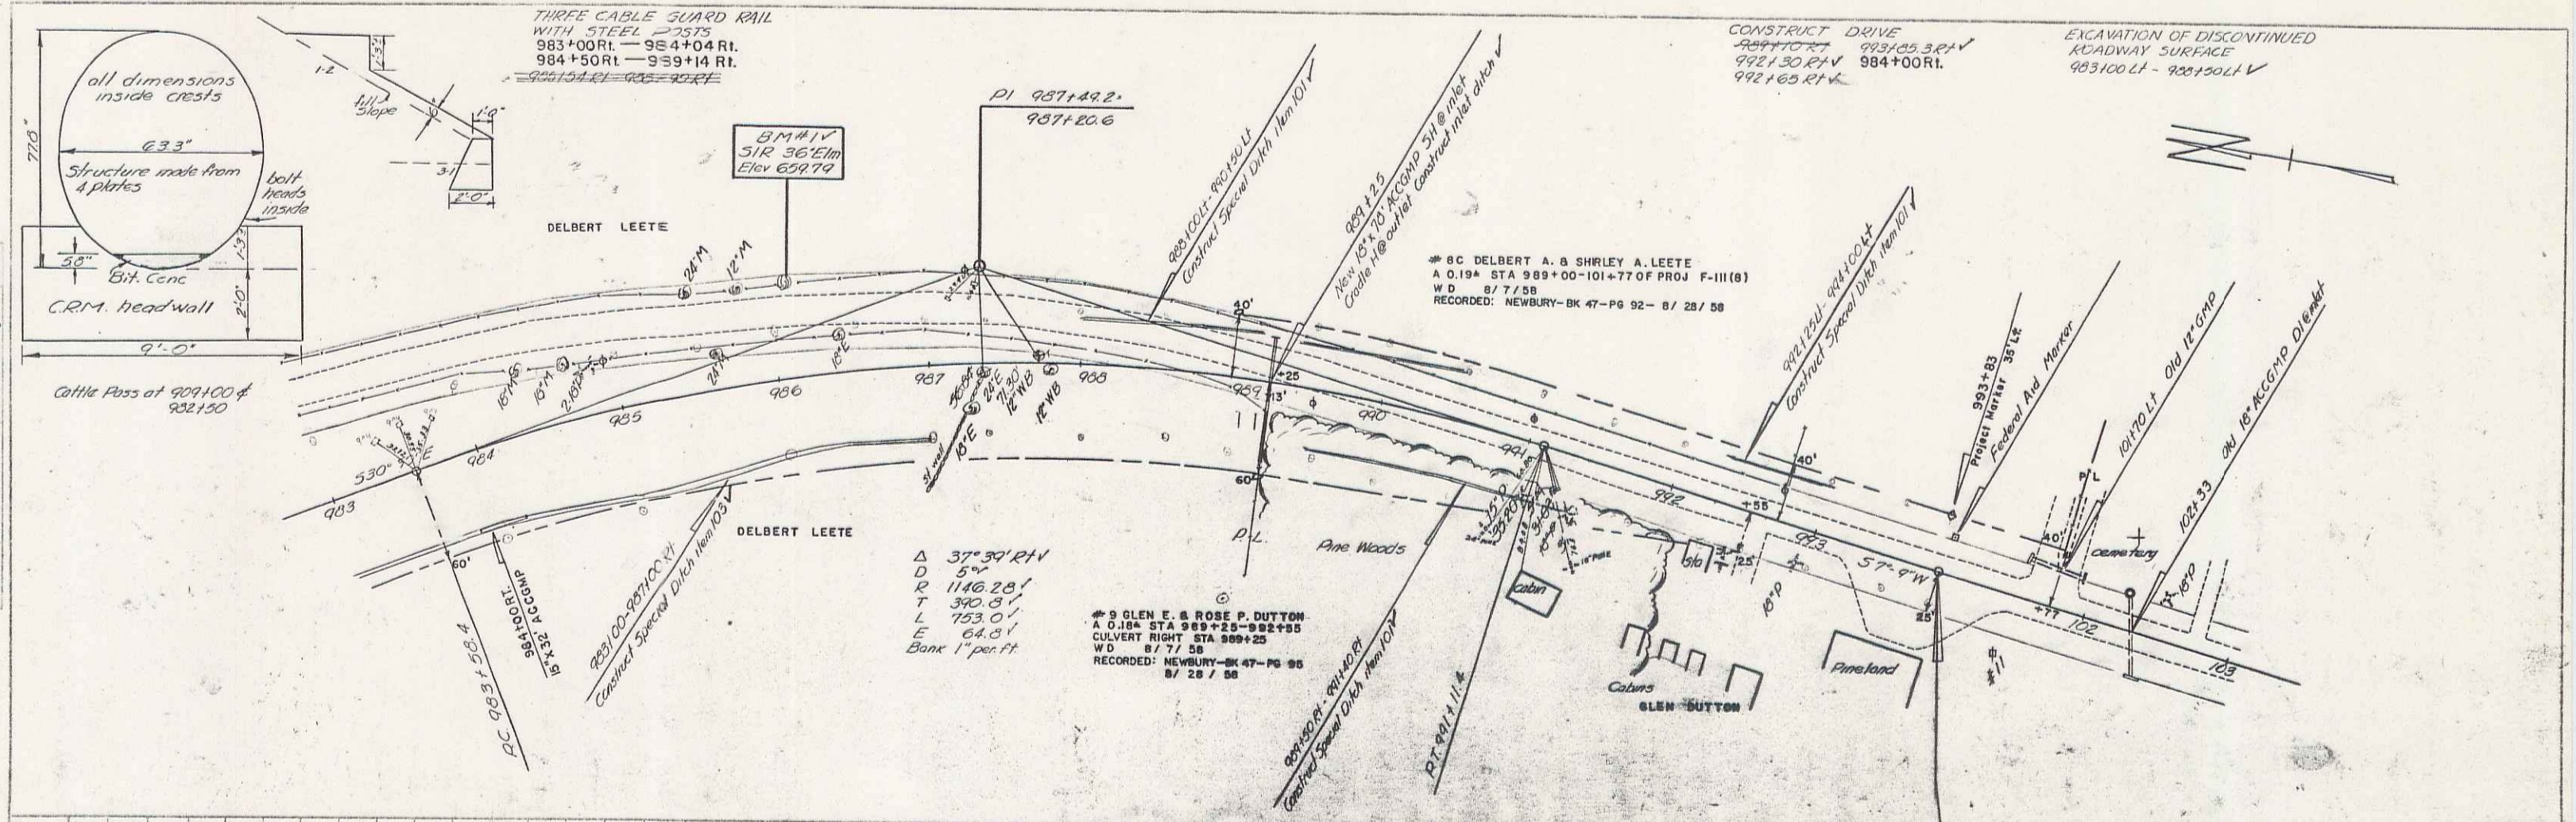

NEWBURY  
 Proj. DF-026-1(4)  
 Sheet 15 of 76