
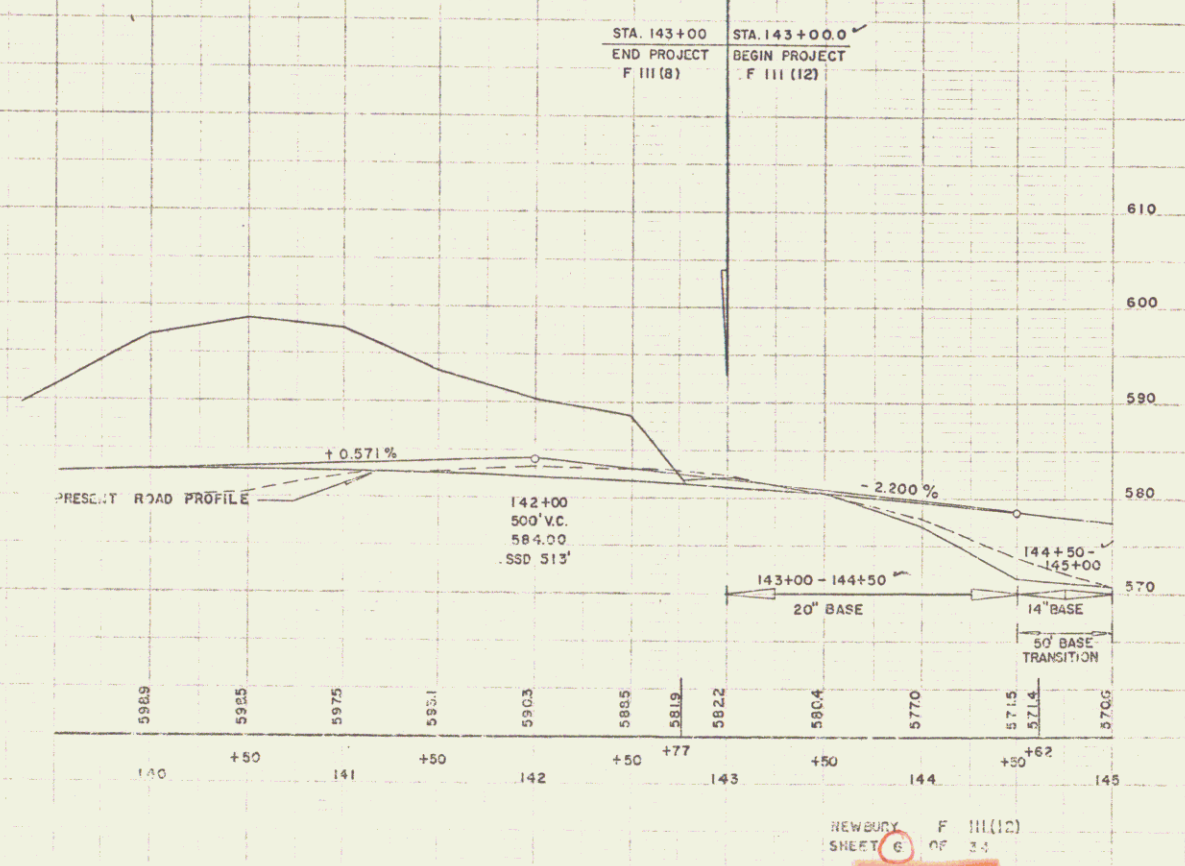


PLAN  
 SHEET 12-55  
 OF 5-56  
 BRILLIANT  
 WESTER-MARTIN, INC.  
 12-55  
 OF 5-56  
 BRILLIANT  
 WESTER-MARTIN, INC.

BRILLIANT  
 WESTER-MARTIN, INC.  
 12-55  
 OF 5-56  
 BRILLIANT  
 WESTER-MARTIN, INC.

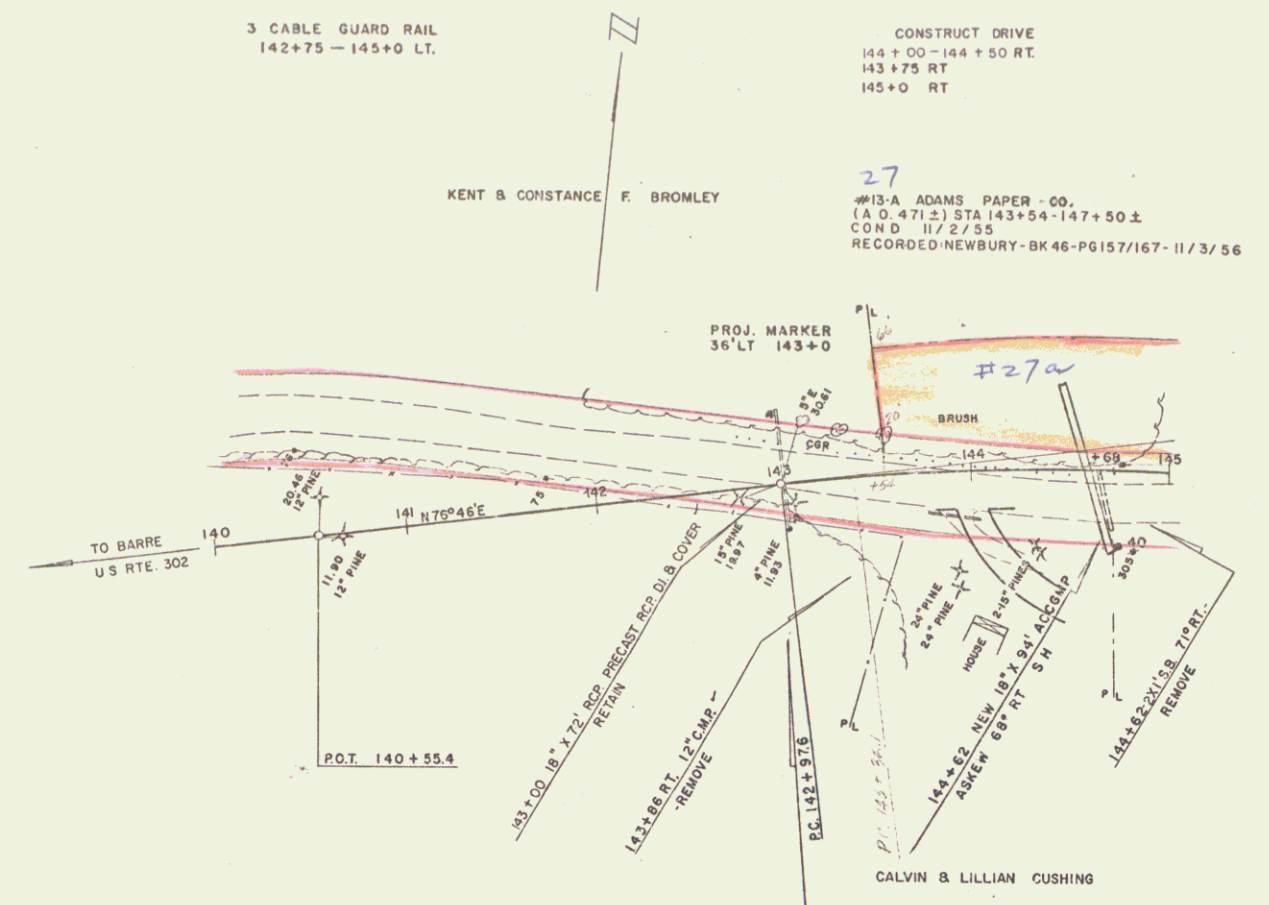

REWBURY F III (12)  
 SHEET 6 OF 3  
 10