
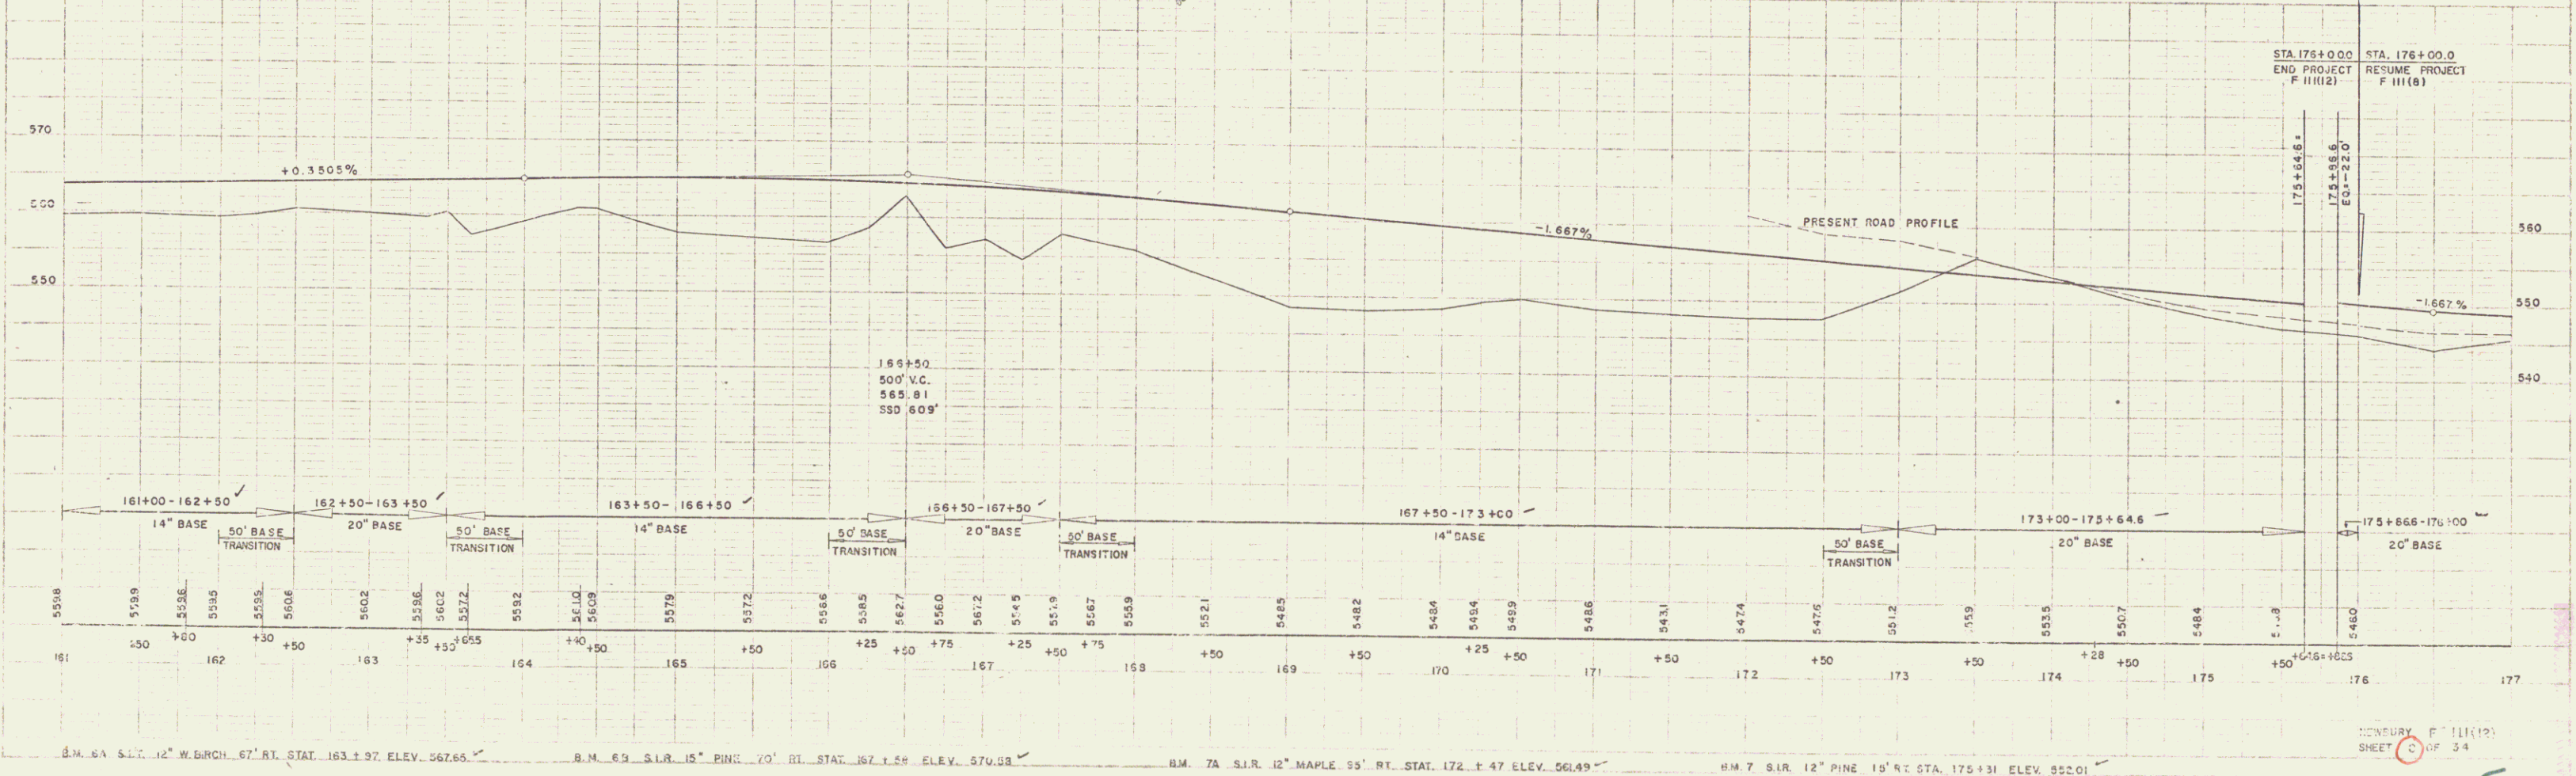


12-55
 5-74
 SPENCER
 WENSTER-MARTIN, INC.

12-55
 5-58
 SPENCER
 WENSTER-MARTIN, INC.

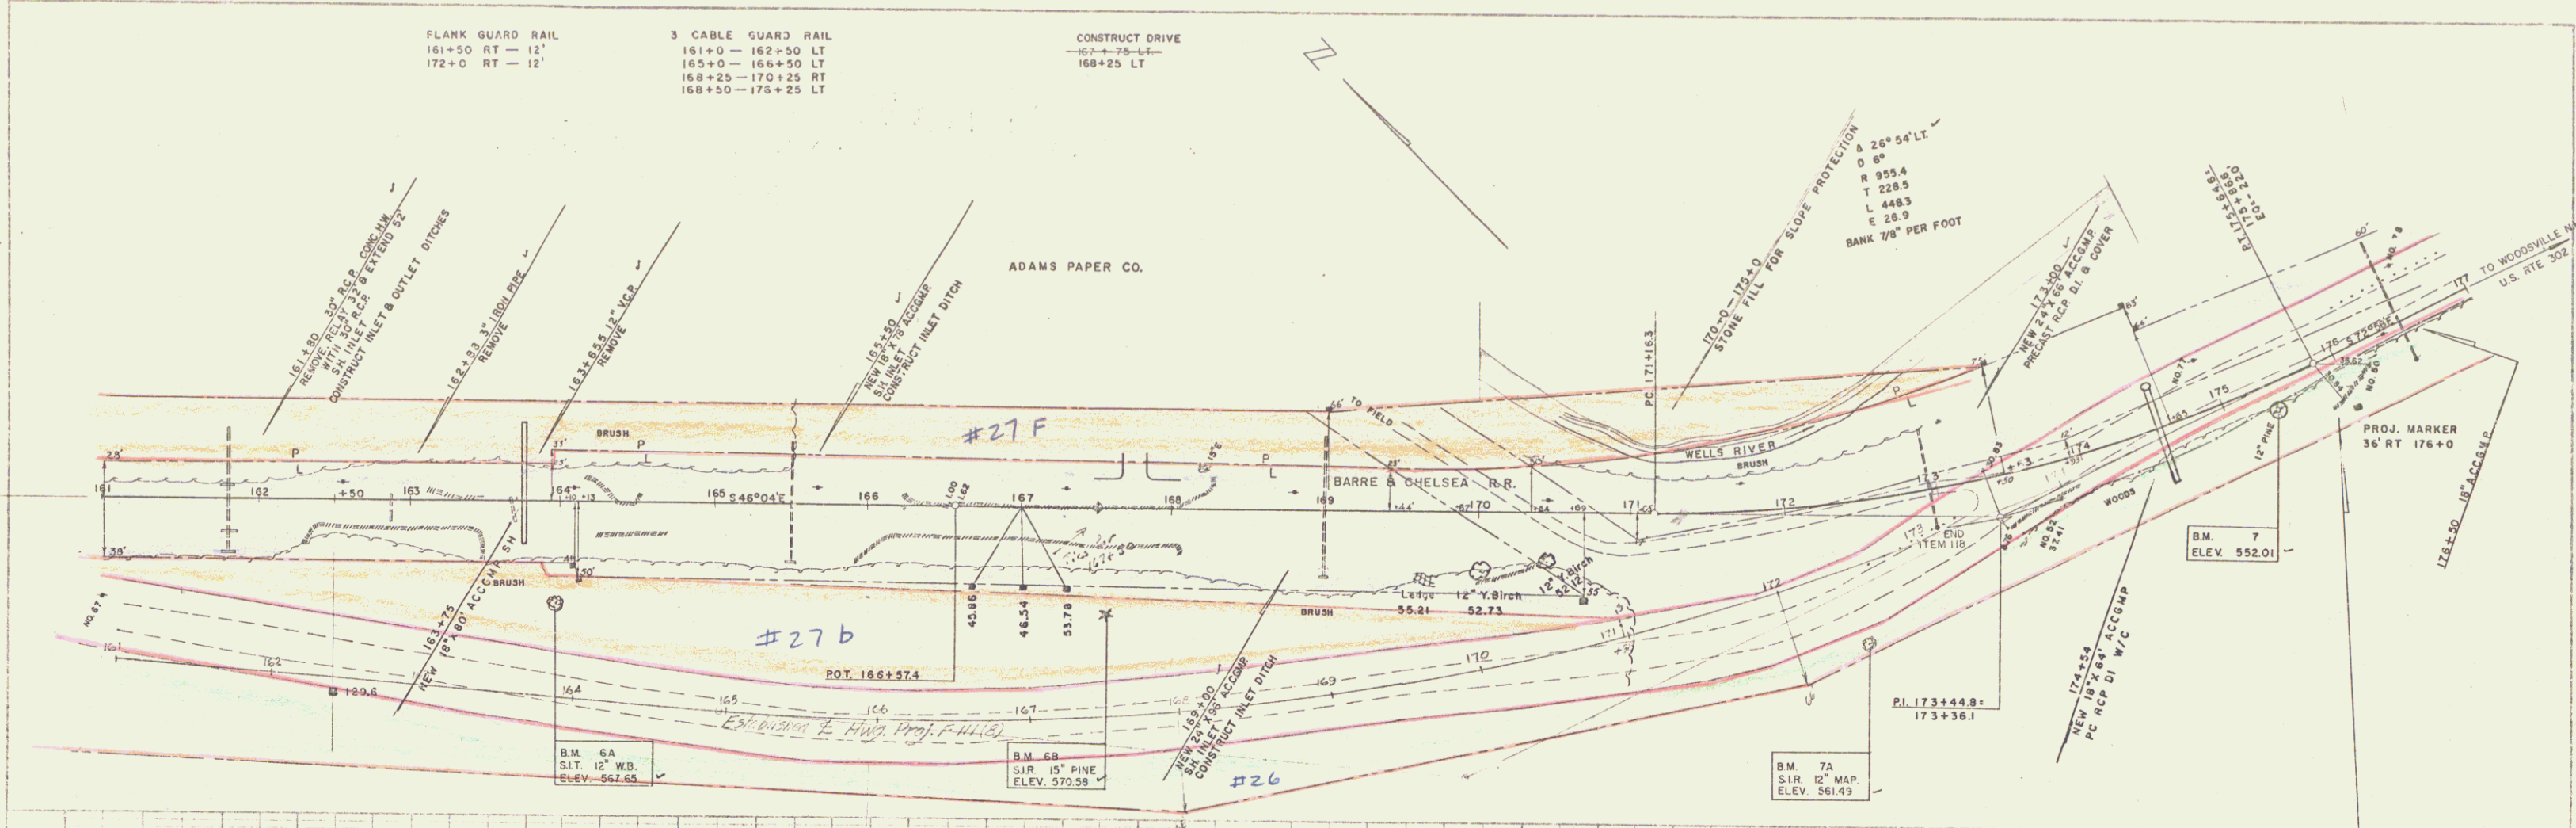

B.M. 64 S.L.T. 12" W.B. BRCH. 67' RT. STAT. 163+97 ELEV. 567.65
 B.M. 69 S.L.R. 15" PINK 70' RT. STAT. 167+59 ELEV. 570.58
 B.M. 7A S.L.R. 12" MAPLE 55' RT. STAT. 172+47 ELEV. 561.49
 B.M. 7 S.L.R. 12" PINE 15' RT. STA. 175+31 ELEV. 552.01

HOWERY F 11(19)
 SHEET C OF 34

15