

CONSTRUCT DRIVES

STA.	
178+92	RT.
183+25	RT.
184+00	RT.

DRIVES CONSTRUCTED

LT.	RT.
183+25	178+85
	184+00
	192+00

3 CABLE GUARD RAIL
191+03 - 191+80 RT
177+00 - 193+00 LT

NOTE
STA. 191+27 LT.
BEGIN STONE FILL FOR SLOPE PROTECTION
ITEM 522

REV. CURVE


A	43°10' RT
D	6°
R	955.4
T	377.9
L	719.4
E	72.0
BANK	7/8" PER FT.

REV. CURVE

A	43°10' RT
D	6°
R	955.4
T	377.9
L	719.4
E	72.0
BANK	7/8" PER FT.

REV. CURVE

A	43°10' RT
D	6°
R	955.4
T	377.9
L	719.4
E	72.0
BANK	7/8" PER FT.

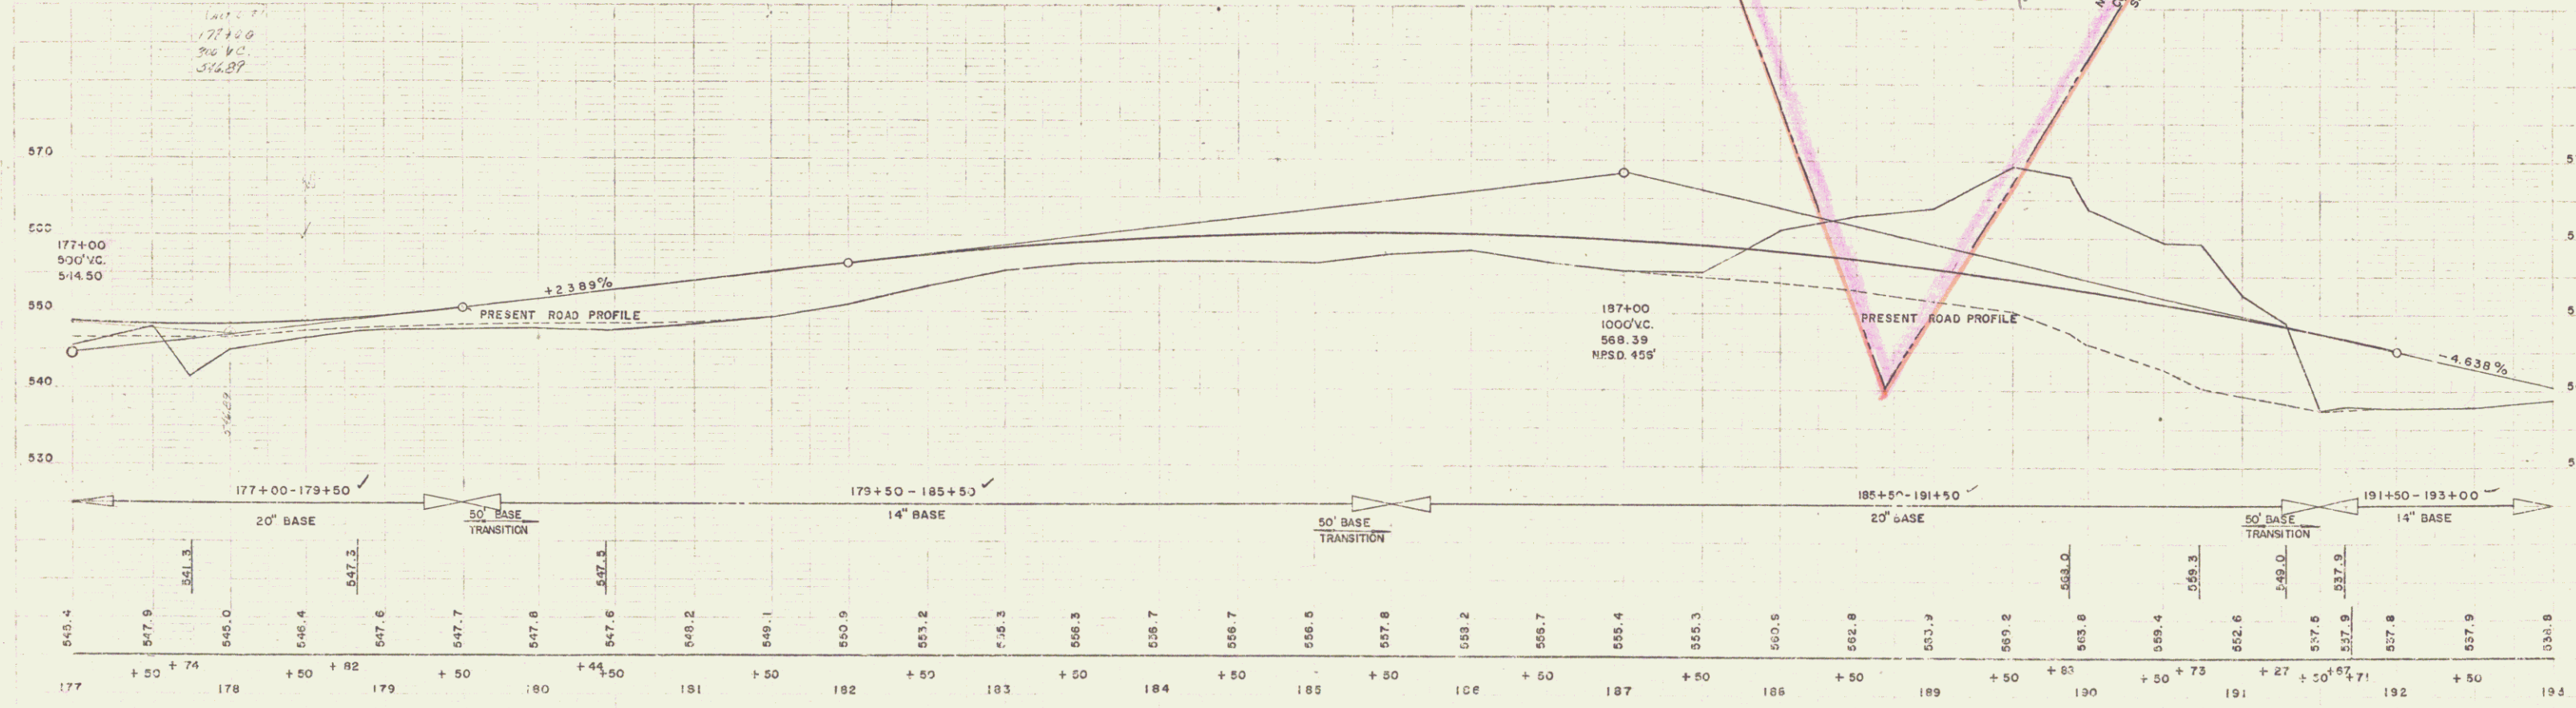

NEWBURY F 111 (C)
SHEET 14 OF 79

B.M. # S.I.R. 24" PINE 23' LT. 167+80 ELEV. 556.07