


INDEX OF SHEETS

1	Title Page	
2	Quantity Sheets	
3	Project Plan Sheet	
4	Plan & Elevation	
5	Framing Plan	
6	Typical Sections	
7	Slab Reinforcement	
8	Railing and Framing Details	
9	Abutment 1	
10	Abutment 2	
11	Reinforcing Schedule	
12-15	Cross Sections	
16	Std Sht C-1	3-10-65
17	Std Sht C-2b	3-10-65
18	Std Sht D-8	3-10-65
19	Std Sht D-11	3-10-65
20	Std Sht E-2	3-10-65
21	Std Sht E-3b	1-4-67
22	Std Sht G-1	2-9-68R
23	Std Sht SCB-D6-67	① 1-24-68
24	Std Sht SCB-D8-67	① 1-24-68
25	Std Sht SCB-D9-67	① 1-24-68
26-27	Std Sht SB-R1-64	Sheet 1 and 2 ① 1-3-68R
28	Std Sht SCB-D1-67	1-24-68
29	Std Sht SCB-D2-67	① 1-24-68

PROJECT NAME & NUMBER	NEWBURY BB 026-2-6673
RECORD PLANS	A.A. PIGHE
RESIDENT ENGR.	D.F. BRODIE
MATERIALS	Concrete: C.L. & B. Miller, Wash. Vt., Bradford, Vt. Reinforcing Steel: K. Ross, Bldg. Ctr., Lebanon, N.H. Structural Steel: W. Structural Steel Co., Burlington, Vt.

STATE OF VERMONT
DEPARTMENT OF HIGHWAYS


PROPOSED IMPROVEMENT
BRIDGE PROJECT
TOWN OF NEWBURY
COUNTY OF ORANGE Pin# 99R568
US RTE. 302

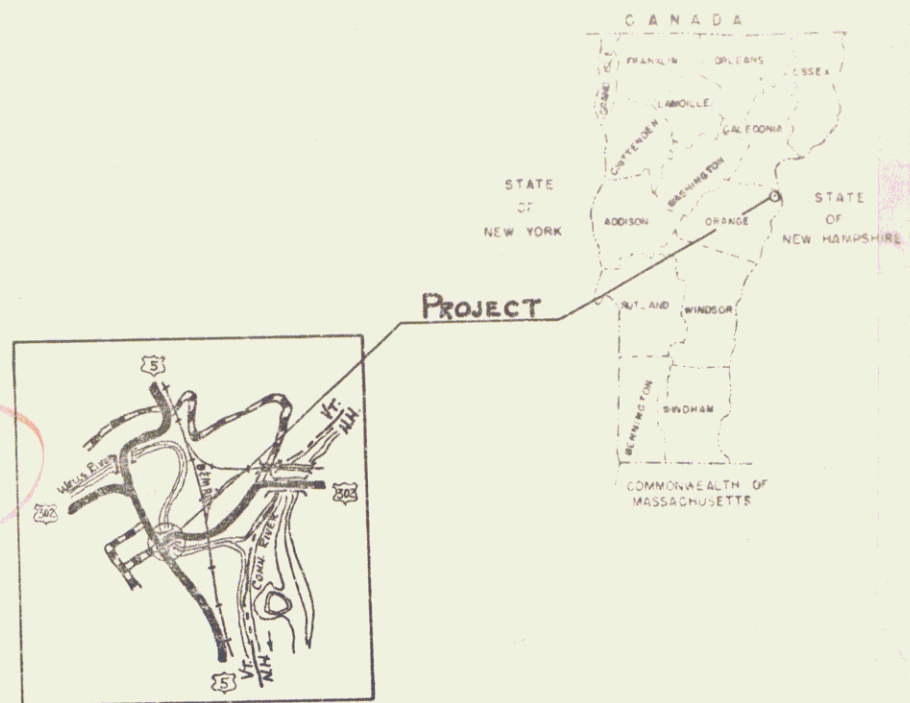

BEGINNING AT A POINT 0.037 MILES EAST OF THE INTERSECTION OF US ROUTE 302 AND U.S. ROUTE 5 EXTENDING WESTERLY 0.023 MILES ALONG US ROUTE 302 IN THE TOWN OF NEWBURY.

LENGTH ROADWAY = 60.63 FT. = 0.011 MI.
LENGTH BRIDGE = 64.37 FT. = 0.012 MI.
LENGTH PROJECT = 125.00 FT. = 0.023 MI.

NEWBURY BB 026-2-6673
BRIDGE REPAIR & WIDENING
Contractor: Fincel, Engineering & Bridge Const. Co., Inc., Brattleboro, Vt.
Location: Beginning at a point 0.037 mi. East of the intersection of U.S. Route 302 & U.S. Route 5, Extending Westwly 0.023 mi. along U.S. Route 302, in the Town of Newbury.

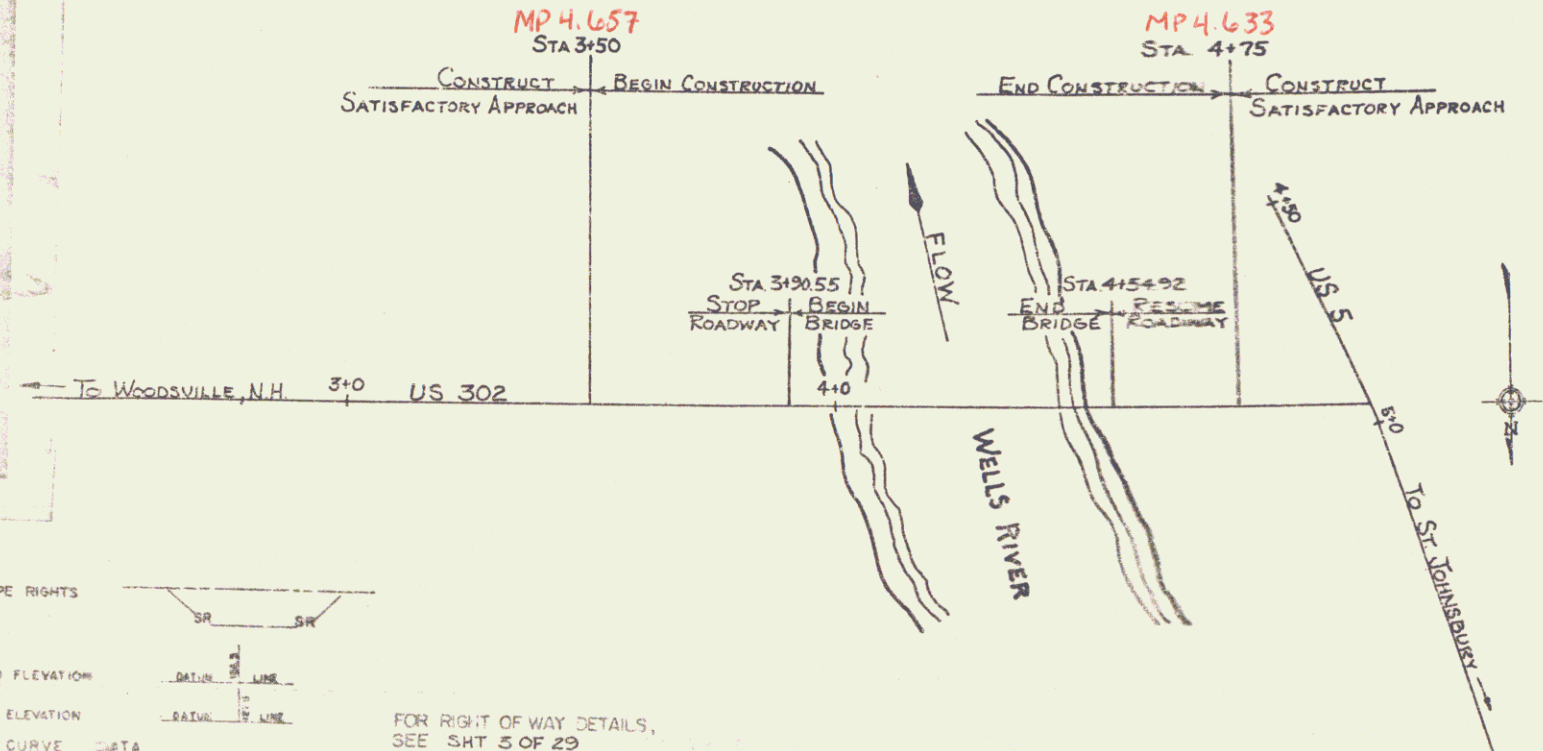

CONVENTIONAL SIGNS

POINT OF ACCESS	X
LIMITS OF ACCESS	—
COUNTY LINE	—
TOWN LINE	—
FENCE LINE	—
STONE WALL	—
UNFENCED PROPERTY	—
GRAND FILL	—
TRAVELED WAY	—
RAILROAD	—
RETAINING WALL	—
UTILITY LINE	—
CURVET LINE	—
GRAVEL	—
DRIP WELLS	—
TROTTER PILE	—
WINDY HOLE	—
TELEPHONE POLE	—
POST	—
NOTE	—

FOR RIGHT OF WAY DETAILS, SEE SHT 5 OF 29

SLOPE RIGHTS	SR
GROUND ELEVATION	—
GRADE ELEVATION	—
CURVE DATA	—
DEFLECTION OF ANGLE	A
DEGREE OF CURVE	D
RADIUS OF CURVE	R
TANGENT DISTANCE	T
LENGTH OF CURVE	L
EXTERNAL DISTANCE	E
POINT OF INTERSECTION	PI
POINT OF CURVE	PC
POINT OF TANGENT	PT
POINT ON TANGENT	PO
POINT ON SUBTANGENT	POST

RIGHT-OF-WAY DIVISION
TOWN FILE
PERPETUAL
of US 302
(To Be Returned To R.O.W. Division)

M.P. 4.65 1/11/69

THESE PLANS ARE SUBJECT TO SUCH REVISIONS AS MAY BE REQUIRED BY THE COMMISSIONER OF HIGHWAYS.
CONSTRUCTION IS TO BE CARRIED ON IN ACCORDANCE WITH THESE PLANS AND THE STANDARD SPECIFICATIONS FOR HIGHWAY AND BRIDGE CONSTRUCTION DATED APRIL 1958, AS APPROVED BY THE BUREAU OF PUBLIC ROADS ON OCTOBER 12, 1958, INCLUDING ALL SUBSEQUENT APPROVED REVISIONS AND SUCH REVISED SPECIFICATIONS AND SPECIAL PROVISIONS AS ARE INCORPORATED IN THESE PLANS.

APPROVED	APPROVED	APPROVED	APPROVED	APPROVED
DATE	DATE	DATE	DATE	DATE

APPROVED
DIVISION ENGINEER
BB 026-2-6673
① of 29