
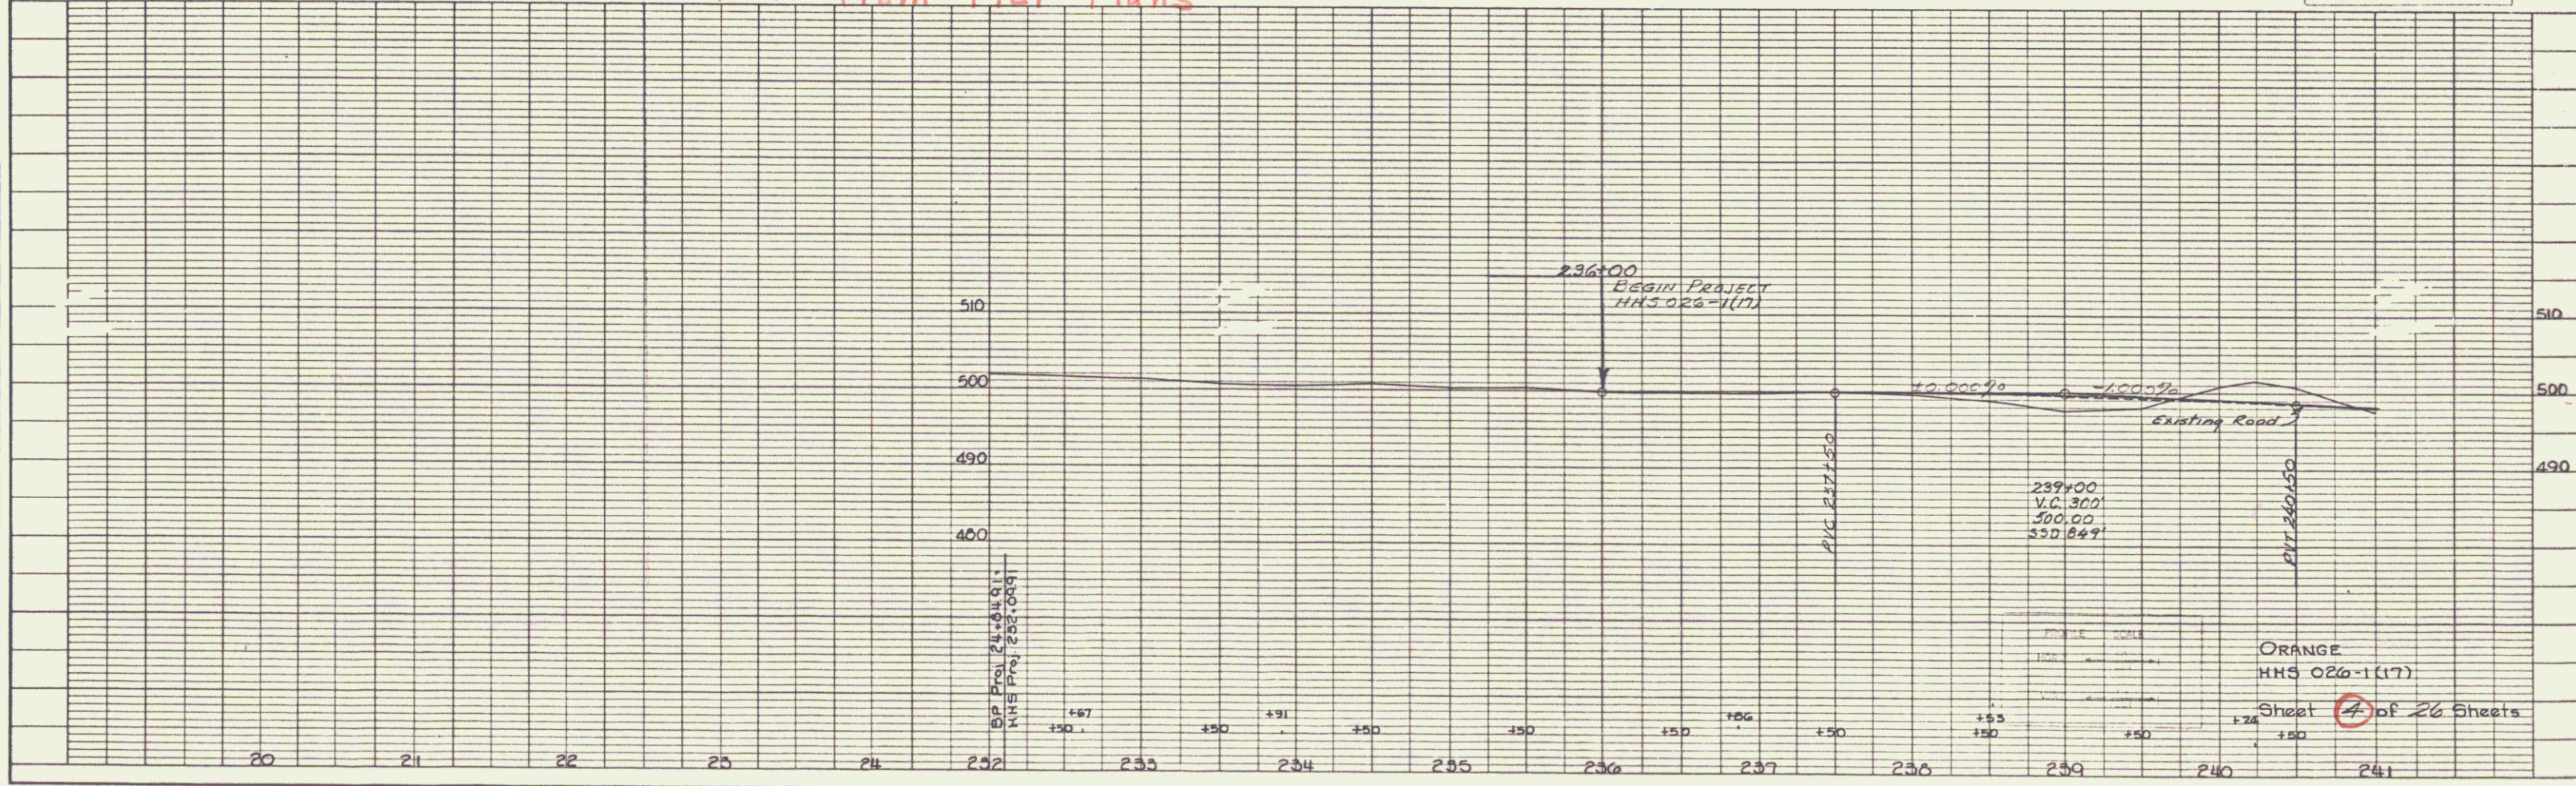


PLAN	SUBMITTED	BY	DATE
	APPROVED		
	CHECKED		
	BY		
	NO.		

PROFILE	SUBMITTED	BY	DATE
	APPROVED		
	CHECKED		
	BY		
	NO.		

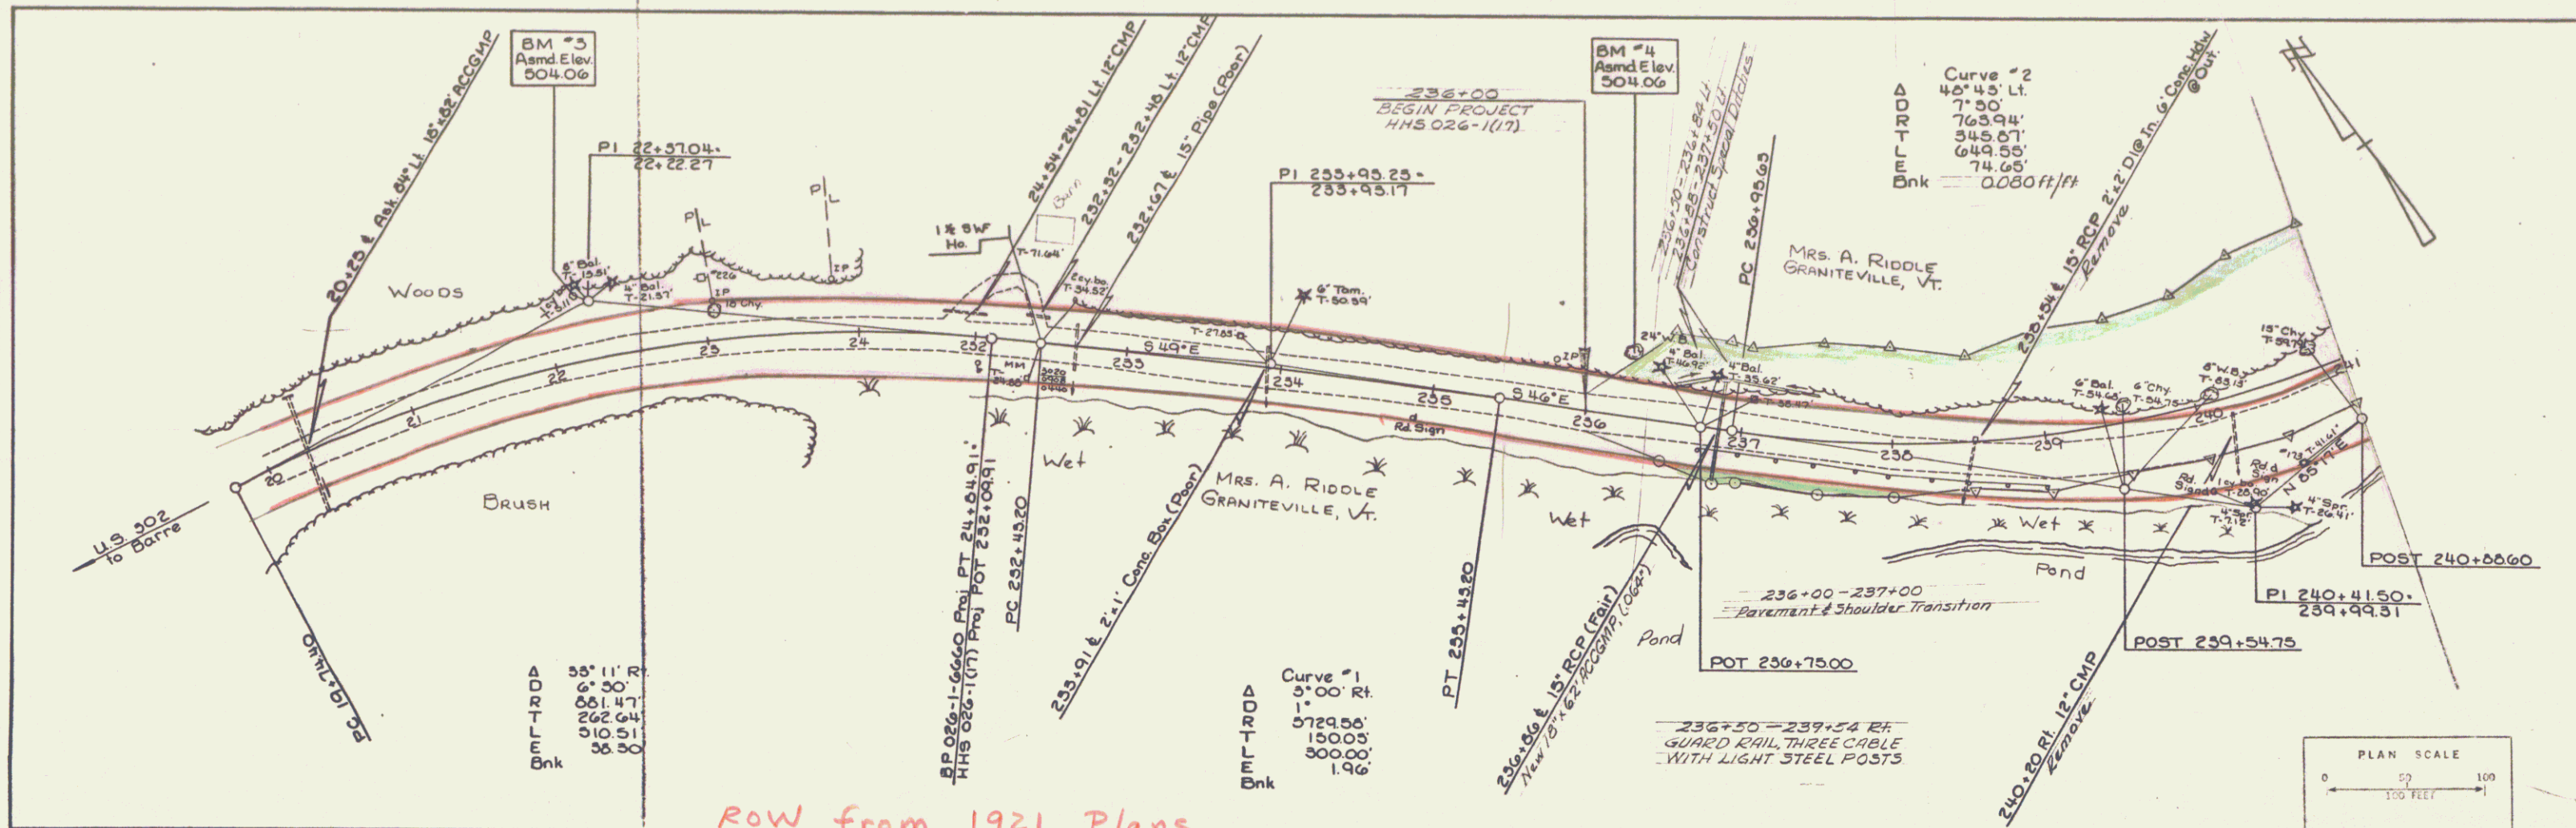

K&E PLATE 1, PLAN-PROFILE
EDWARDS & KELCEY CO.