


PARCEL	INSTR.	DATE	GRANTOR	GRANTEE	RECORDED	BOOK	PAGE	DATE	REMARKS
2	G.C.D.	12-13-55	ROLAND G. WOOD	ST. OF VI.	BRIDPORT	21	295	2-3-56	
3A	A.D.O.E.	10-19-55	ASHLEY C. & DOROTHY A. WOLCOTT	ST. OF VI.	BRIDPORT	21	297-8	2-3-56	SEE ALSO 56100-63-50 E, 62-74.4-72+75.7 R, 124+00-129+60.5 R.

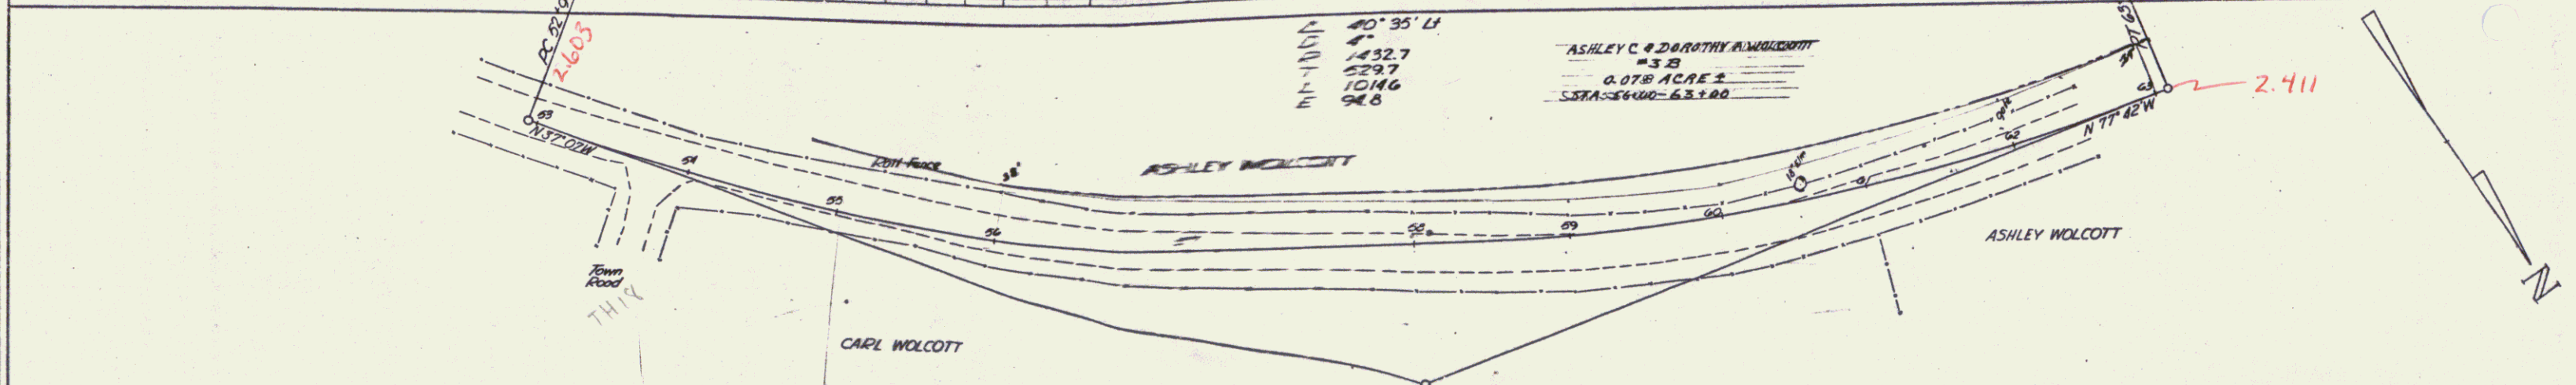

DATE  
BY  
CHECKED  
BY  
PLANNING  
ENGINEER  
REGISTERED  
PROFESSIONAL  
ENGINEER  
STATE OF  
CONNECTICUT

DATE  
BY  
CHECKED  
BY  
PLANNING  
ENGINEER  
REGISTERED  
PROFESSIONAL  
ENGINEER  
STATE OF  
CONNECTICUT

BRIDPORT - ADDISON  
ST. 69(1)  
SHEET 2

SCALE: 1" = 40' HORIZ. 1" = 10' VERT.  
P.L. & E. CO., NEW HAVEN, CT.