

PLAN  
 DATE: 7-23  
 DRAWN BY: [Signature]  
 CHECKED BY: [Signature]  
 PROJECT: BRIDPORT-ADDISON  
 SHEET NO. 4

PROFILE  
 DATE: [Blank]  
 DRAWN BY: [Blank]  
 CHECKED BY: [Blank]  
 PROJECT: BRIDPORT-ADDISON  
 SHEET NO. 4

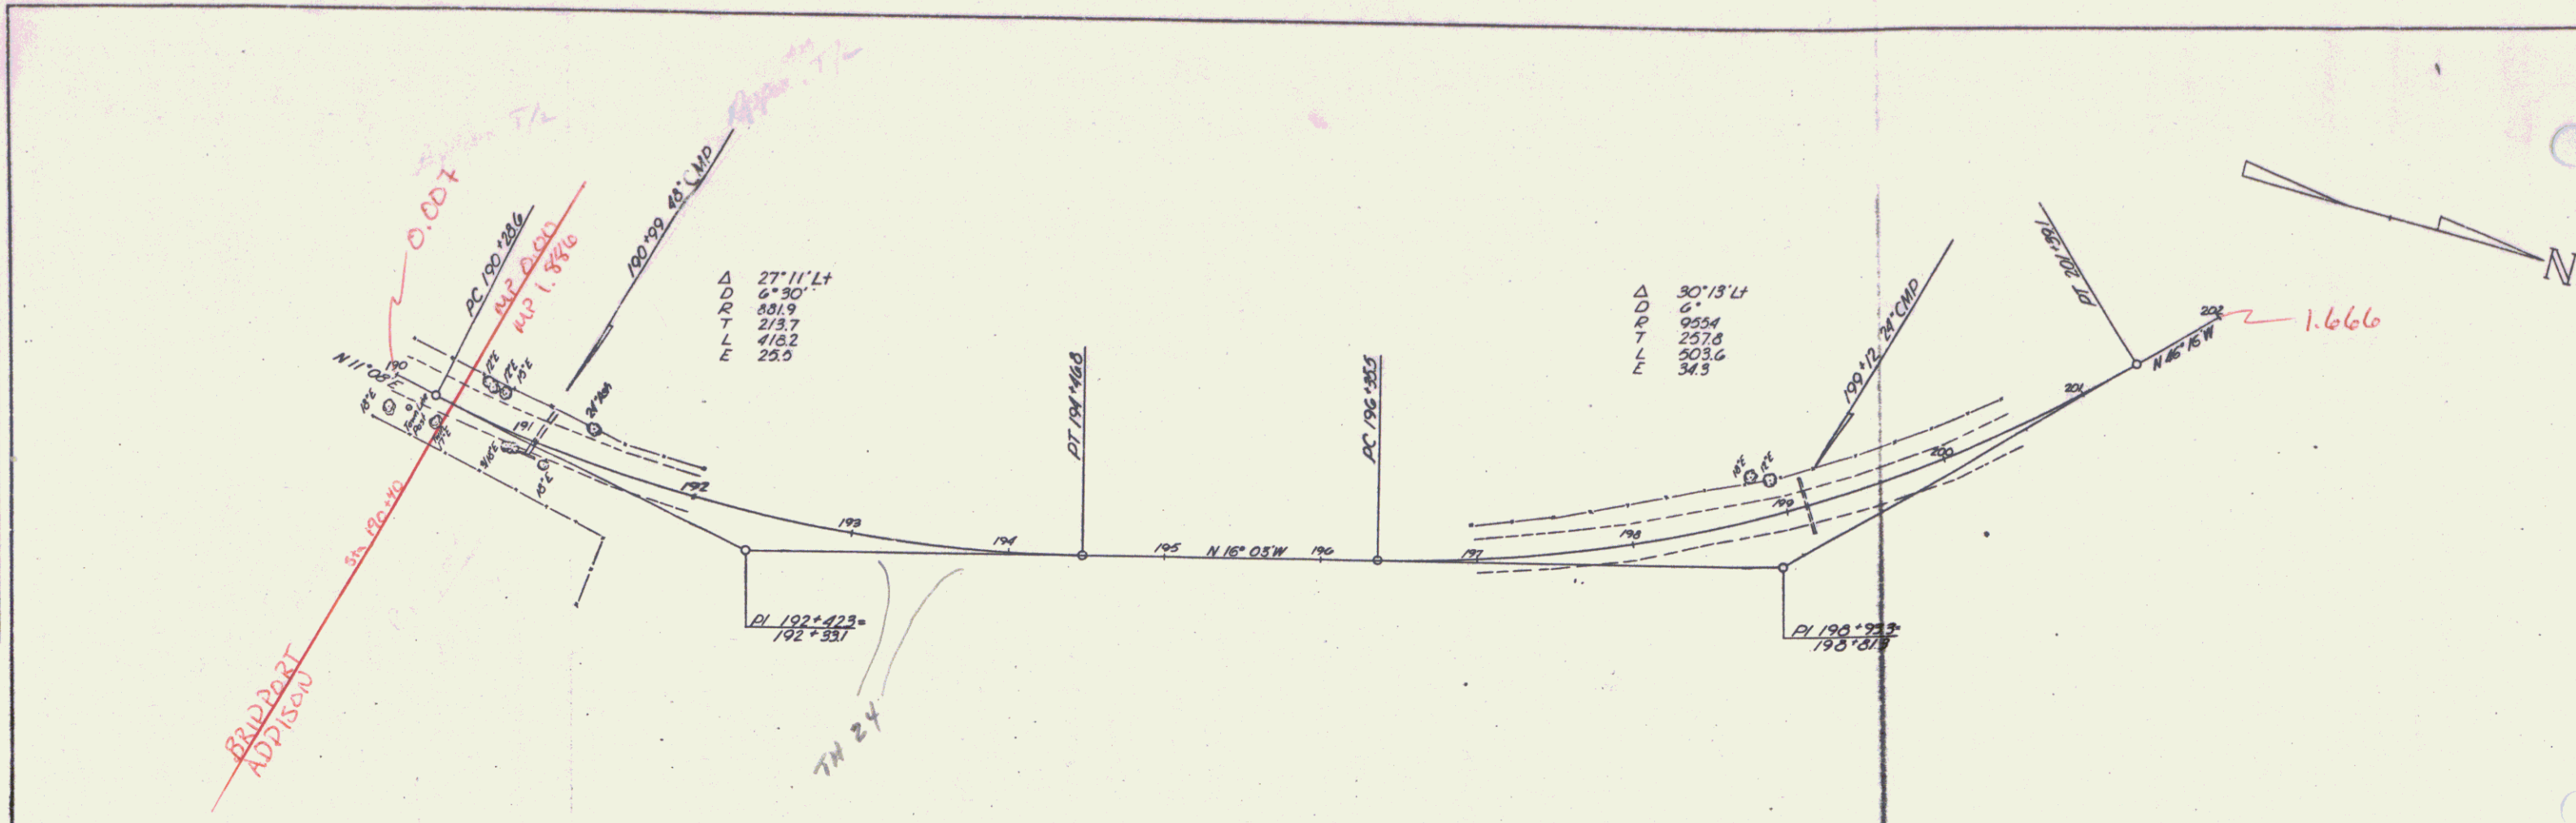


PLATE 1 - PLAN - PROFILE © P. E. & S. ENGINEERS  
 NEW YORK, N. Y.  
 1960

BRIDPORT-ADDISON  
 ST 696L  
 SHEET 4

4